

THE
LOYAL ORDER OF MOOSE

LODGE NO. 138

SANITARY SEWER

1958


EDIGER & COMPANY

Consulting Engineers & Architects

WICHITA, KANSAS

INDEX

- 1 SEWER DETAILS
- 2 PLAN & PROFILE
- 3 PLAN & PROFILE
- 4 PLAN & PROFILE

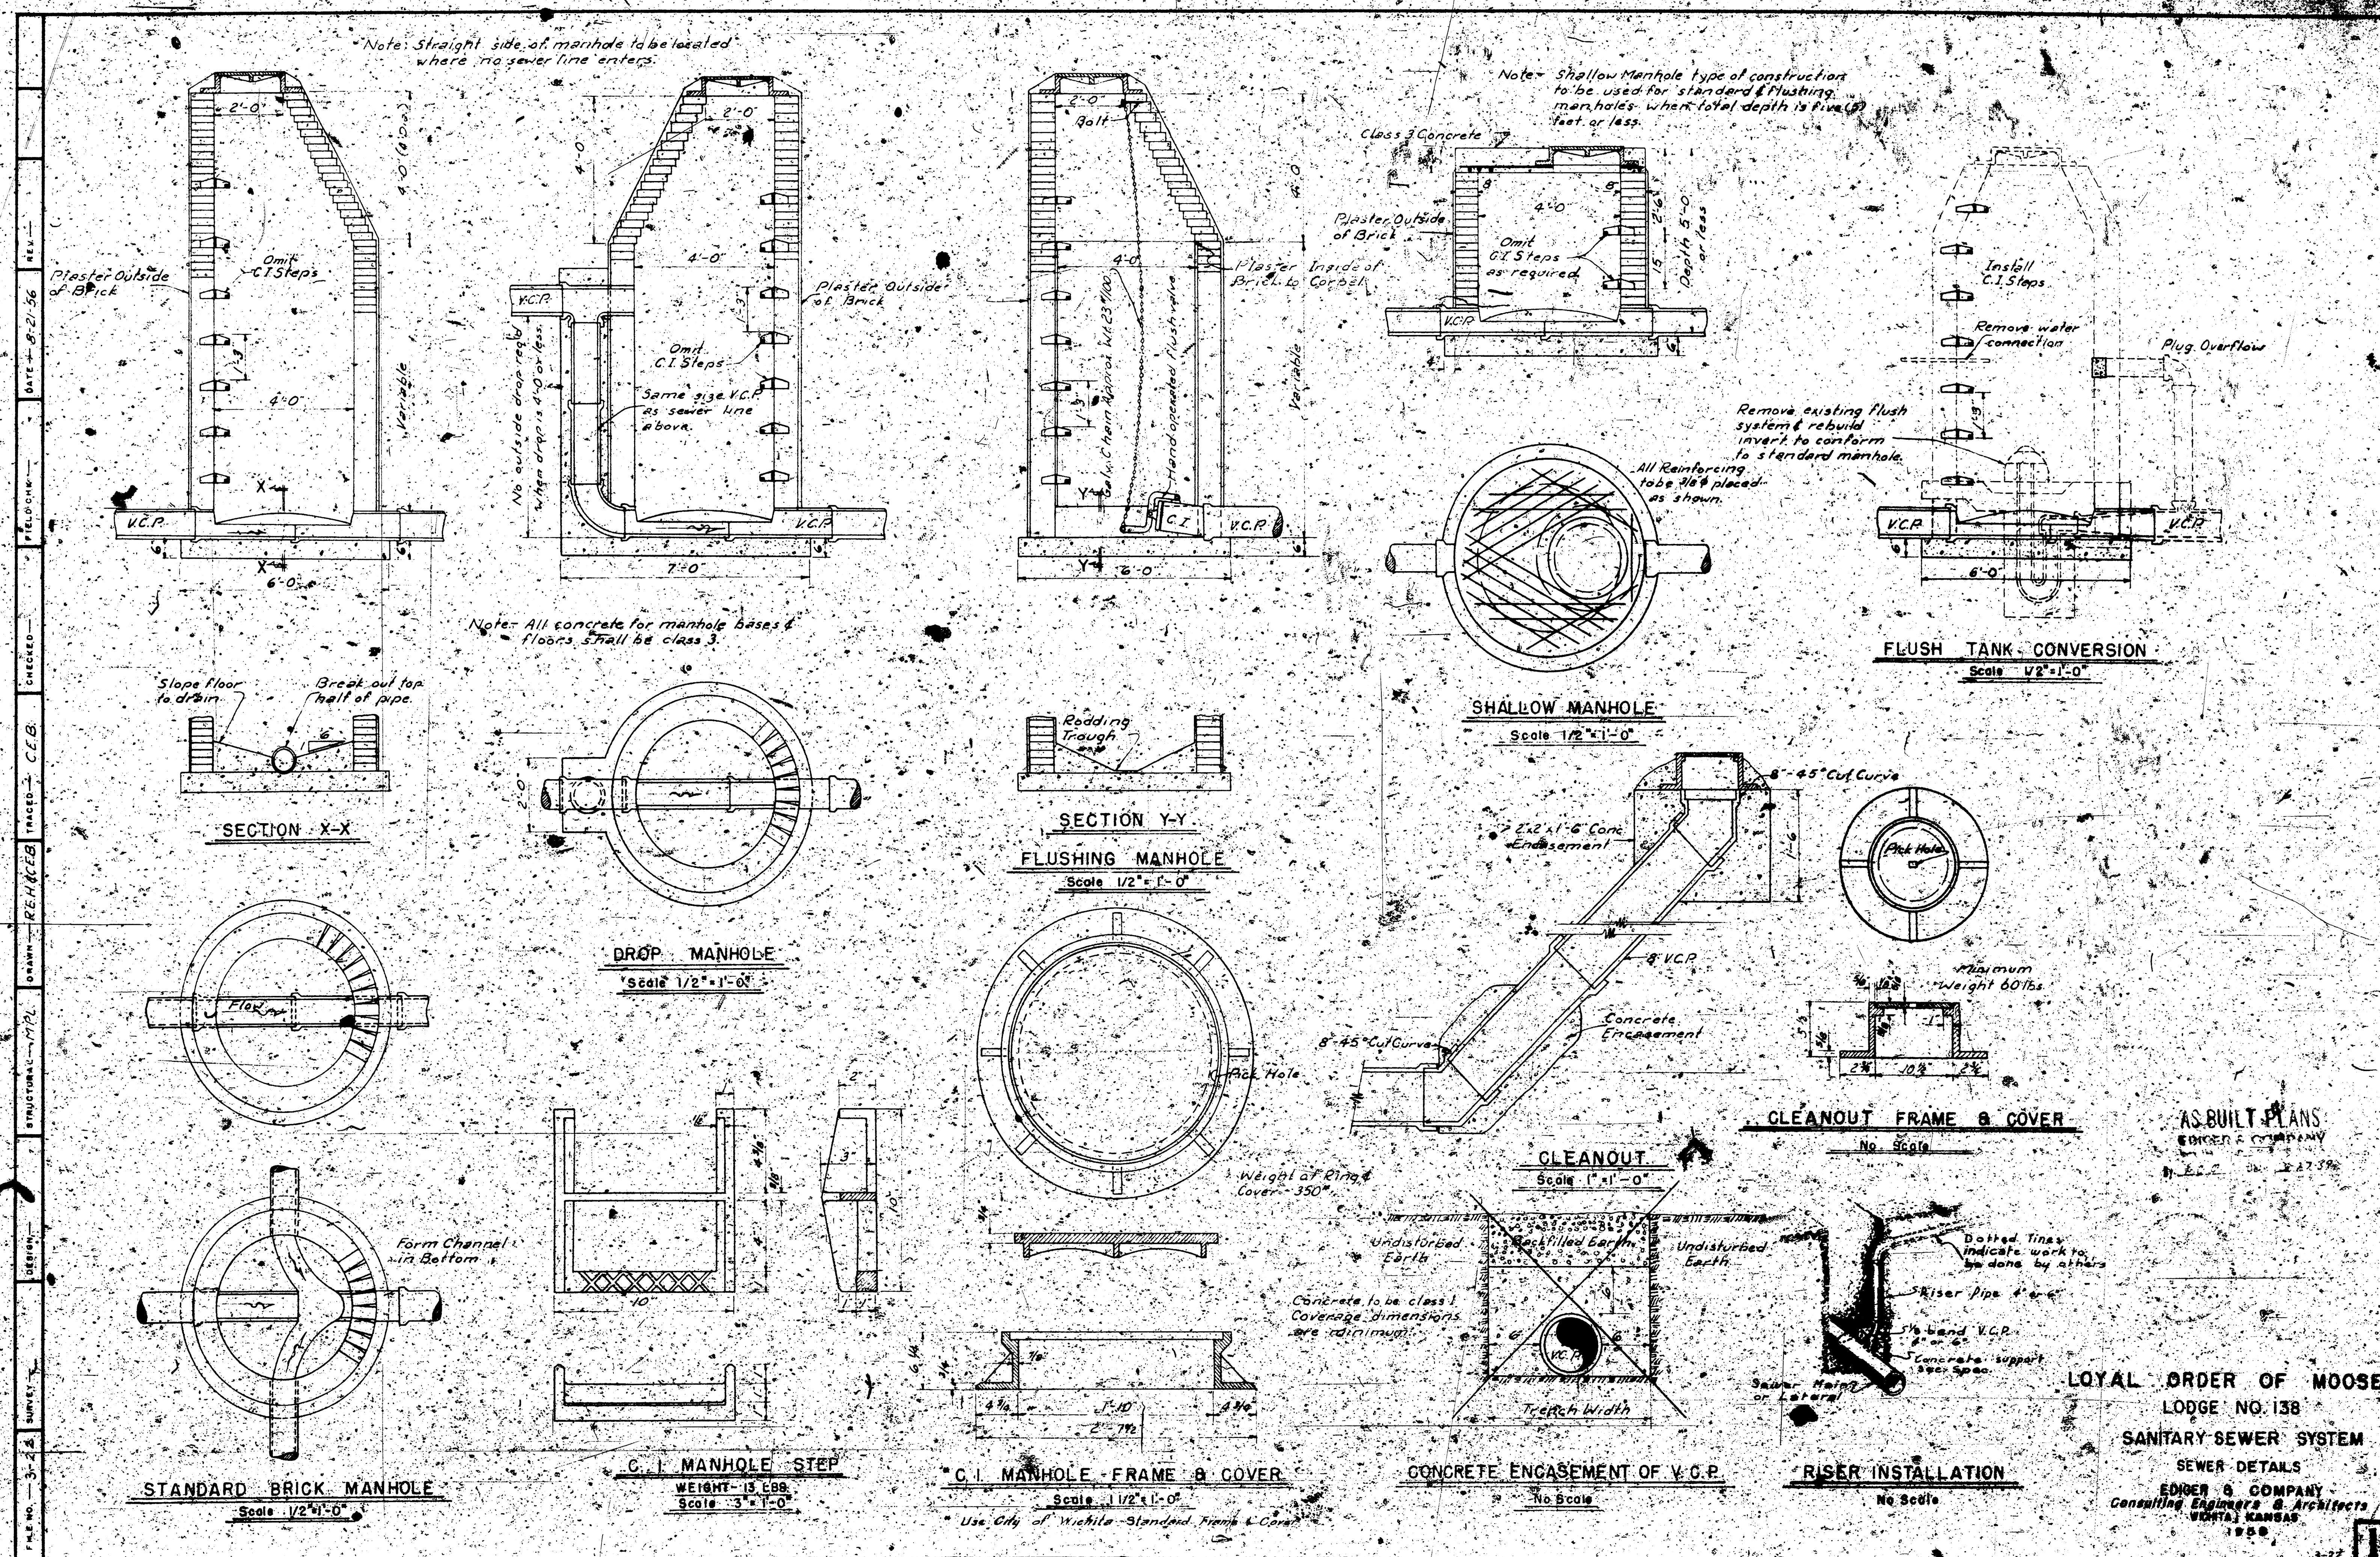




LOYAL ORDER OF MOOSE
SANITARY SEWER SYSTEM
PLAN & PROFILE
EDGES & COMPANY
Consulting Engineers & Architects
1958

PLAN
 NOTE BOOK
 NO.

PROFILE
 NOTE BOOK
 NO.

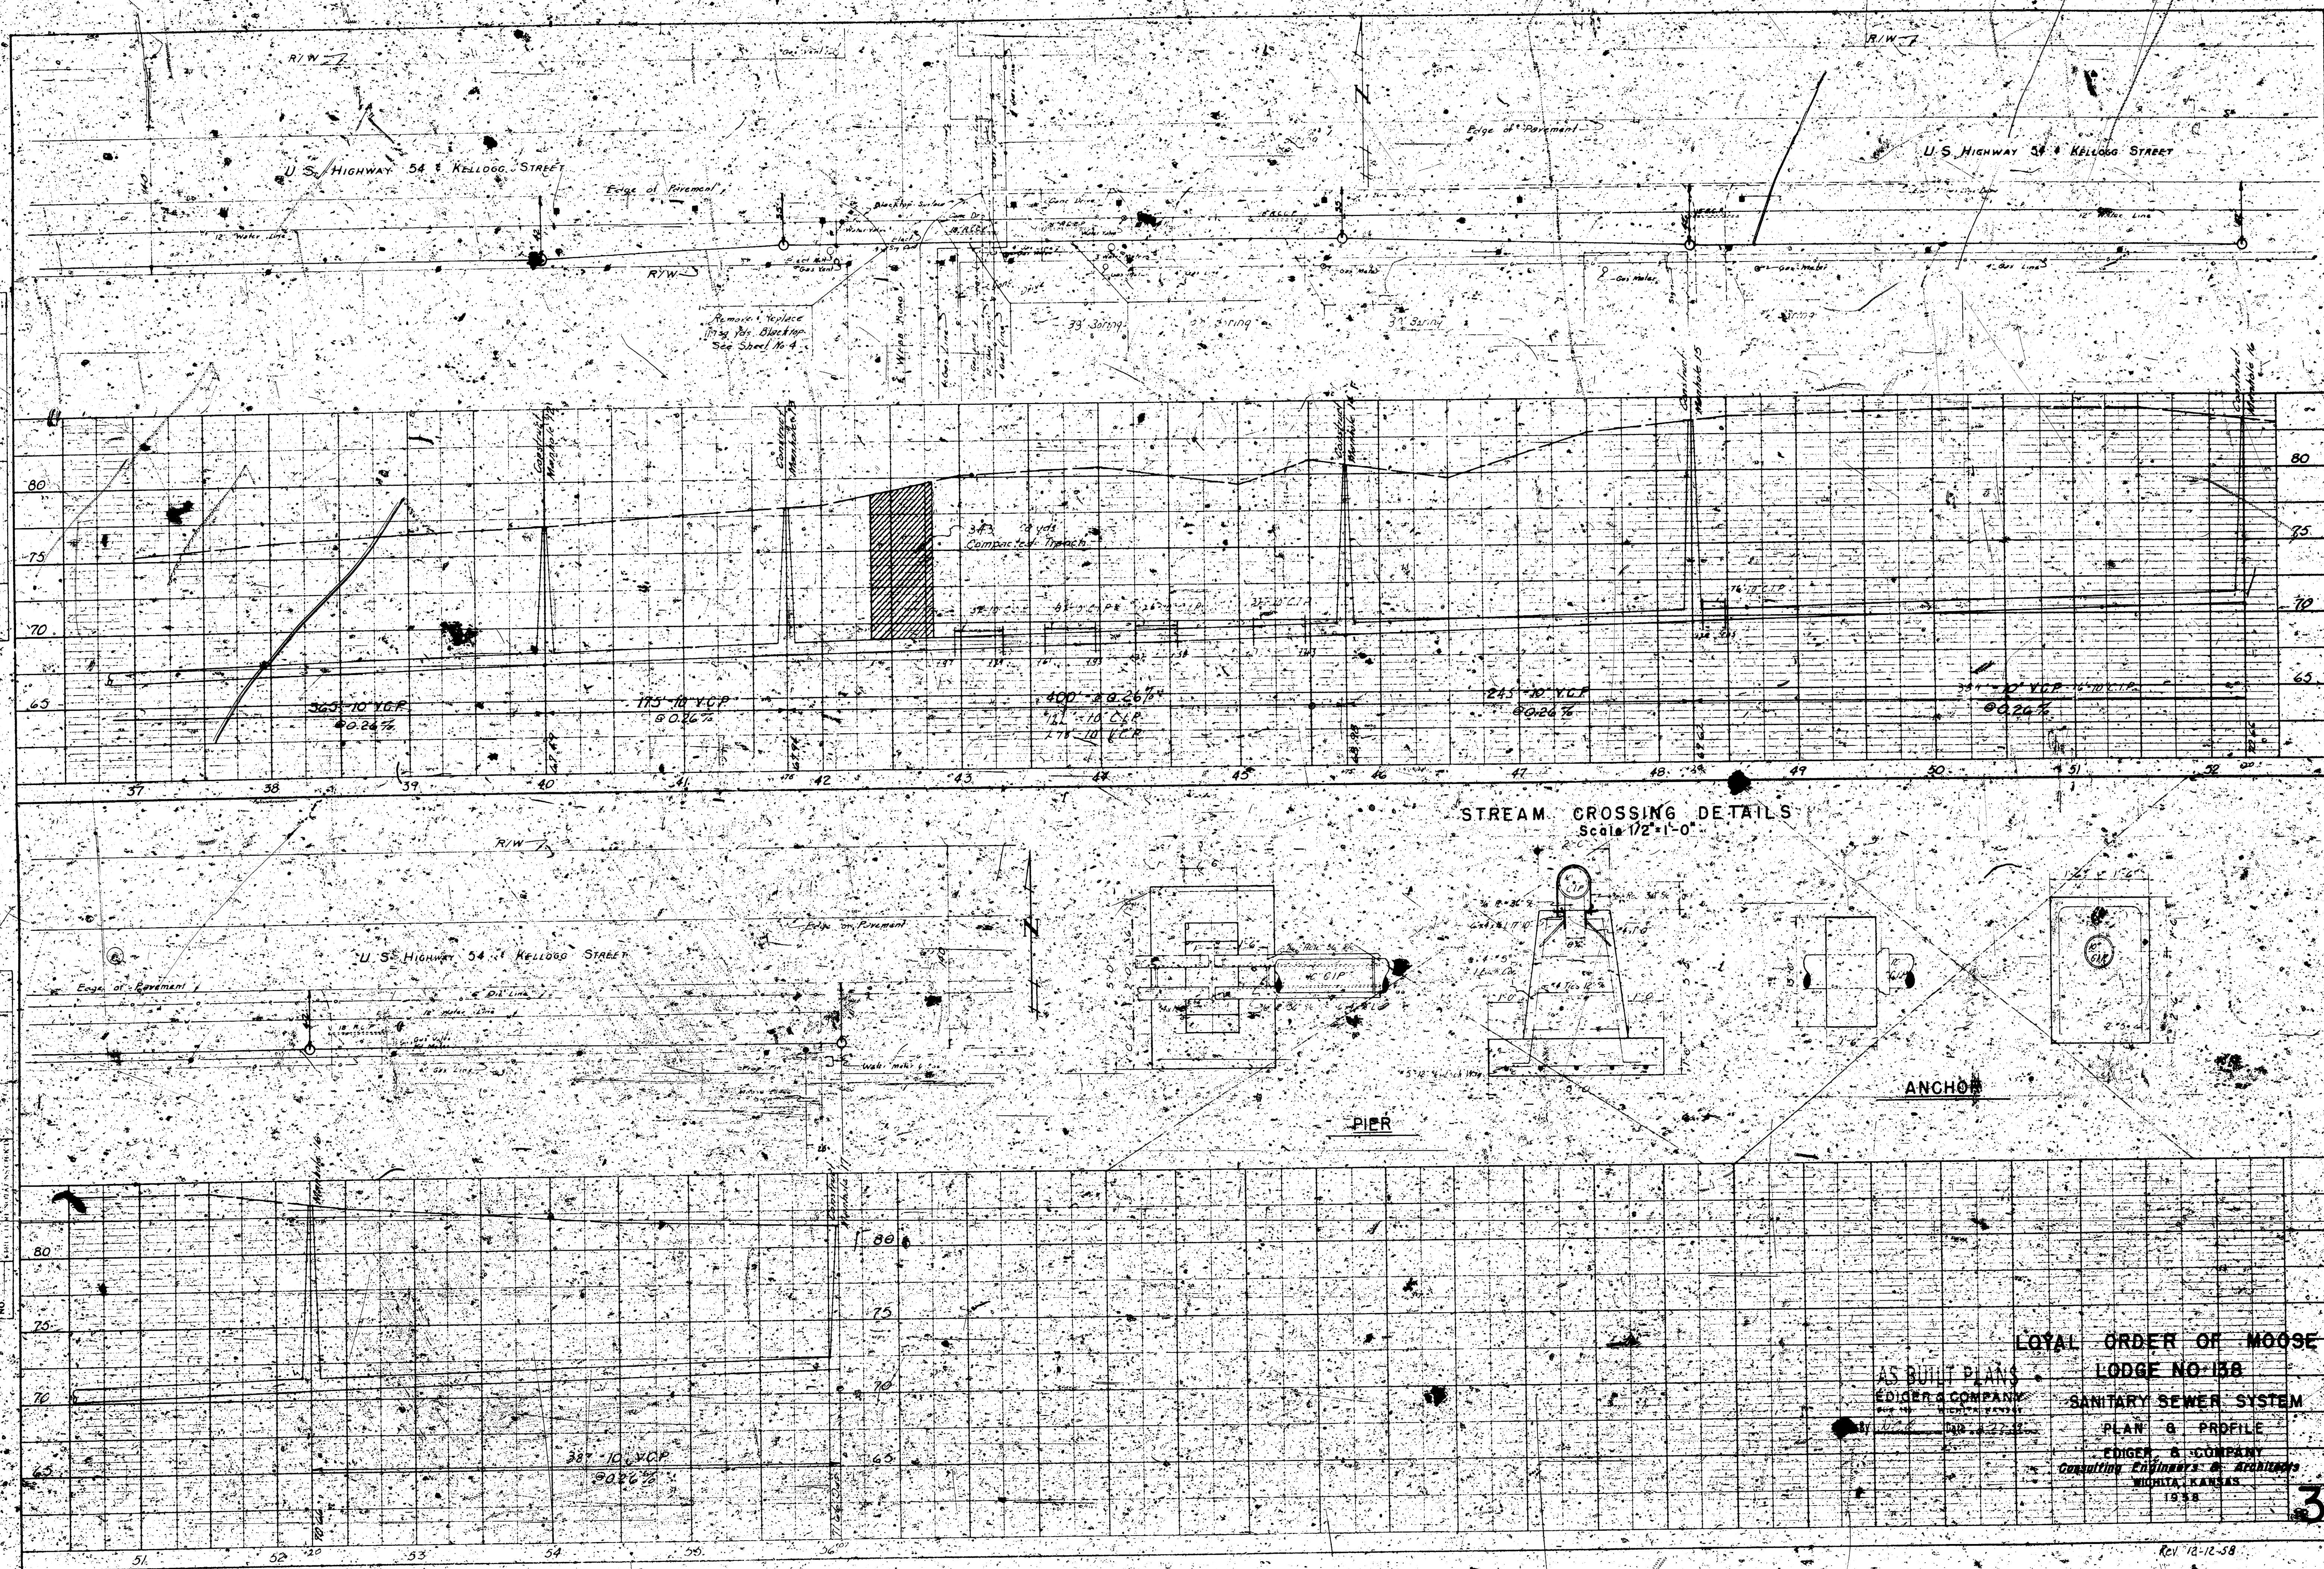

LOYAL ORDER OF MOOSE
 LODGE NO. 138
 SANITARY SEWER SYSTEM
 PLAN & PROFILE
 EDGER & COMPANY
 Consulting Engineers & Architects
 WICHITA, KANSAS
 1938

