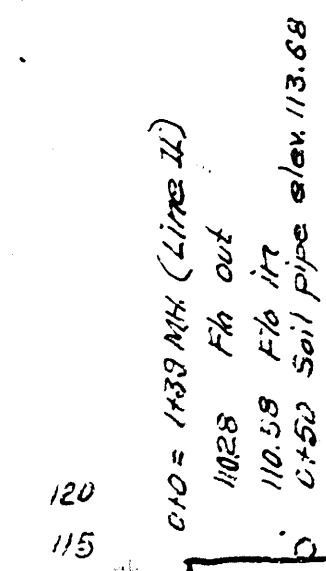
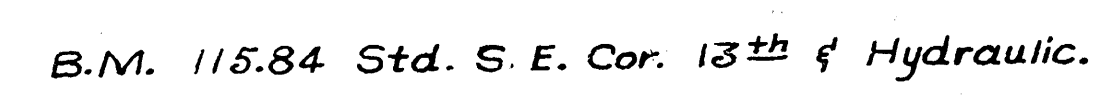


PRIVATE JOB  
MATELOCK INC.  
City of Wichita, Kansas  
L.K. WHITE City Engineer  
Date 10-26-49