



PLAN SCALE: 1" = 40'
PROFILE SCALE: 1" = 40' HOR.
1" = 4' VERT.

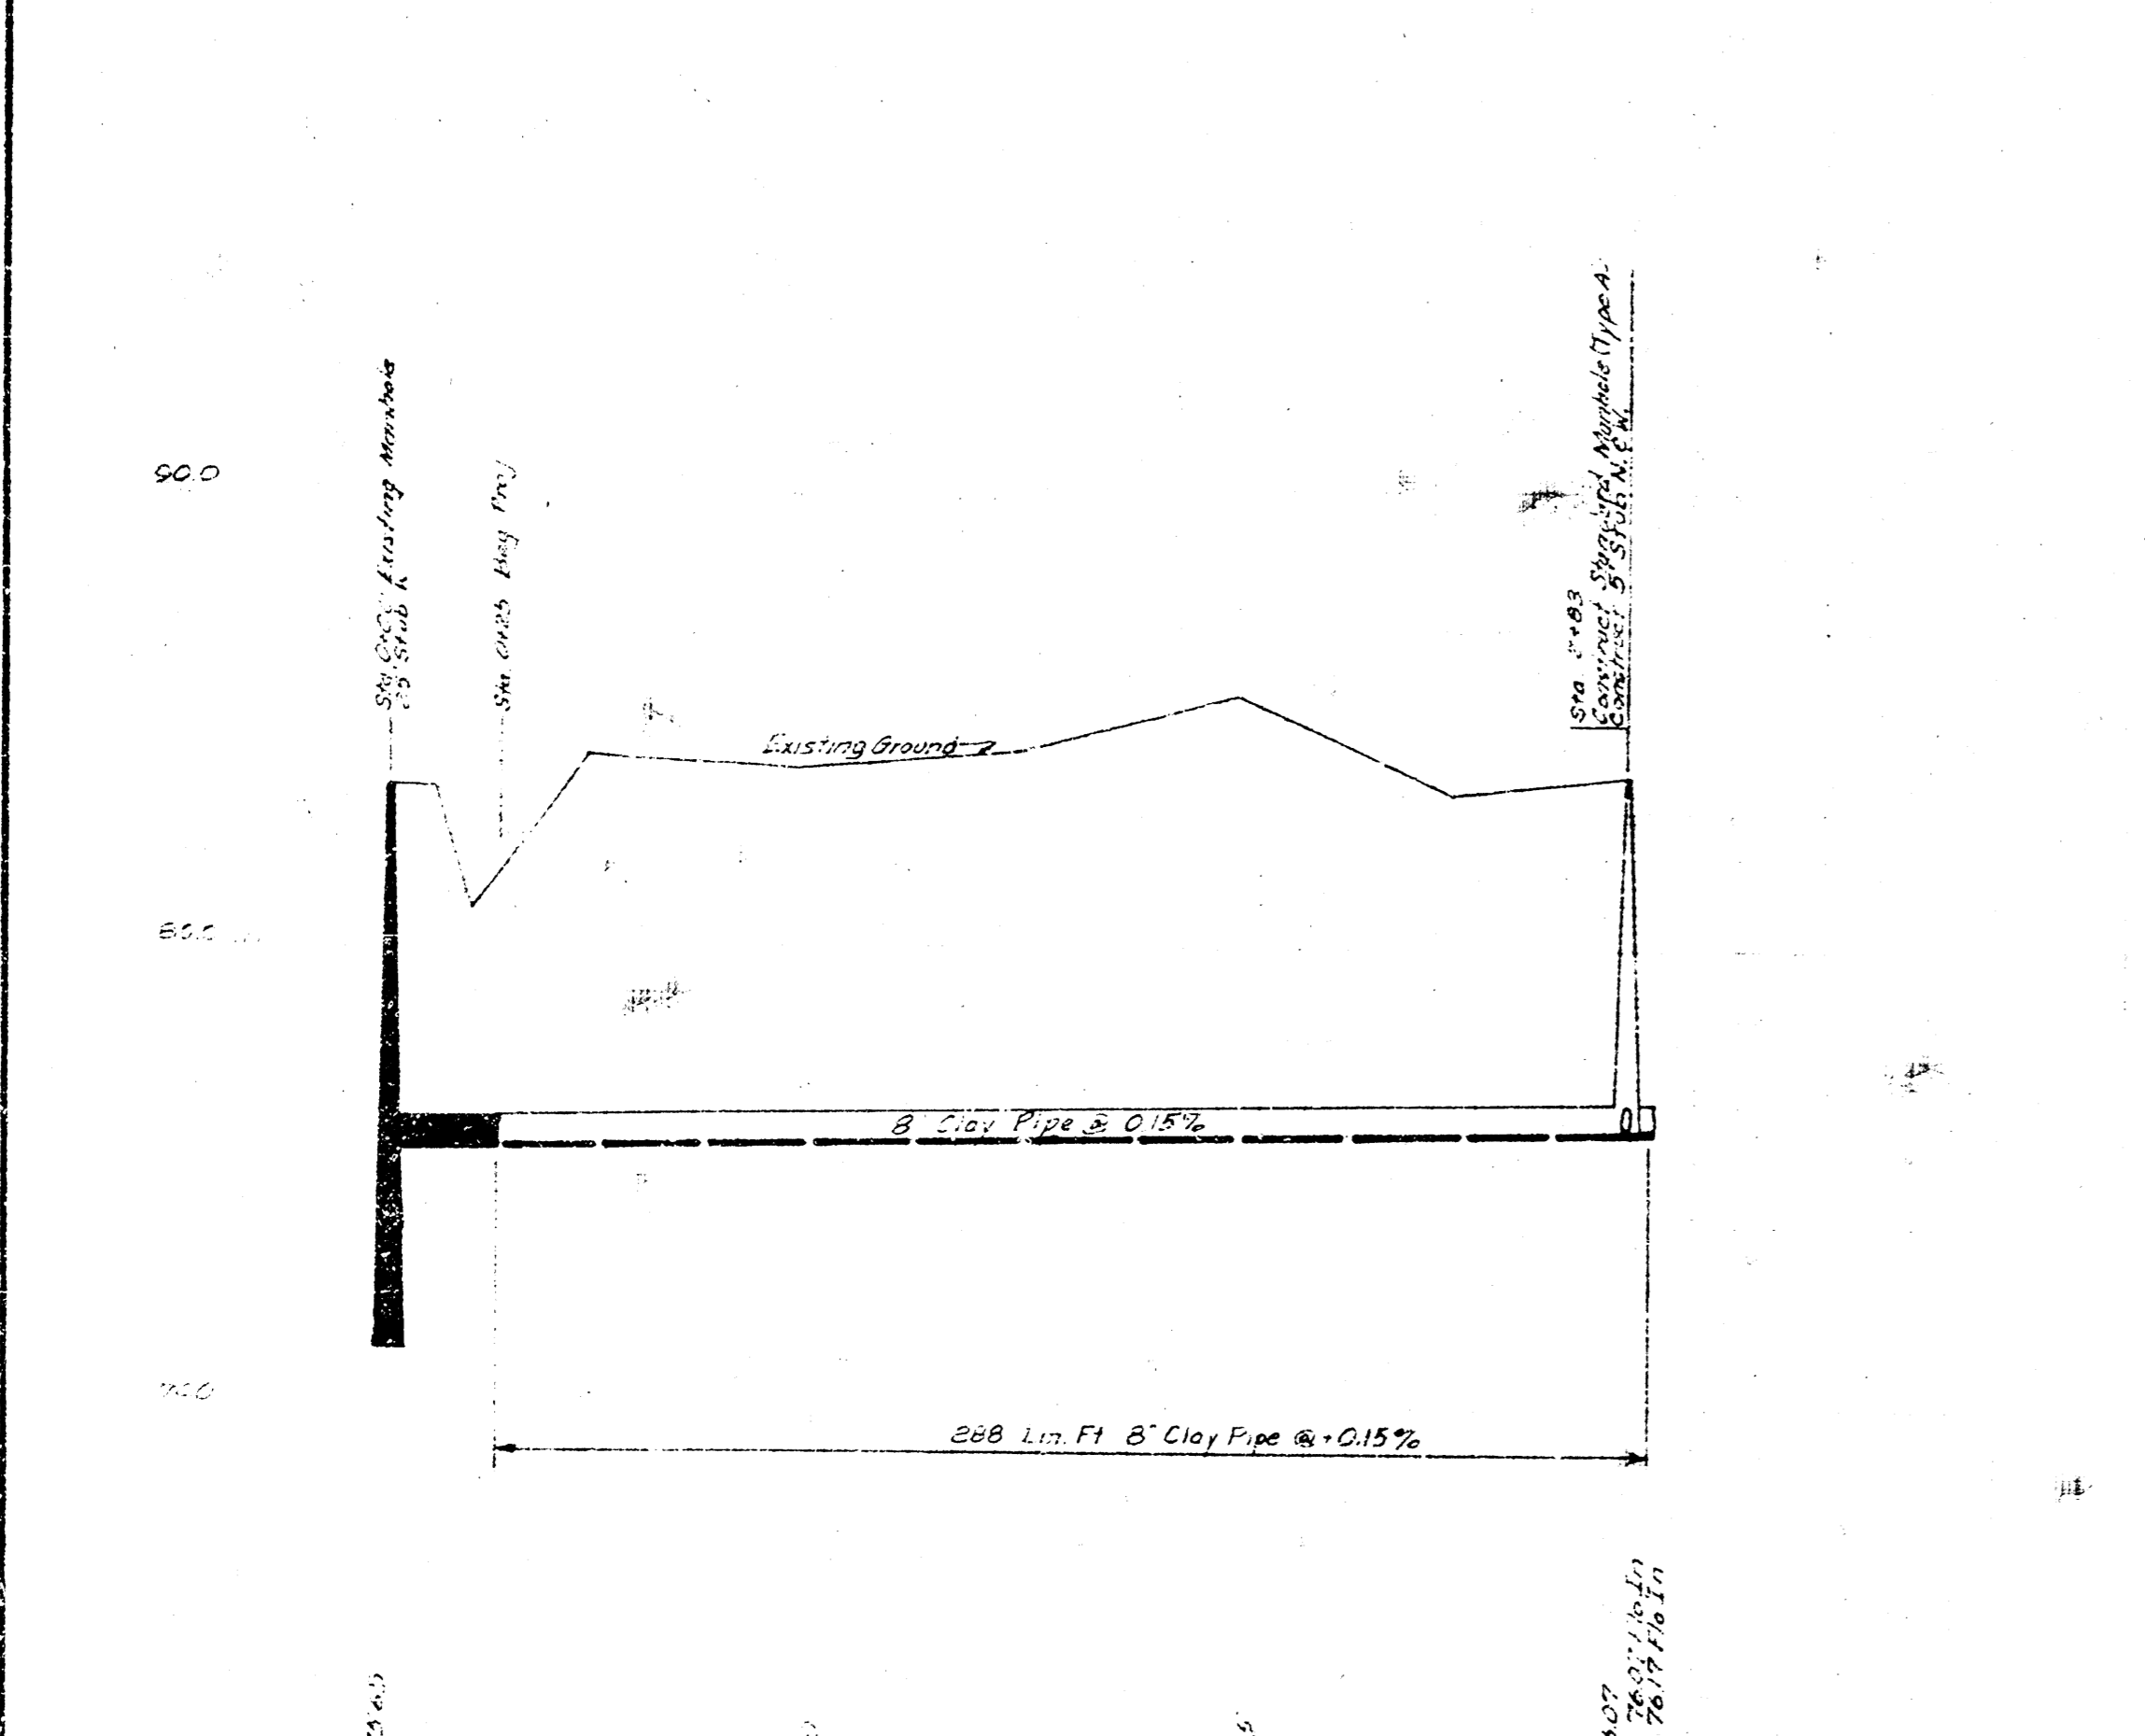

LAT. 4- SUB. 3 - S.W.I.
CITY OF WICHITA, KANSAS
R. W. LINN, CITY ENGINEER
PROJ. NO. DBKL 569018
DATE. MAY 1971

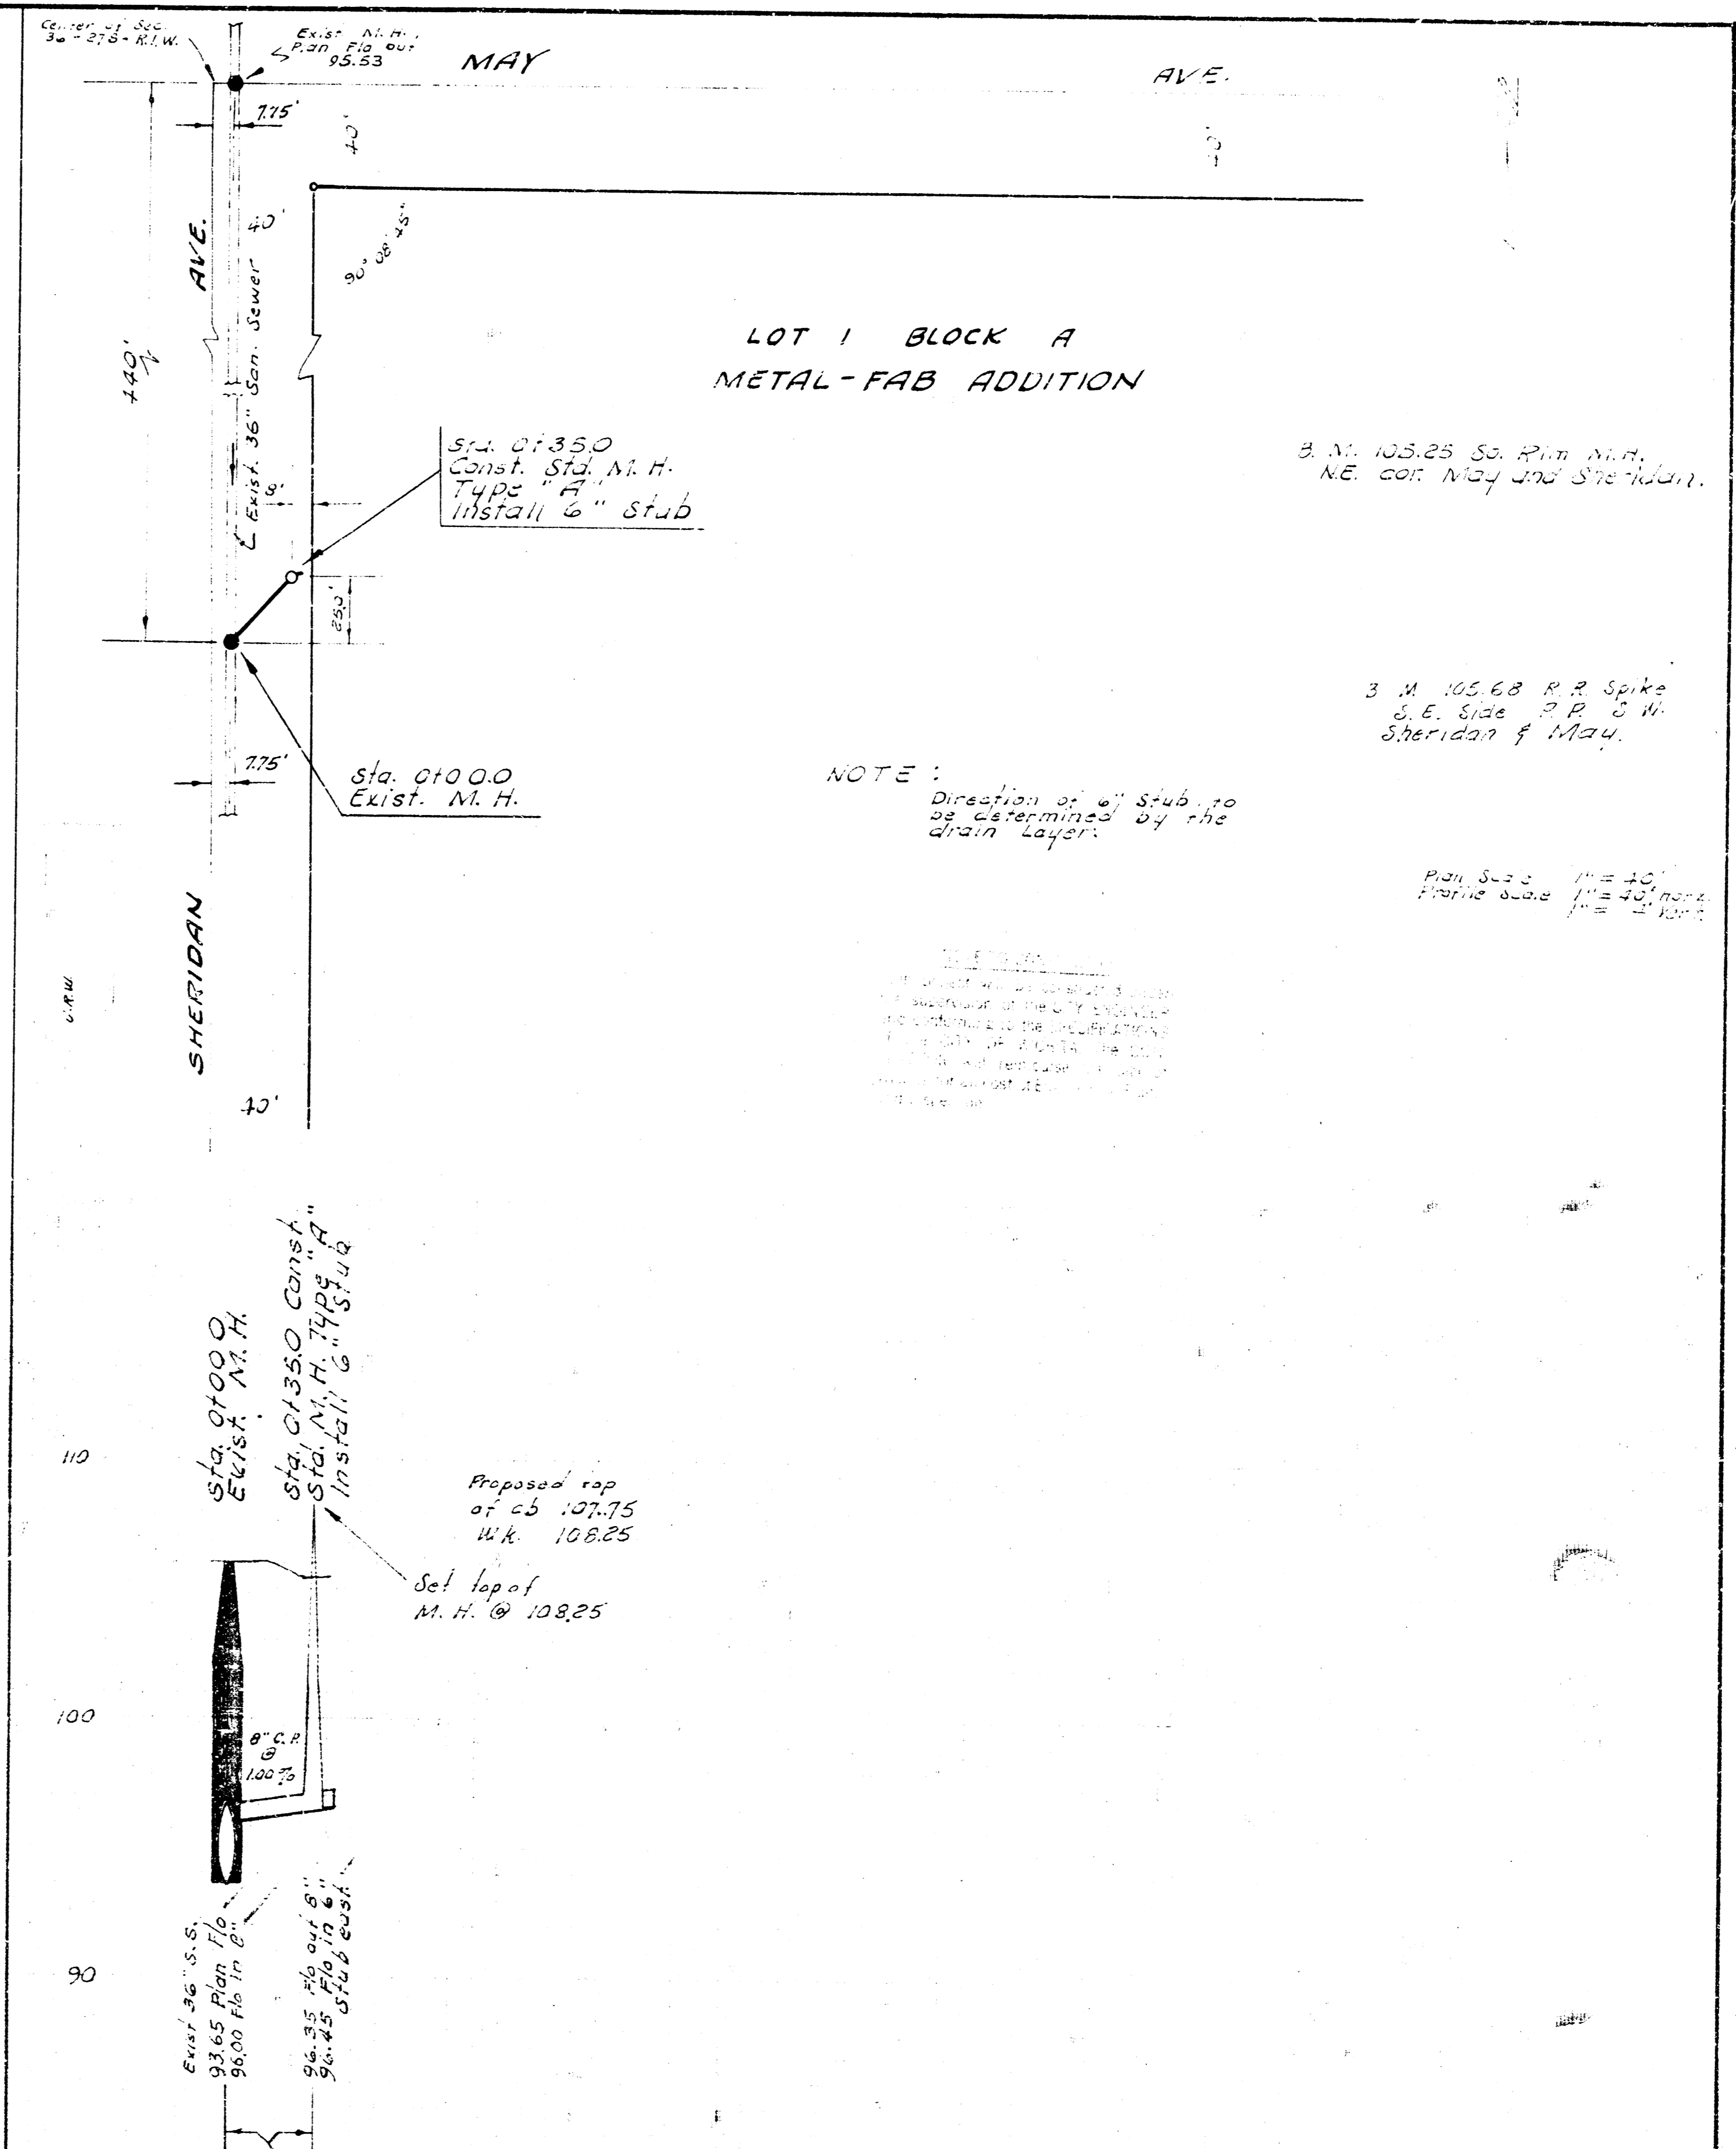

METAL-FAB ADDITION
SANITARY SEWER
SOUTHEAST MAY AVE & SHERIDAN AVE.
CITY OF WICHITA, KANSAS
R. W. LINN - CITY ENGINEER
JULY 1971 PRIVATE CONTRACT