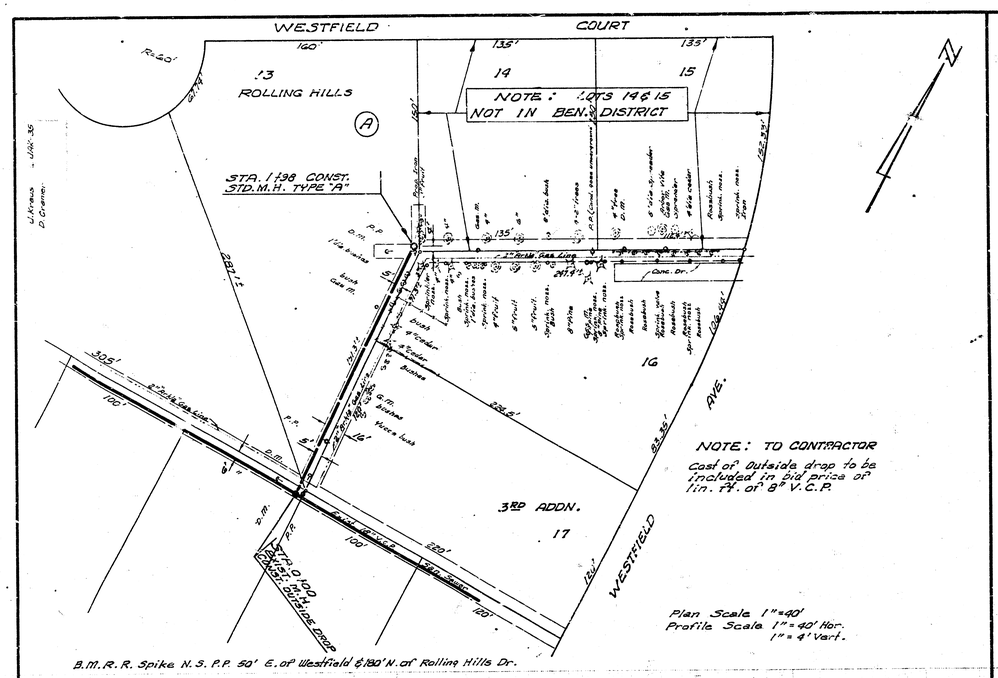

Plan Scale 1" = 40'
Profile Scale 1" = 40' Hor.
1" = 4' Vert.

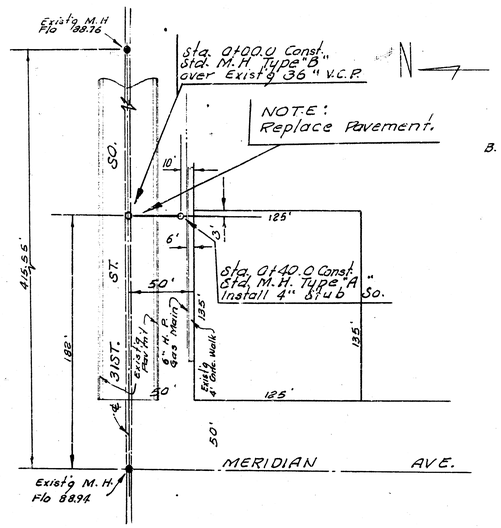

B. M. 97.605 U. S. G. S. Std.
B. M. S. W. Meridian & 31st St. So.

Scale
Profile 1" = 40' Horz.
1" = 4' Vert.

NOTE TO CONTRACTOR

This project will be constructed under the supervision of the CITY ENGINEER and conforming to the SPECIFICATIONS of the CITY OF WICHITA. The CONTRACTOR will reimburse the City of Wichita for all cost of Engineering Plans.

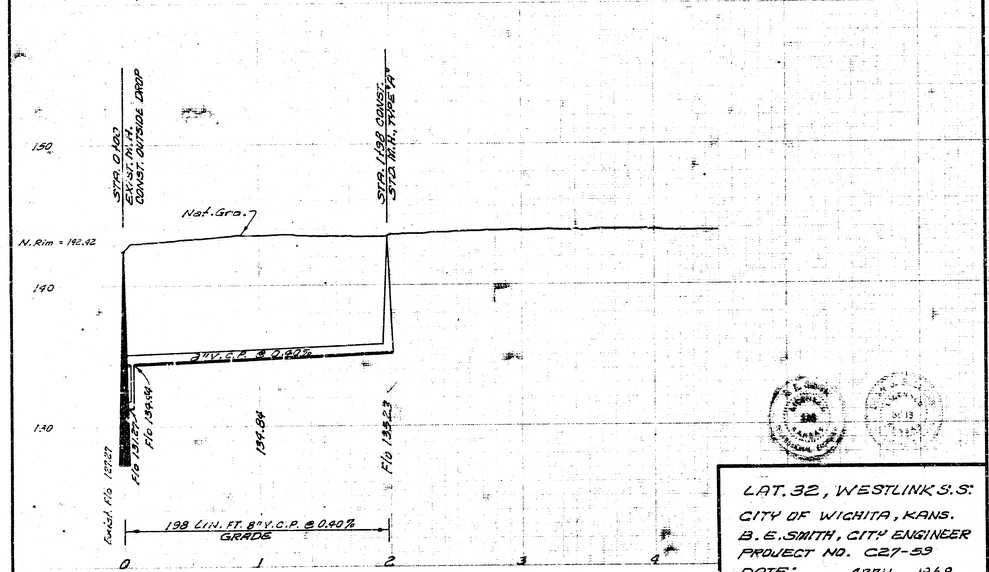

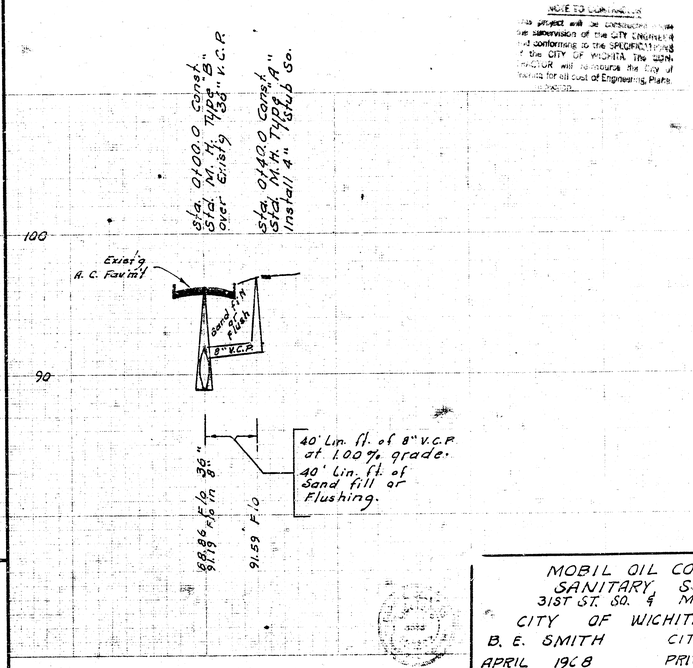

LAT. 32, WESTLINK S.S.
CITY OF WICHITA, KANS.
B. E. SMITH, CITY ENGINEER
PROJECT NO. C27-59
DATE: APRIL 1968

MOBIL OIL COMPANY
SANITARY SEWER
31ST ST. SO. & MERIDIAN
CITY OF WICHITA KANSAS
B. E. SMITH CITY ENGINEER
APRIL 1968 PRIVATE CONTRACT

2 Engr.
1 - Mobil