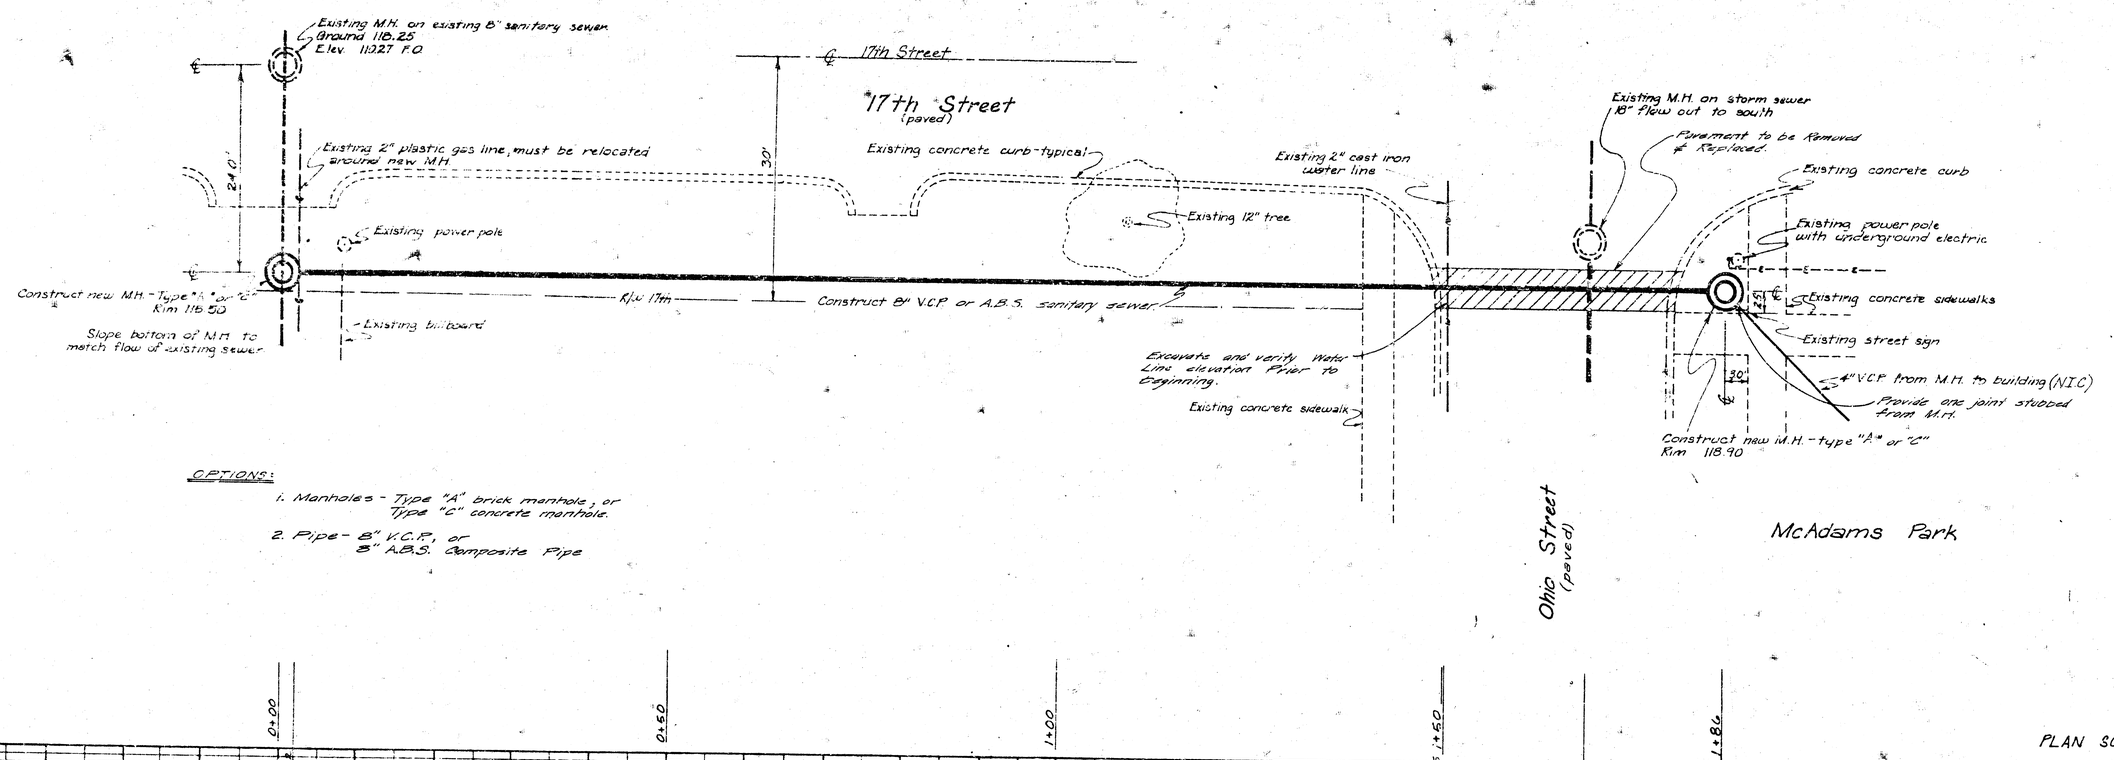

8-31-76

APPROVED AS NOTED
By CITY ENGINEER OF WICHITA
Sanitary Sewers D.E.S.
Storm Sewers
Driveway Approaches

OPTIONS:

1. Manholes - Type "A" brick manhole, or Type "C" concrete manhole.
2. Pipe - 8" V.C.P., or 8" A.B.S. Composite Pipe

PLAN SCALE: 1" = 10'-0"

Sht # 2

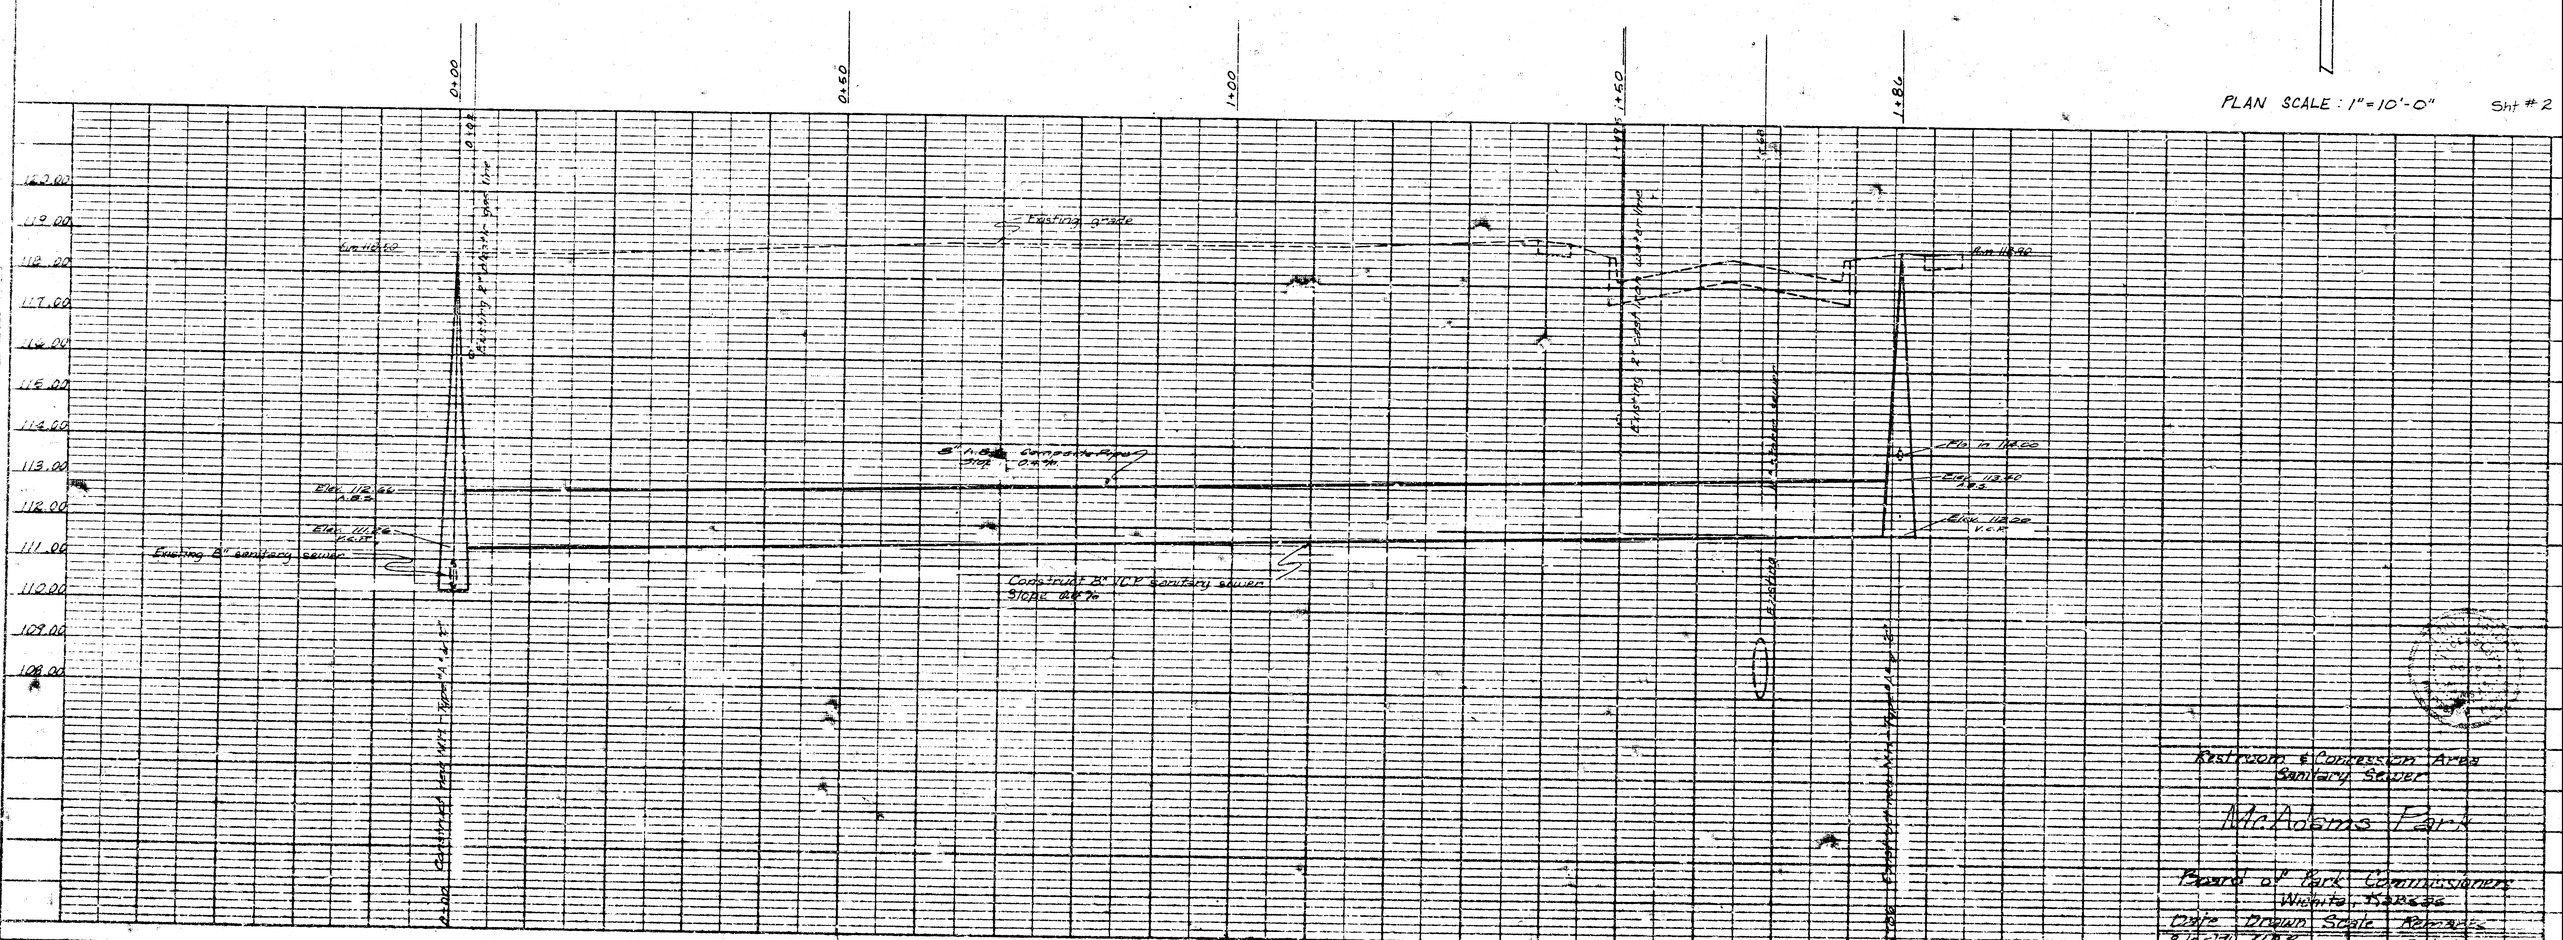

Restroom & Concession Area
Sanitary Sewer

McAdams Park

Board of Park Commissioners
Wichita, Kansas

Date Drawn Scale Remarks