14 6 2 (13)

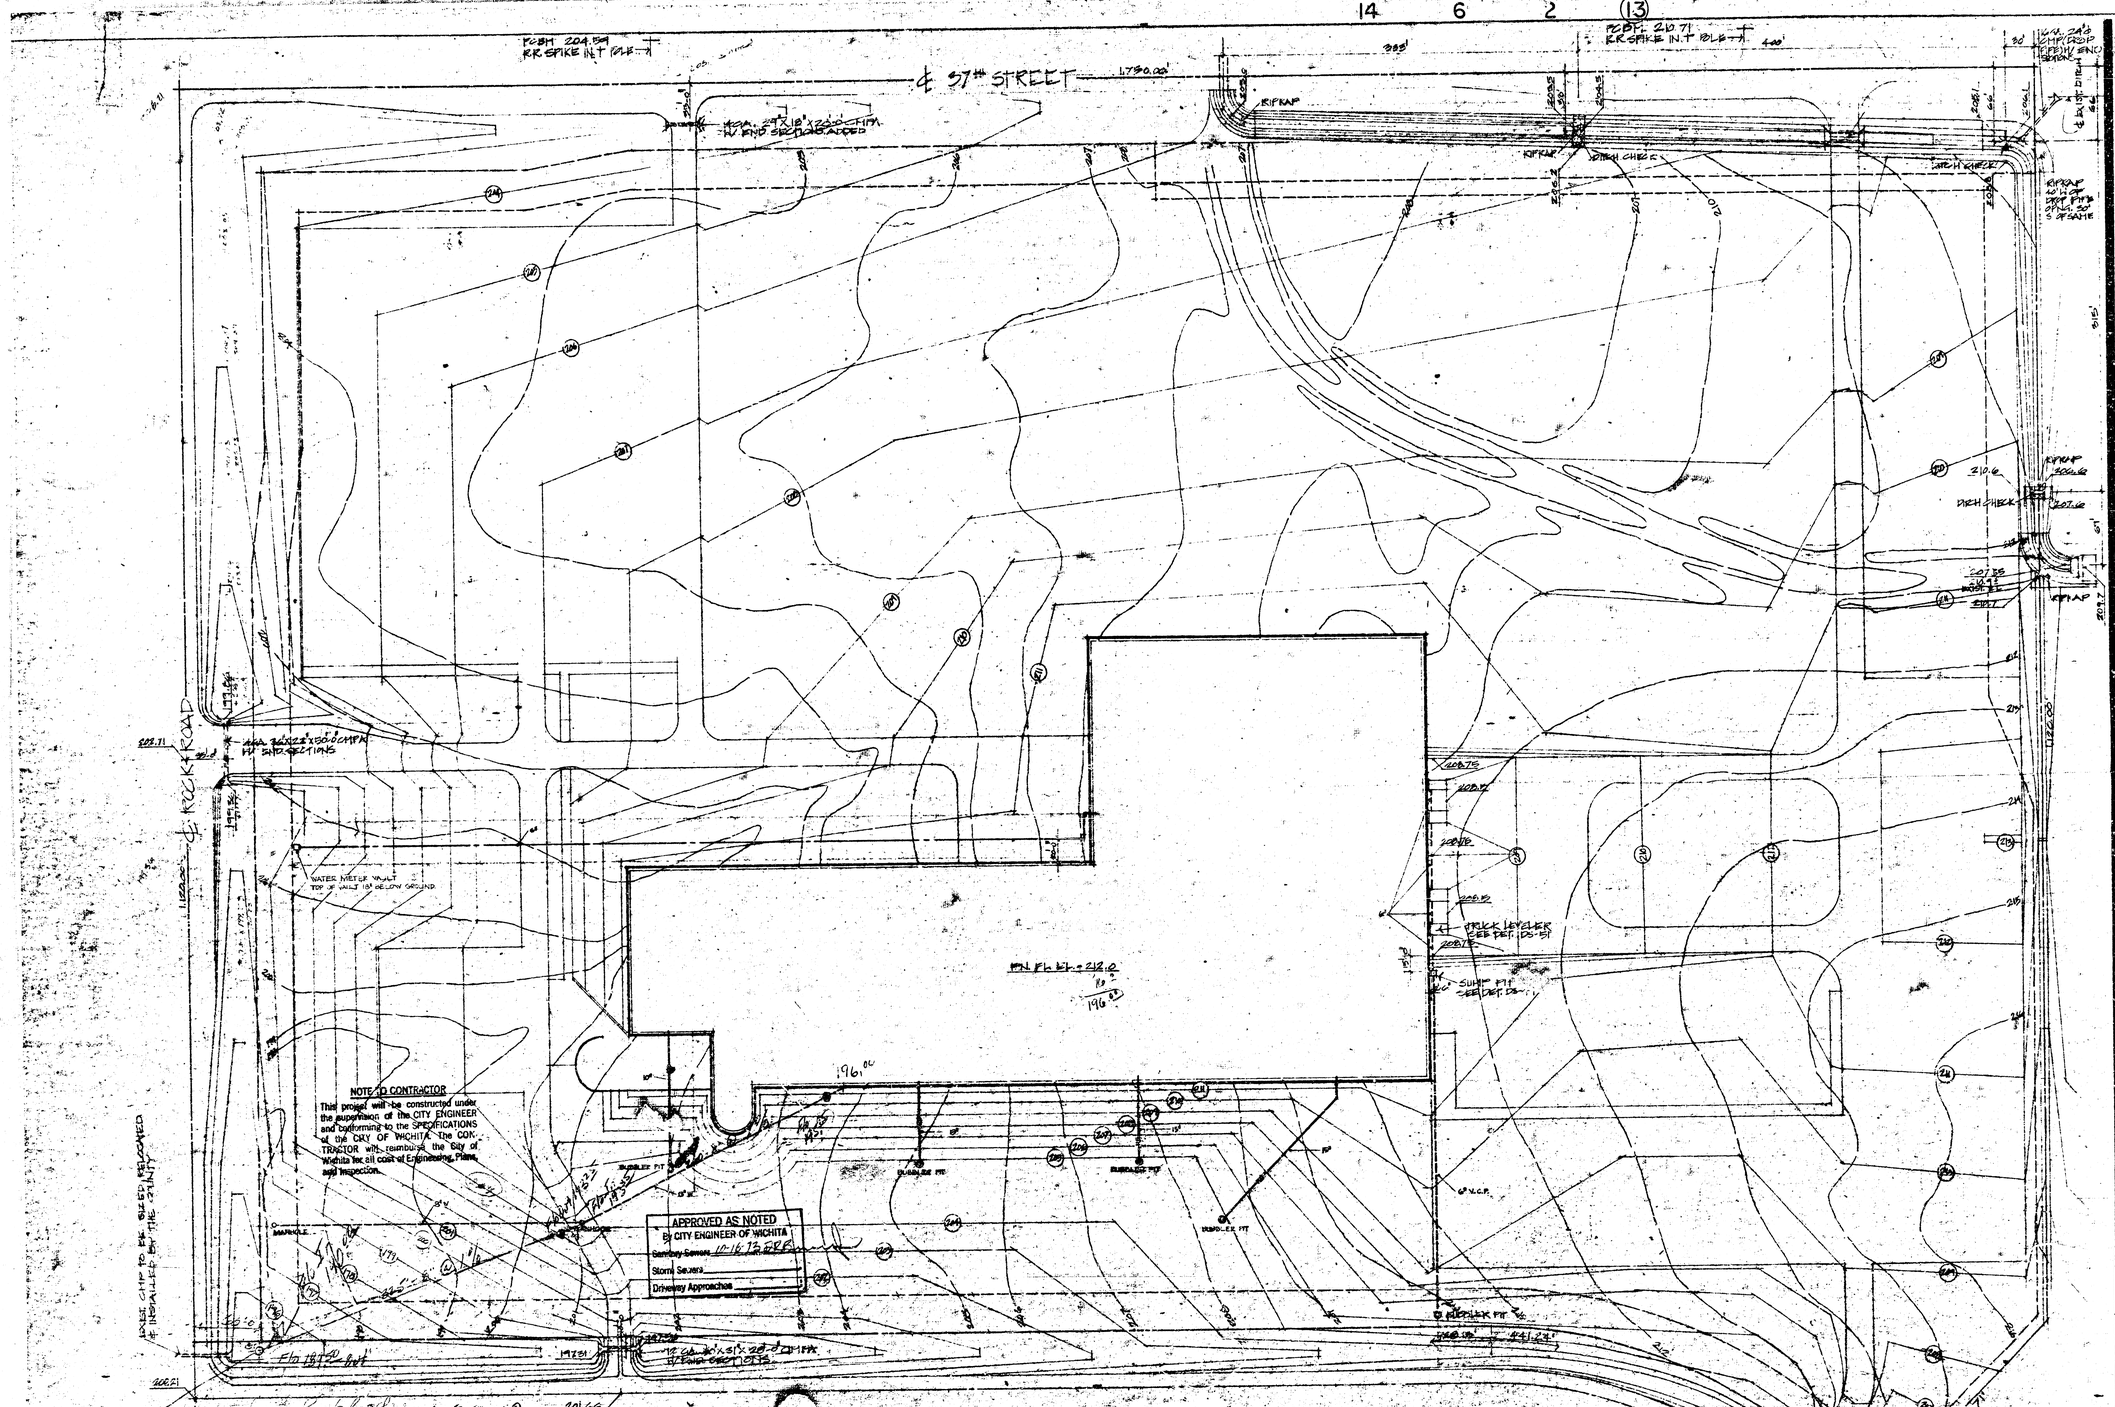

LEGAL DESCRIPTION: NCR Sani Sew

BEGINNING AT THE NORTHWEST CORNER OF THE NORTHWEST QUARTER OF SECTION 32, TOWNSHIP 26 SOUTH, RANGE 2 EAST OF THE 6TH P.M., SEDGWICK COUNTY, KANSAS; THENCE ALONG THE NORTH LINE OF SAID NORTHWEST QUARTER, BEARING NORTH 89°07'52" EAST, A DISTANCE OF 1760.00 FEET; THENCE PARALLEL WITH THE WEST LINE OF SAID NORTHWEST QUARTER, BEARING SOUTH 1°52' 14" EAST, A DISTANCE OF 1120.00; THENCE SOUTH 44°07'52" WEST, A DISTANCE OF 282.71 FEET; THENCE ALONG A CURVE TO THE LEFT WITH A RADIUS OF 1531.67 FEET, AN ARC DISTANCE OF 441.24 FEET, A 2-CALL CHORD OF 439.80 FEET; BEARING NORTH 68°22'25" WEST TO A POINT; THENCE PARALLEL WITH THE NORTH LINE OF SAID NORTHWEST QUARTER, BEARING SOUTH 89°07'52" WEST, A DISTANCE OF 1188.19 FEET TO A POINT ON THE WEST LINE OF SAID NORTHWEST QUARTER; THENCE ALONG SAID WEST LINE, BEARING NORTH 1°52' 14" WEST, A DISTANCE OF 1320.00 FEET TO THE PLACE OF BEGINNING, CONTAINING 40.00 ACRES, MORE OR LESS.

LEGEND

- (210) — HIGH CONTOUR LINE
- 204 — BRUSH CONTOUR LINE
- 207.2 — SPOT ELEVATION
- PROPERTY LINE
- RIGHT OF WAY LINE
- SET BACK & EASEMENT LINES
- RIPRAP (6" GRAVEL AND UNDER)

UTILITIES SITE PLAN

NCR
SANI SEWER
NW Rock Rd & 35TH ST NO

NO REV. JUNE 26, 75

SCHAEFER SCHIRMER & ASSOCIATES P.A.
ARCHITECTURE • PLANNING • LANDSCAPE DESIGN
URBAN DESIGN • INTERIOR DESIGN • ENGINEERING
WICHITA TOPEKA

NCR
COMPUTER DIVISION
37TH & ROCK ROAD WICHITA, KS.

DATE: FEB 21 73
DR: DHL
JOB: 72-536
SHEET NO.
G1A
OF SHEET 3