
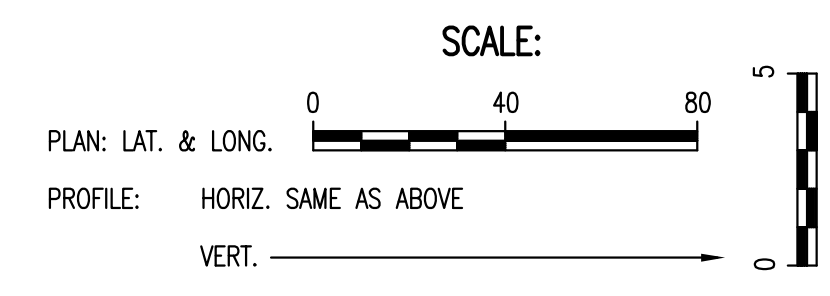


PLAN	CHECKED	DATE
	CHECKED	
BY		


PROFILE	CHECKED	DATE
	CHECKED	
BY		

Saved: 02-13-2008 10:54:04 AM by JAC
 Plot Scale: 1"=40'
 J:\SENTOUT\2008\05028\2008-02-13-08 to CIV\1386 PPW\DWG\05-CV3.5-Line01.dwg

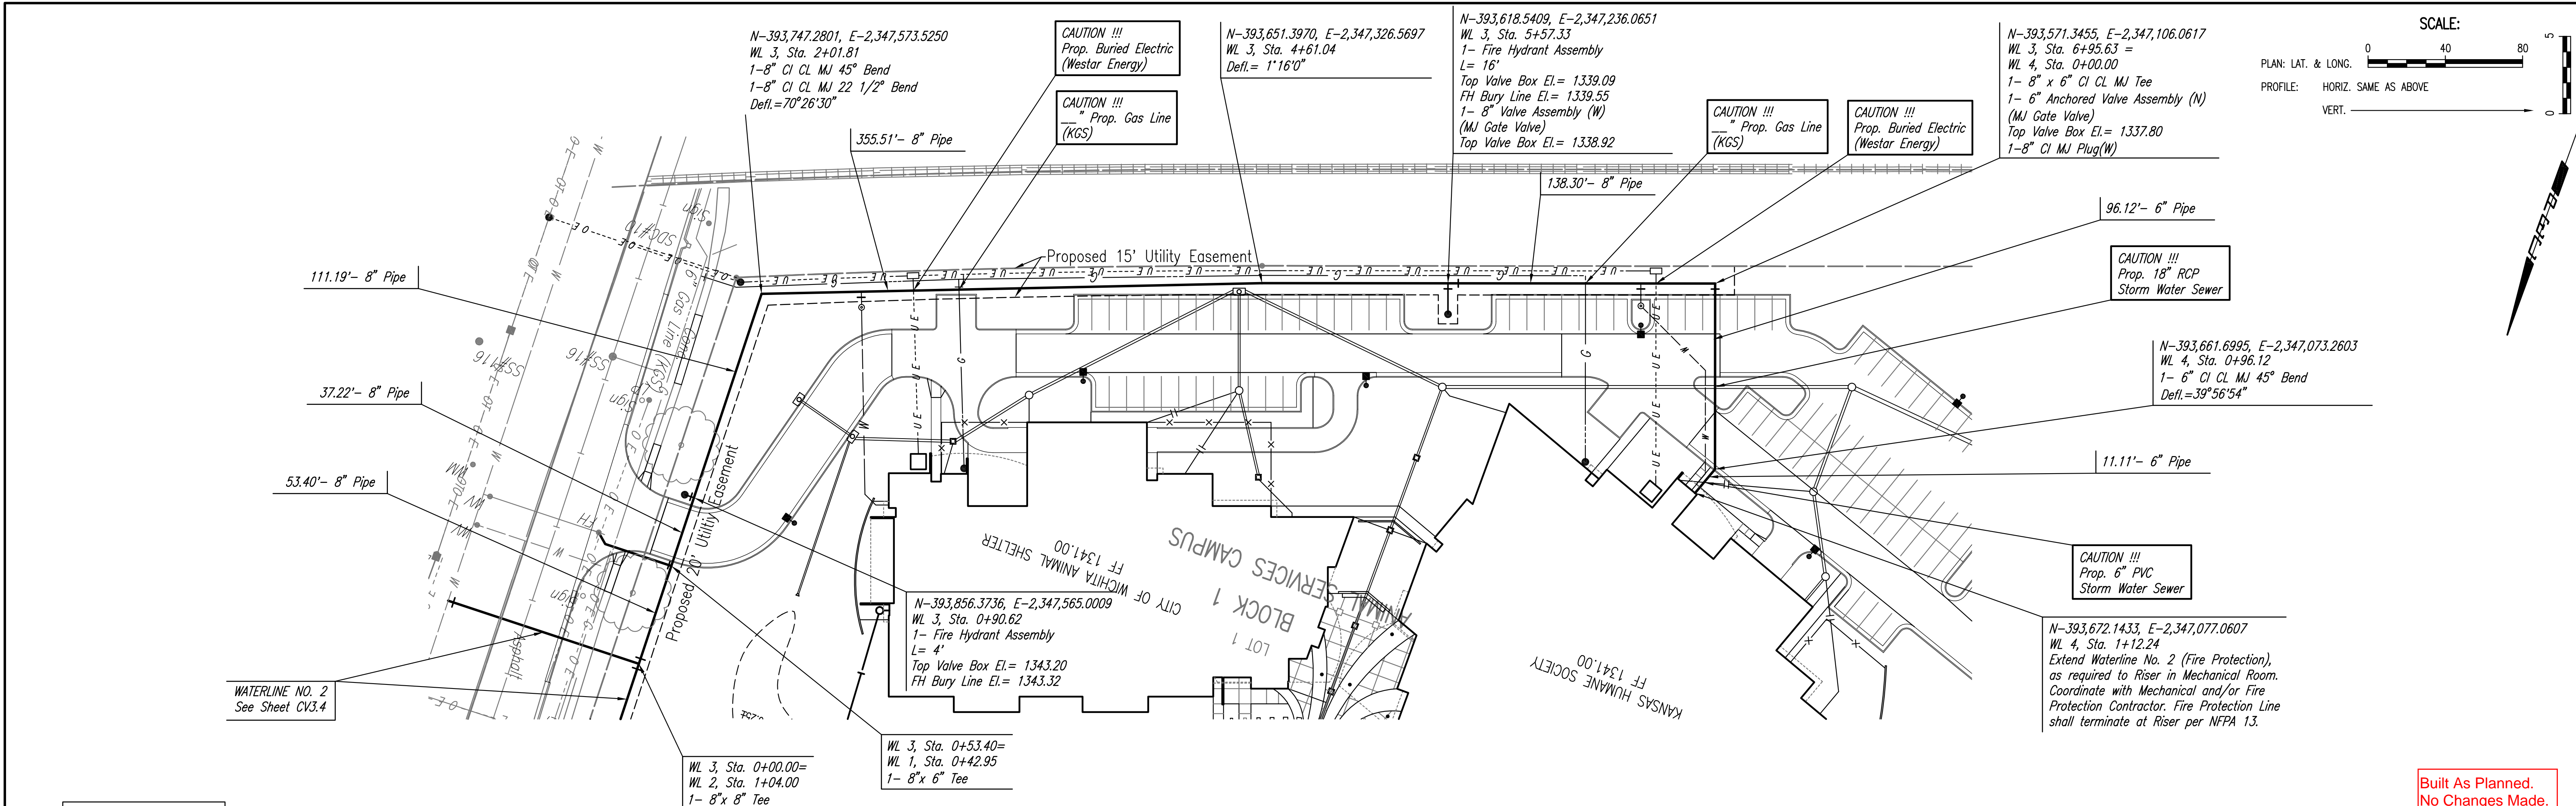

Unless noted otherwise, elevations shown are top of pipe

Built As Planned. No Changes Made.

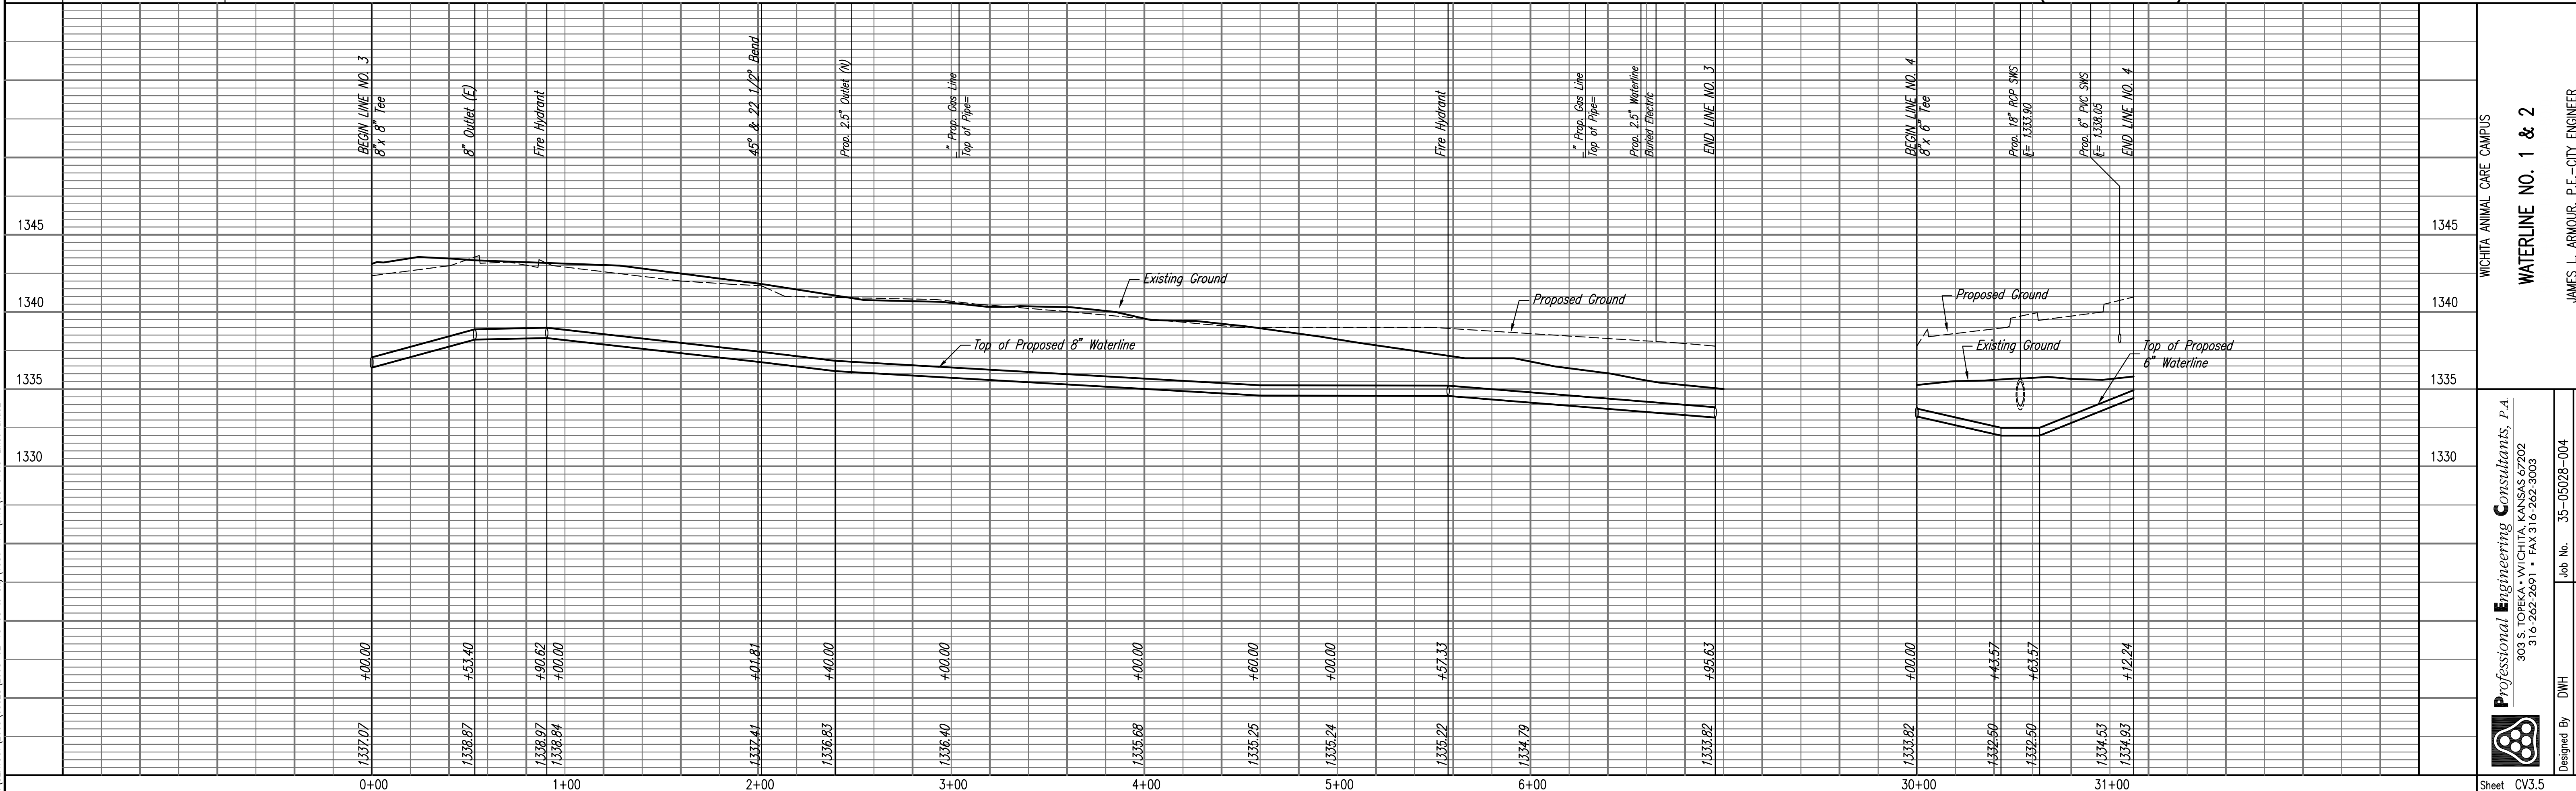

WICHITA ANIMAL CARE CAMPUS

WATERLINE NO. 1 & 2

JAMES L. ARMOUR, P.E. - CITY ENGINEER
 CITY OF WICHITA PRIVATE PROJECT NO. 1386 PPW (607853)

Professional Engineering Consultants, P.A.
 303 S. TOPEKA, WICHITA, KANSAS 67202
 316-262-2091 • FAX 316-262-3003

Designed by DWH
 Drawn by AEE

Job No. 35-05028-004
 Date January 2008

Sheet CV3.5