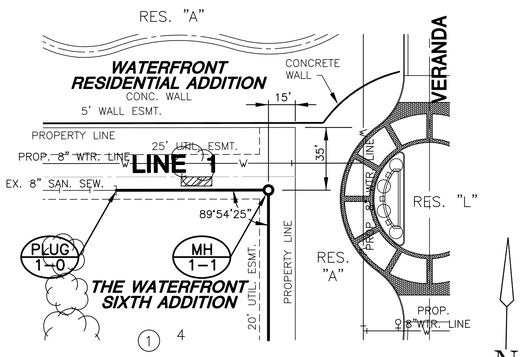

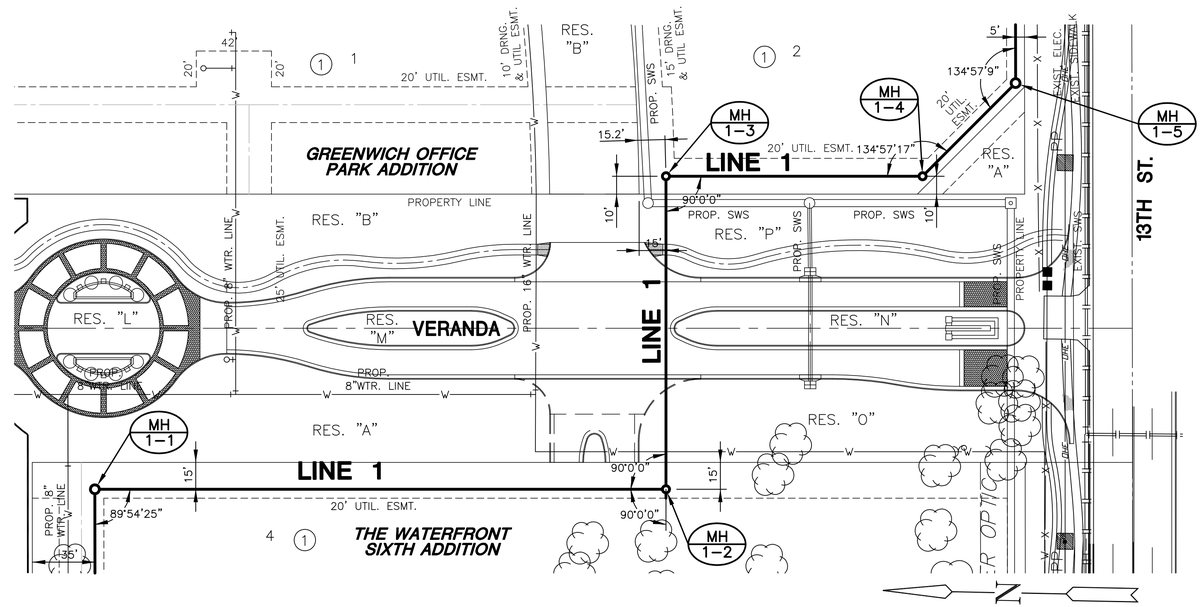

NOTE:
CONTRACTOR TO VERIFY THE DEPTH AND LOCATION OF EXISTING UTILITIES PRIOR TO CONSTRUCTION.

PLAN LINE 1

SCALE: 1"= 40'
0 20 40 80

PLAN LINE 1

SCALE: 1"= 40'
0 20 40 80

= TREE TRIMMING

PROFILE LINE 1

SCALE: HORIZ. 1"=40'
SCALE: VERT. 1"=5'

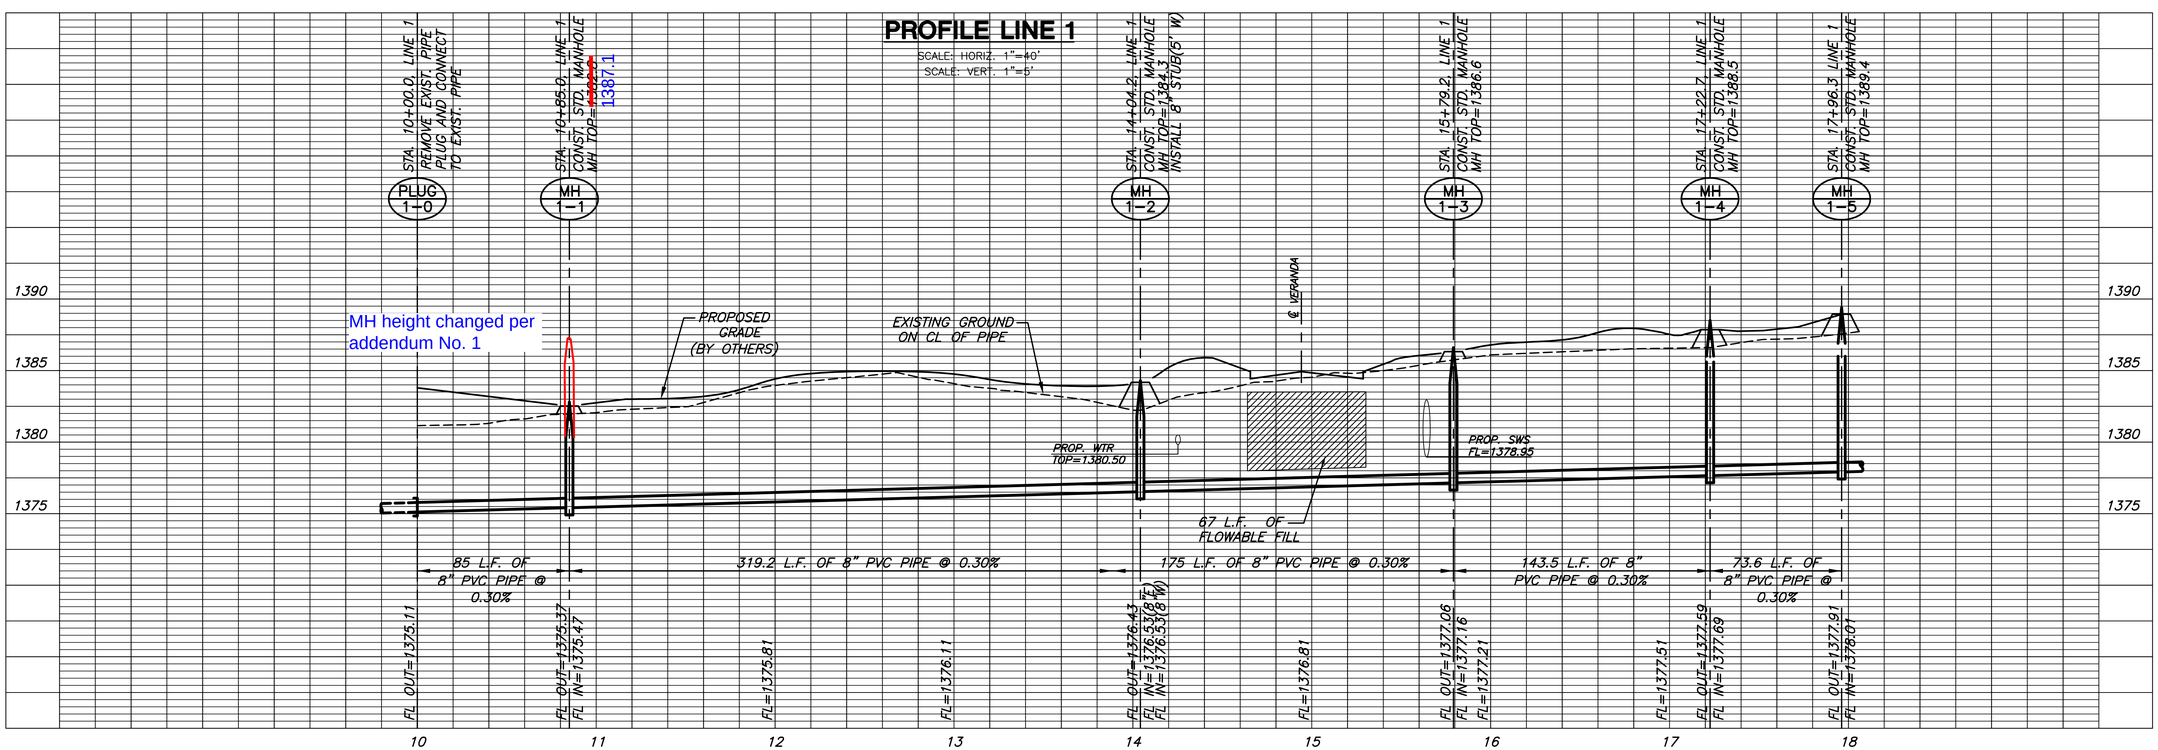

MKEC ENGINEERING CONSULTANTS, INC.
411 N. WEBB ROAD
WICHITA, KS. 67206
316 - 684 - 9600

SANITARY SEWER PLANS FOR GREENWICH OFFICE PARK

PHASE 1

LINE 1
SHEET TITLE

468-84408
PROJECT NUMBER

SRS
DESIGN BY

MKEC
DRAWN BY

DFL
CHECKED BY

ISSUED
October 2007

REVISED

SHEET NO.
4 of 12

PLOTTED: Tuesday, October 23, 2007 @ 05:45PM

J:\CIVIL\06266\DWG\SAN\GREENWICH OFFICE PARK\PHASE1\06266_B1.DWG