
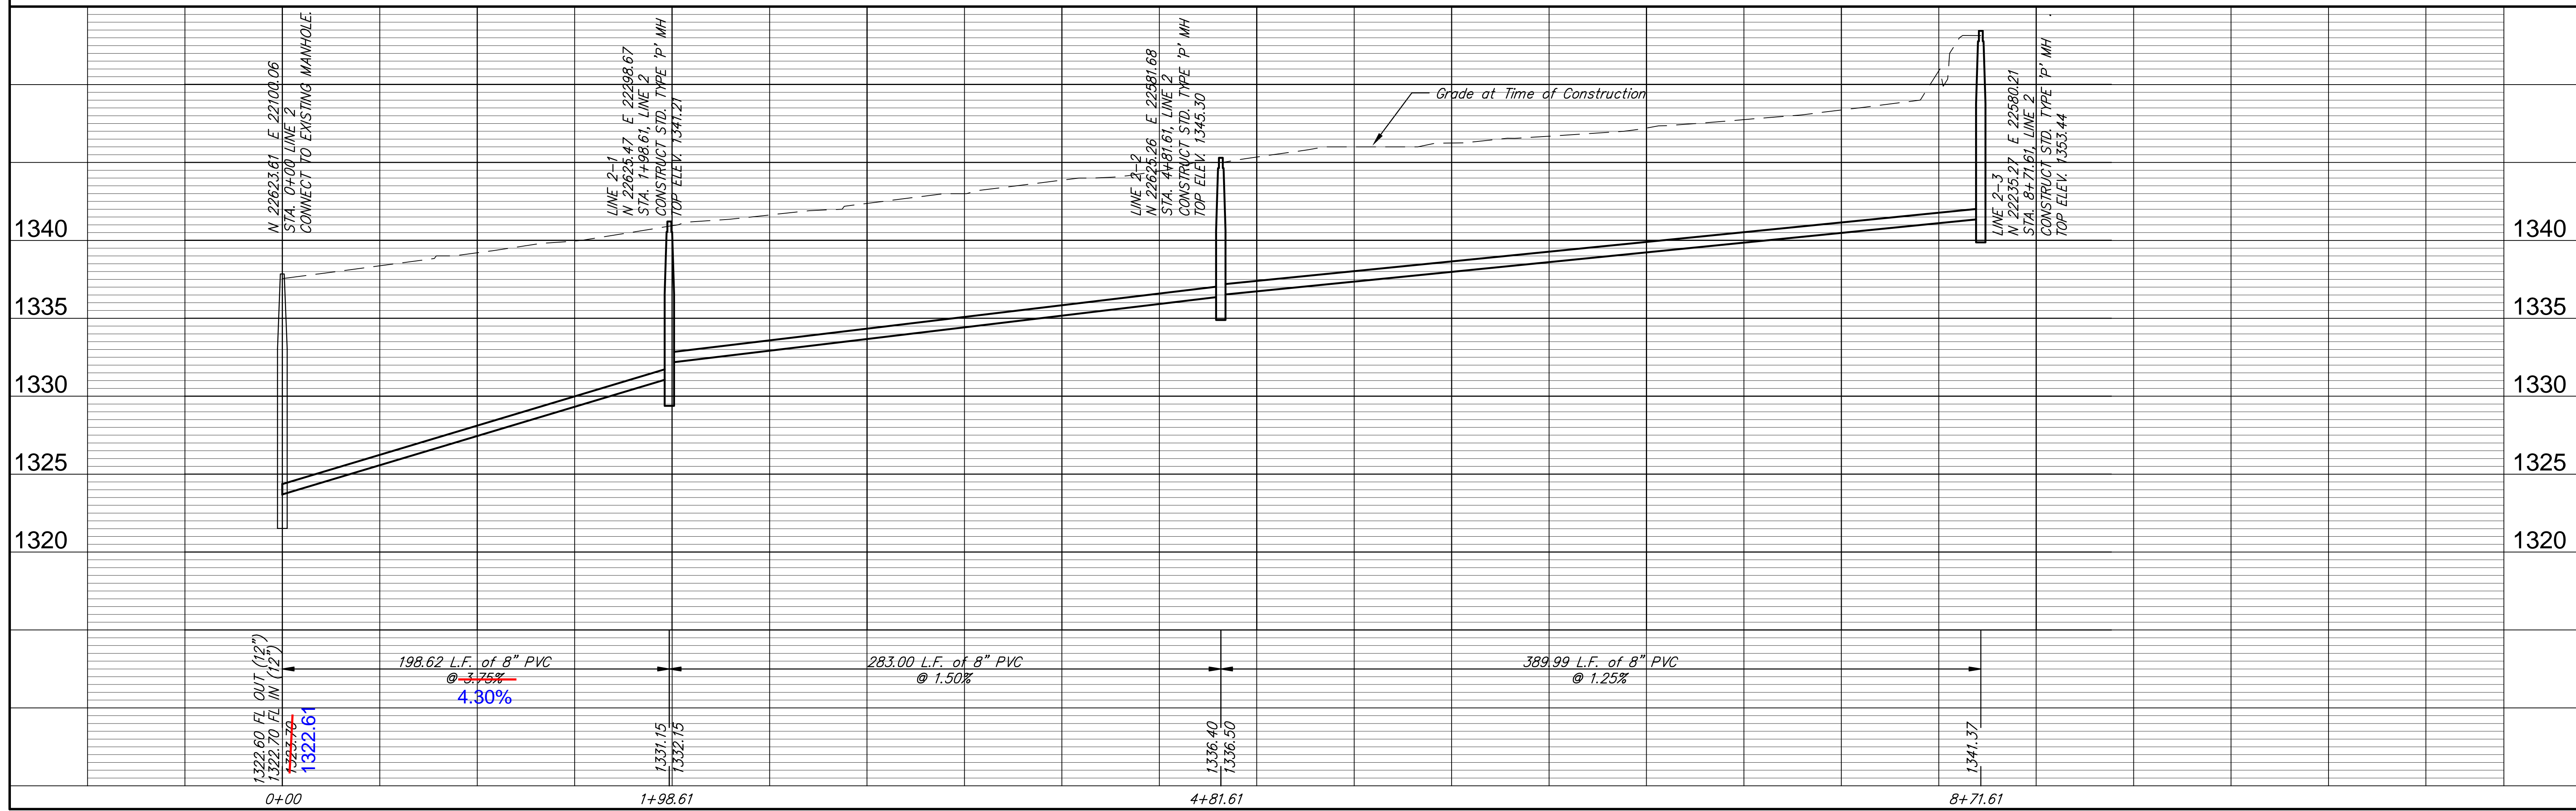


Note: Existing stub was lower than grade shown on plans. Adjusted grade to 4.3%

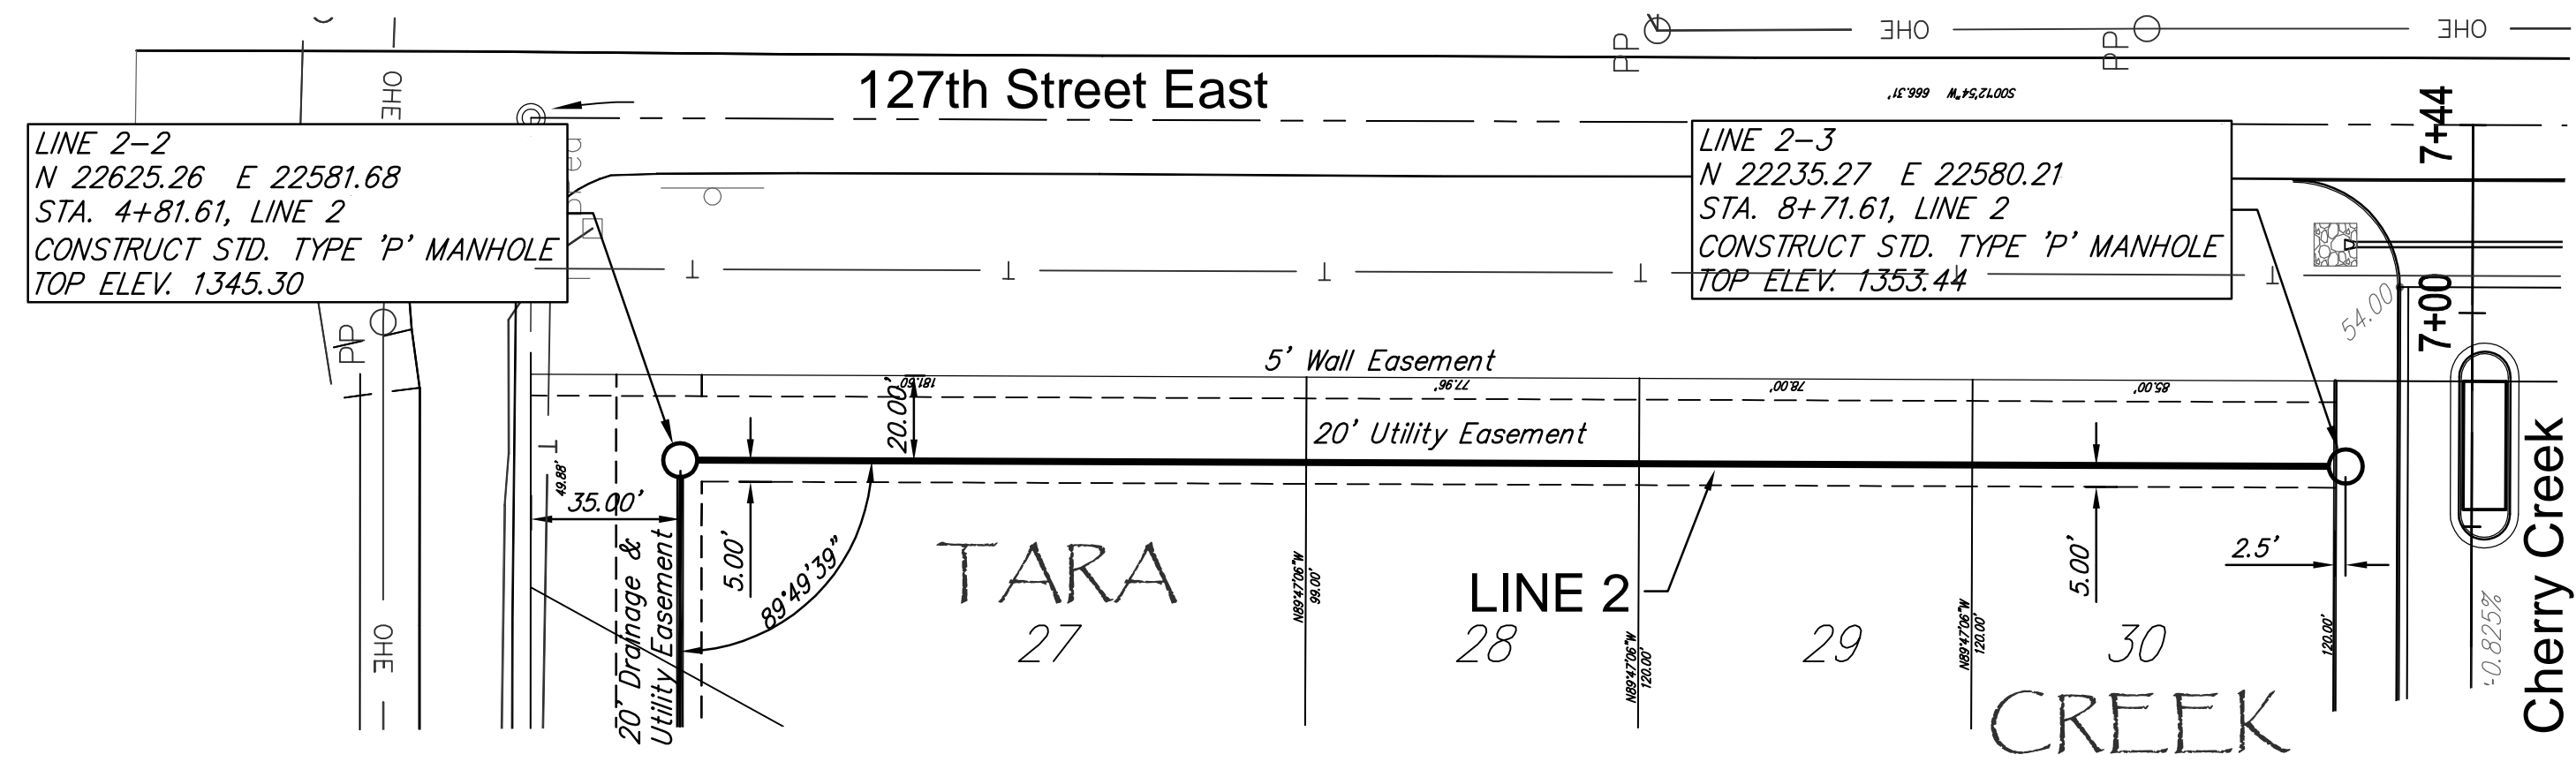

PROJECT NUMBER  
 DRAWING FILE  
 SS Line 2-1

DESIGN  
 CMB  
 UTILITY

DRAWN  
 RA

REVISION  
 DATE  
 Sept. 27, 2007

REVIEW  
 REVIEW

TARA CREEK ADDITION  
 LINE 2  
 WICHITA KANSAS

RB JOB  
 3032E  
 SHEET  
 4  
 OF  
 16

Kuegler & Bohm, P.A.  
 Engineering, Surveying, Land Planning  
 804 North Main  
 Wichita, Kansas 67203  
 www.kuegler.com  
 Phone: 316-264-9000  
 Fax: 316-264-9022  
 Email: info@kuegler.com