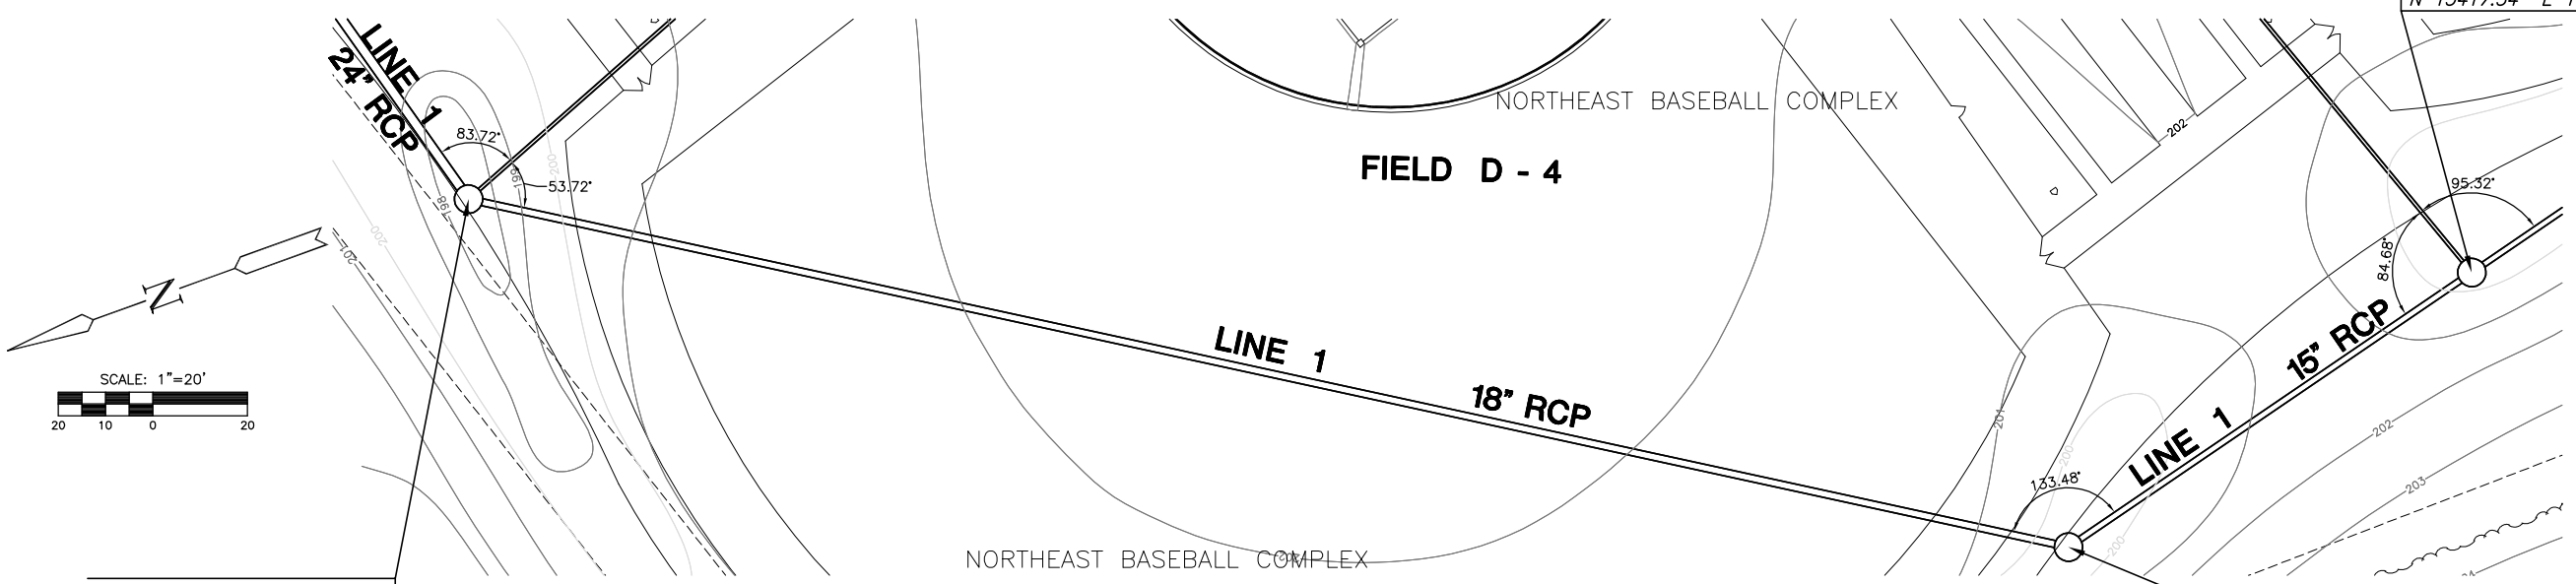

STA. 14+29.6, LINE 1
4' DIA. SHALLOW TYPE "A" MH
W/DEETER FRAME & GRATE NO.
1927 OR APPROVED EQUAL
MANHOLE TOP=197.5 **AB**
PROVIDE SEDIMENT BARRIER
N 13810.23 E 11472.12

STA. 18+78.9, LINE 1, CONSTRUCT 4'
DIA. SHALLOW TYPE "A" MANHOLE
W/DEETER FRAME & GRATE NO. 1927 OR
APPROVED EQUAL MANHOLE TOP=199.5 **AB**
PROVIDE SEDIMENT BARRIER
N 13417.54 E 11312.68

STA. 17+75.7, LINE 1, CONSTRUCT 4' DIA.
SHALLOW TYPE "A" MANHOLE
W/DEETER FRAME & GRATE NO. 1927 OR
APPROVED EQUAL MANHOLE TOP=199.0 **AB**
PROVIDE SEDIMENT BARRIER
N 13517.55 E 11287.28

AS-BUILT AUGUST 2008

PLAN LINE 1

SCALE: 1"=20'

PROFILE LINE 1

SCALE: HORIZ. 1"=20'
SCALE: VERT. 1"=5'

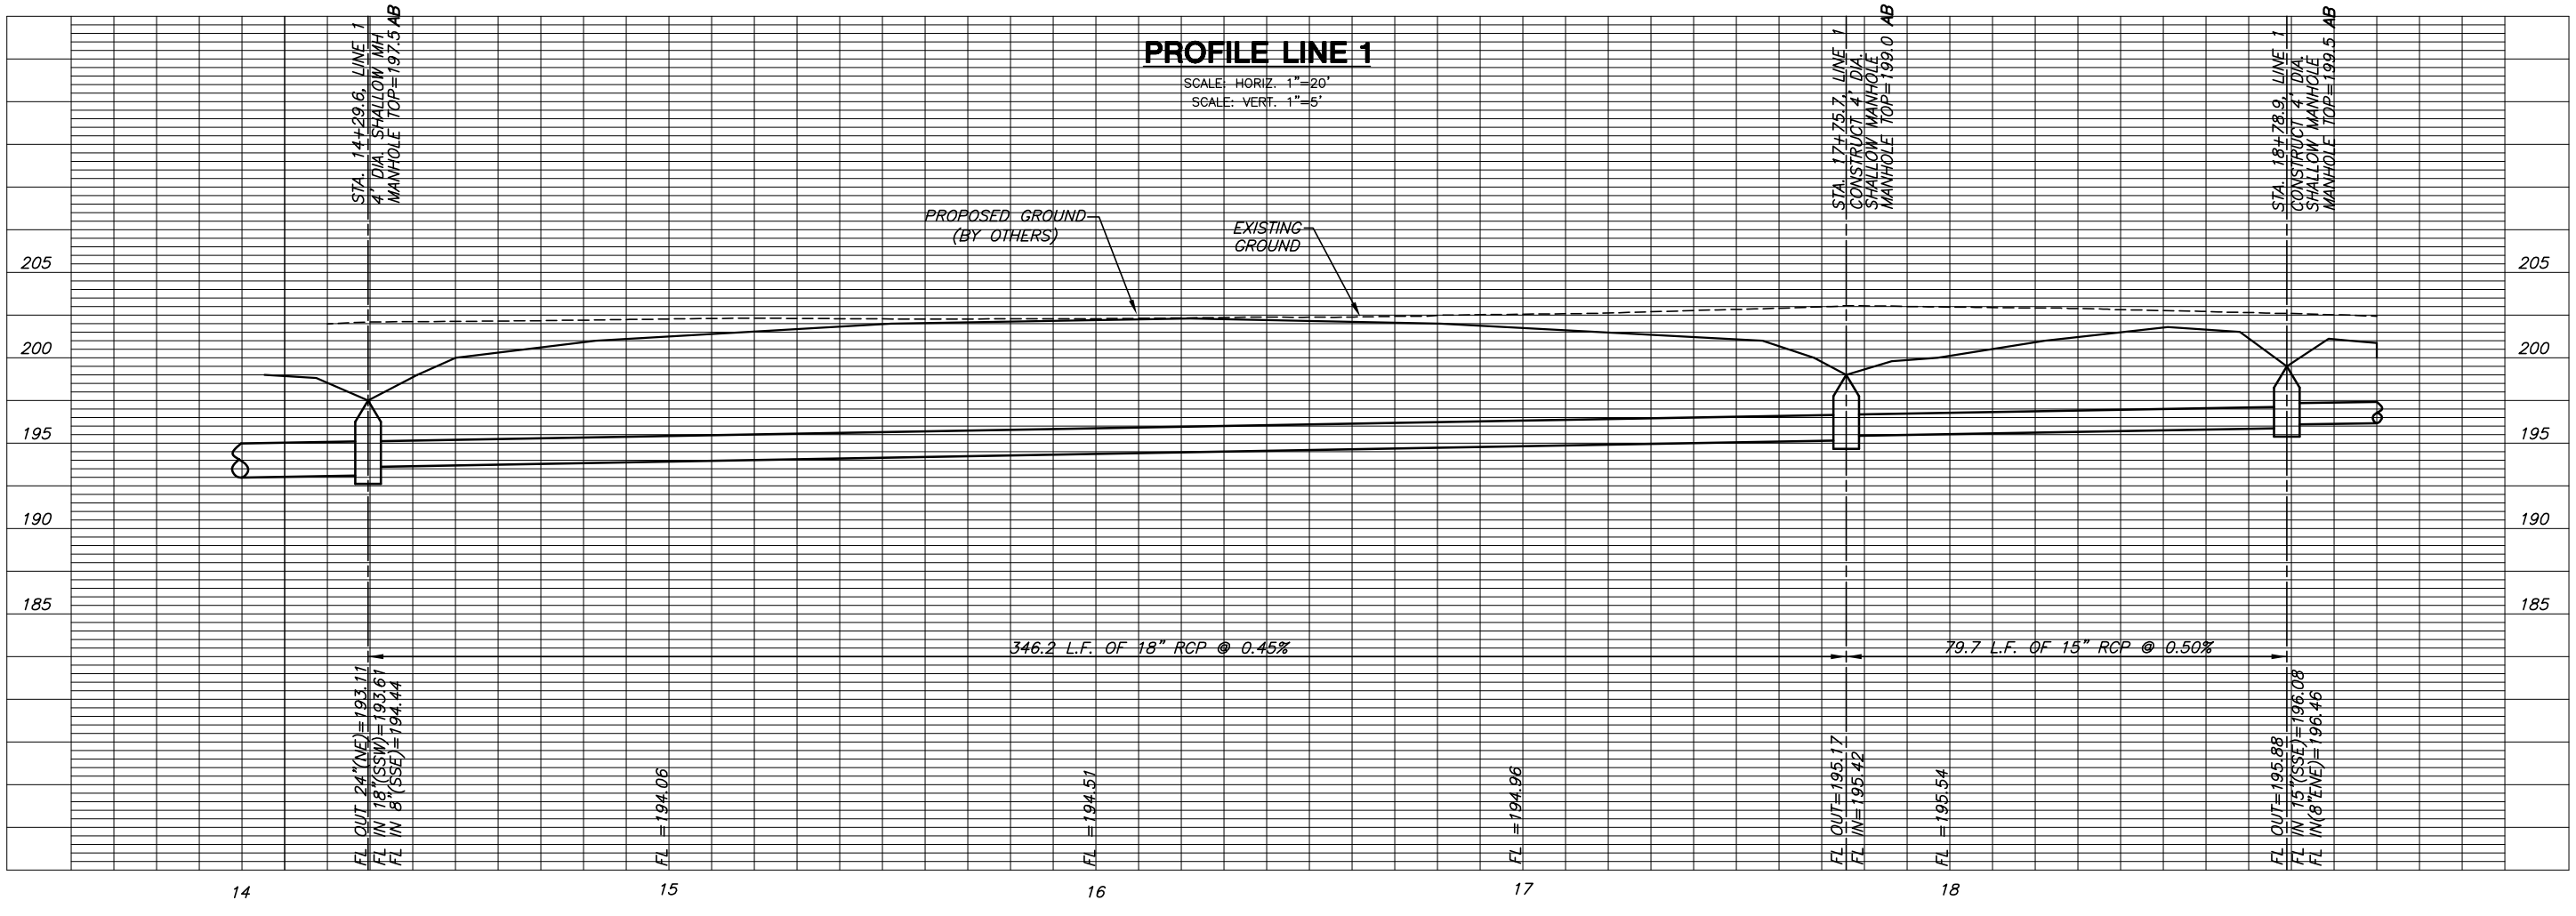

MKEC ENGINEERING CONSULTANTS, INC.
411 N. WEBB ROAD
WICHITA, KS. 67206
316-684-9600

STORM WATER SEWER

NORTHEAST BASEBALL COMPLEX

PHASE 1

SHEET TITLE: **LINE 1**

PROJECT NUMBER: 1853PPS

DESIGN BY: JTC

DRAWN BY: DDG

CHECKED BY: GJA

ISSUED: August 2008

REVISED

SHEET NO. **5 of 17**

PLOTTED: Thursday, August 07, 2008 @ 03:30PM

J:\CIVIL\1853402_NE BASEBALL\ADVANCED\SUBMITTALS\BUILDING\GEOTECH\1853402NE-LINE1.DWG