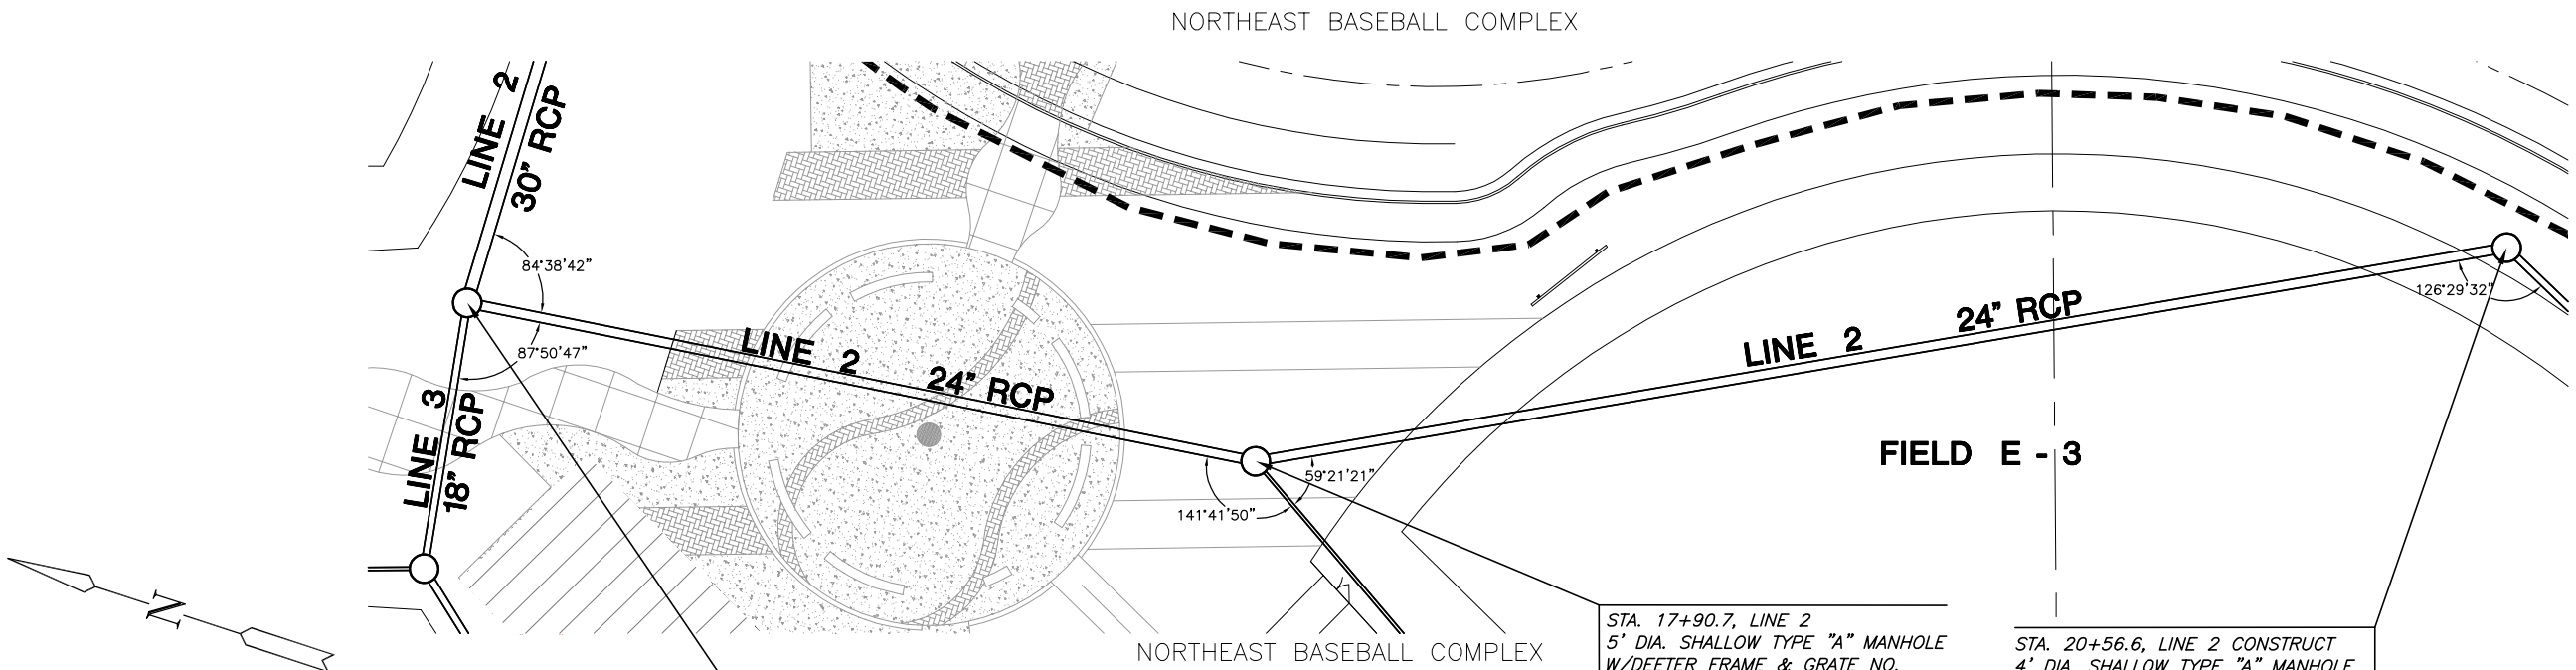

PLAN LINE 2

SCALE: 1"=20'

AS-BUILT AUGUST 2008

PROFILE LINE 2

SCALE: HORIZ. 1"=20'
SCALE: VERT. 1"=5'

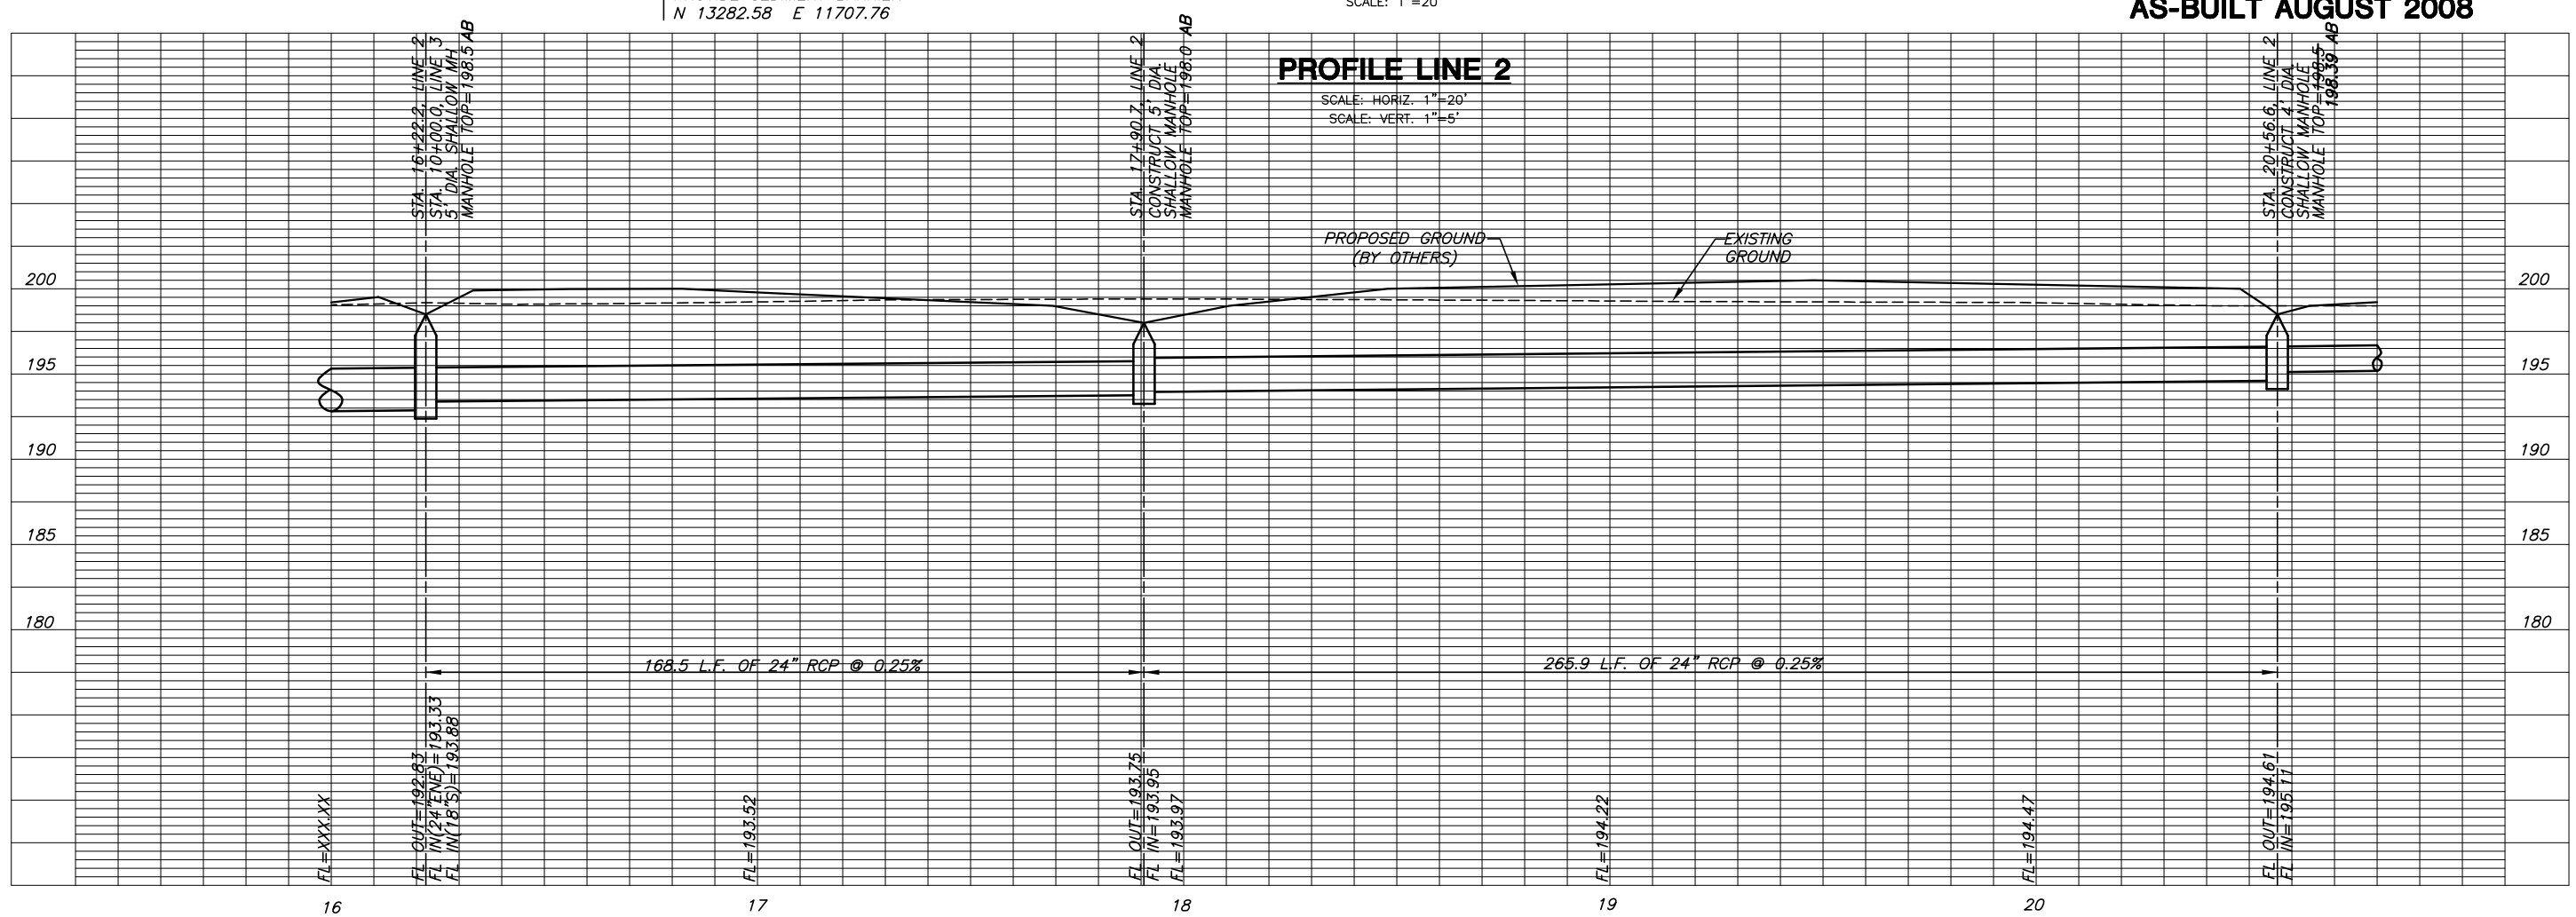

MKEC ENGINEERING CONSULTANTS, INC.
411 N. WEBB ROAD
WICHITA, KS. 67206
316 - 684 - 9600

STORM WATER SEWER

NORTHEAST BASEBALL COMPLEX

PHASE 1

LINE 2
SHEET TITLE

1853PPS
PROJECT NUMBER

JTC
DESIGN BY

DDG
DRAWN BY

GJA
CHECKED BY

ISSUED
August 2008

REVISED

SHEET NO.
9 of 17

PLOTTED: Thursday, August 07, 2008 @ 03:42PM

J:\CIVIL\1853PPS_NE BASEBALL\ACAD\CIVIL\DWG\PLAN\PLAN-PROFILE\1853DD06.DWG