



TRENCHES TO BE BACKFILLED WITH SAND AND FLUSHED WHEN SEWER LINE RUNS ALONG FRONT OF LOTS. (LINE 3, STA. 10+00.00 TO STA. 11+52.1)

**CEDAR VIEW VILLAGE ADDITION**

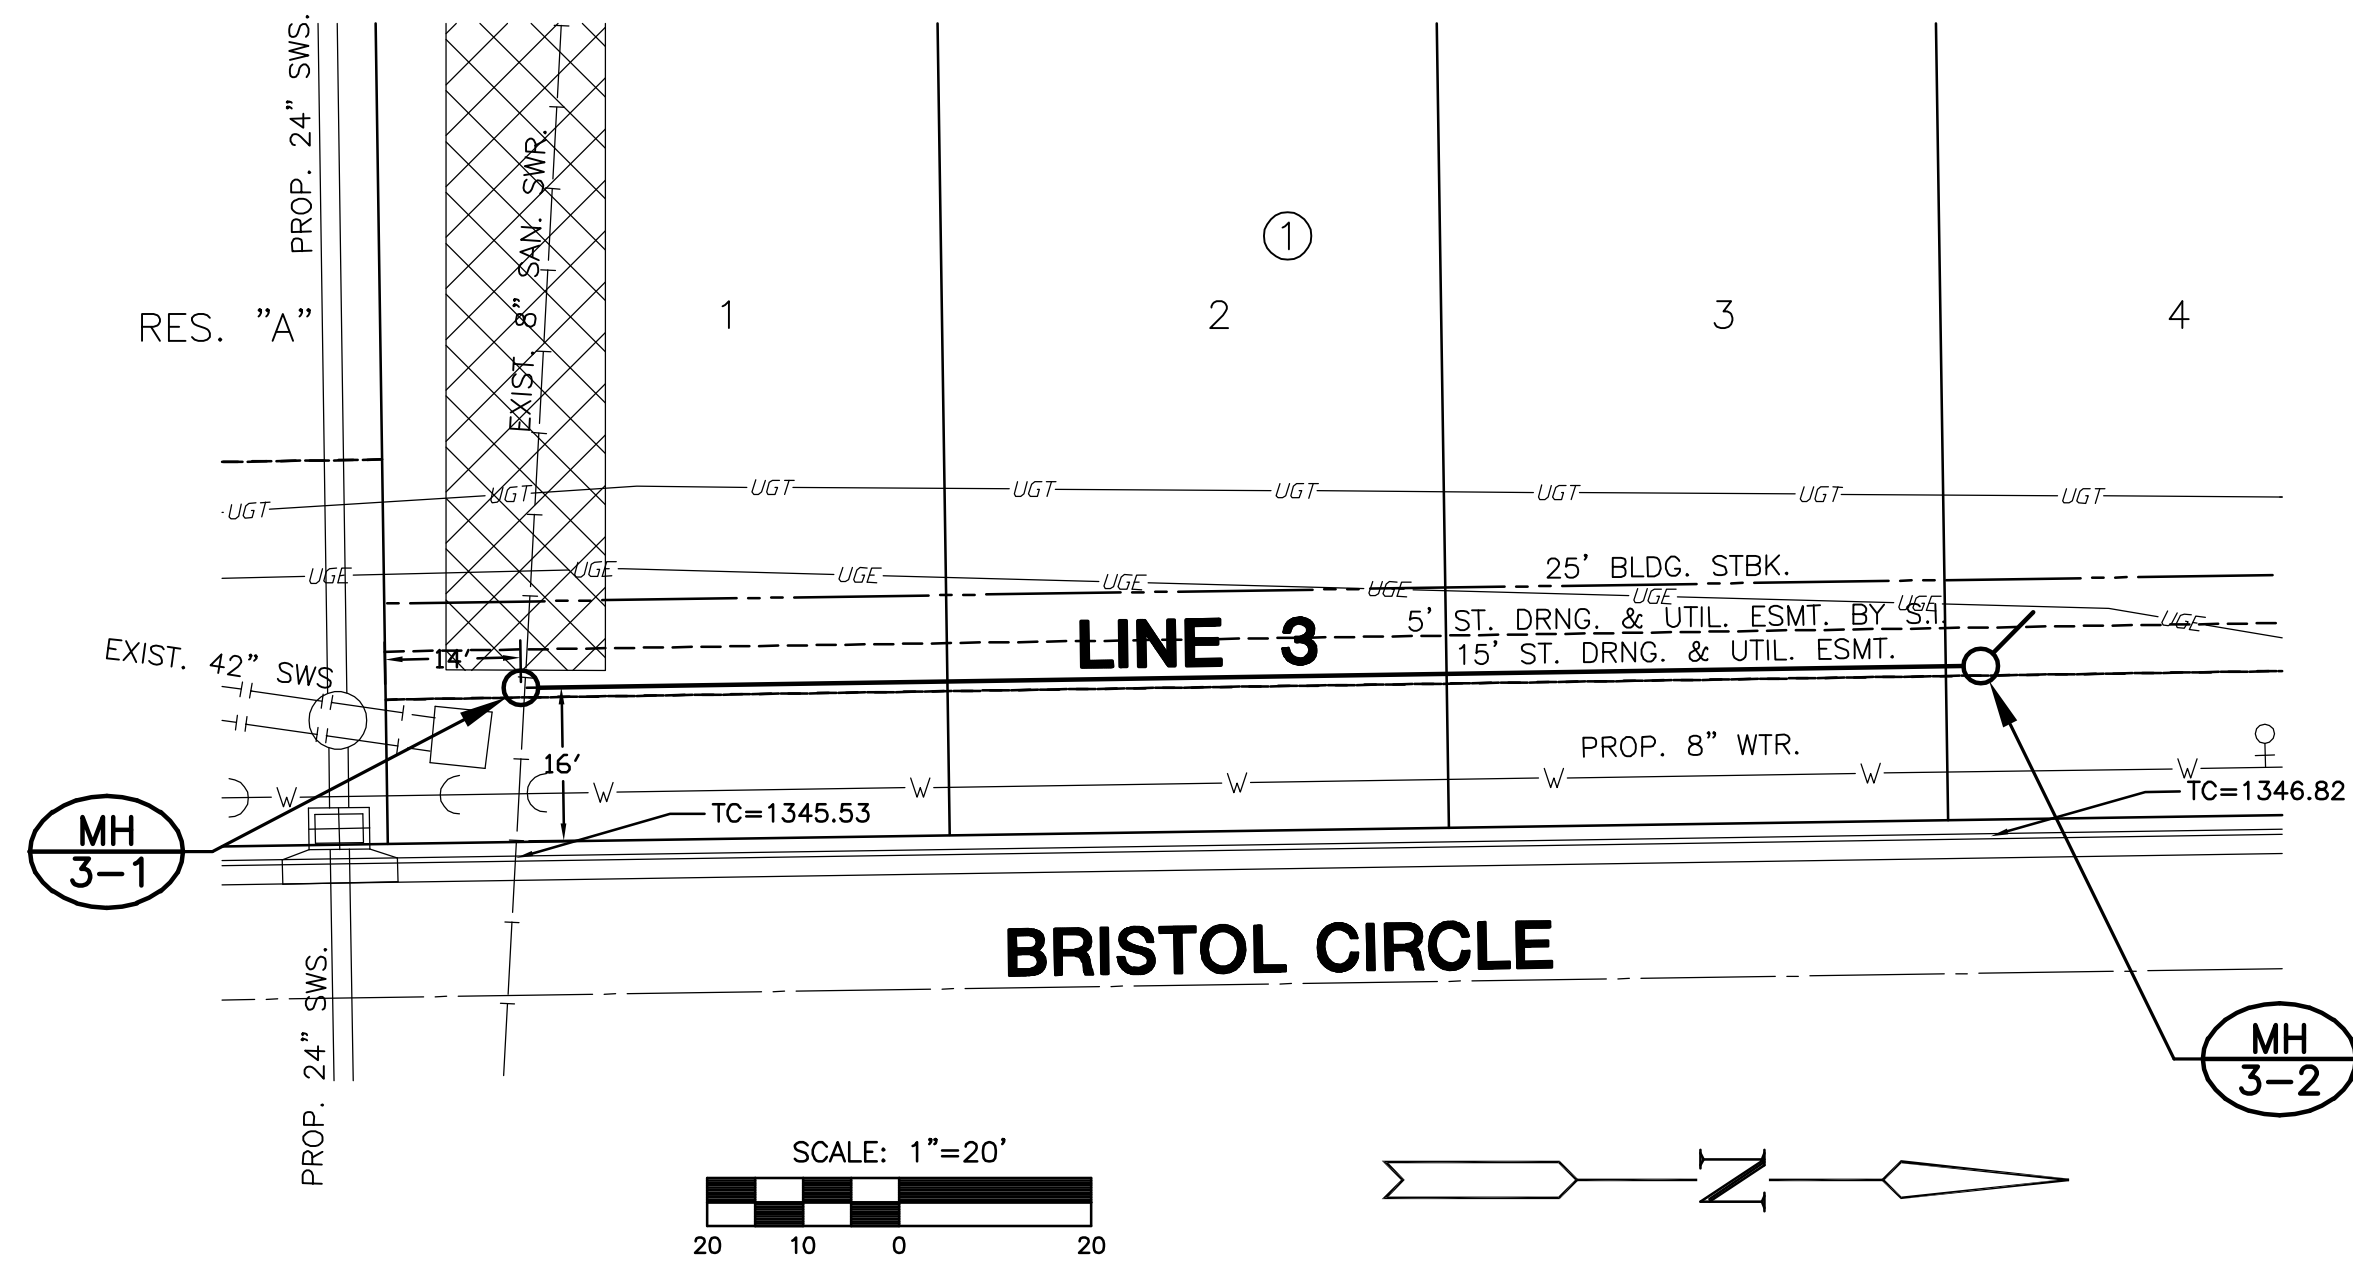


**PLAN LINE 3**

**PROFILE LINE 3**

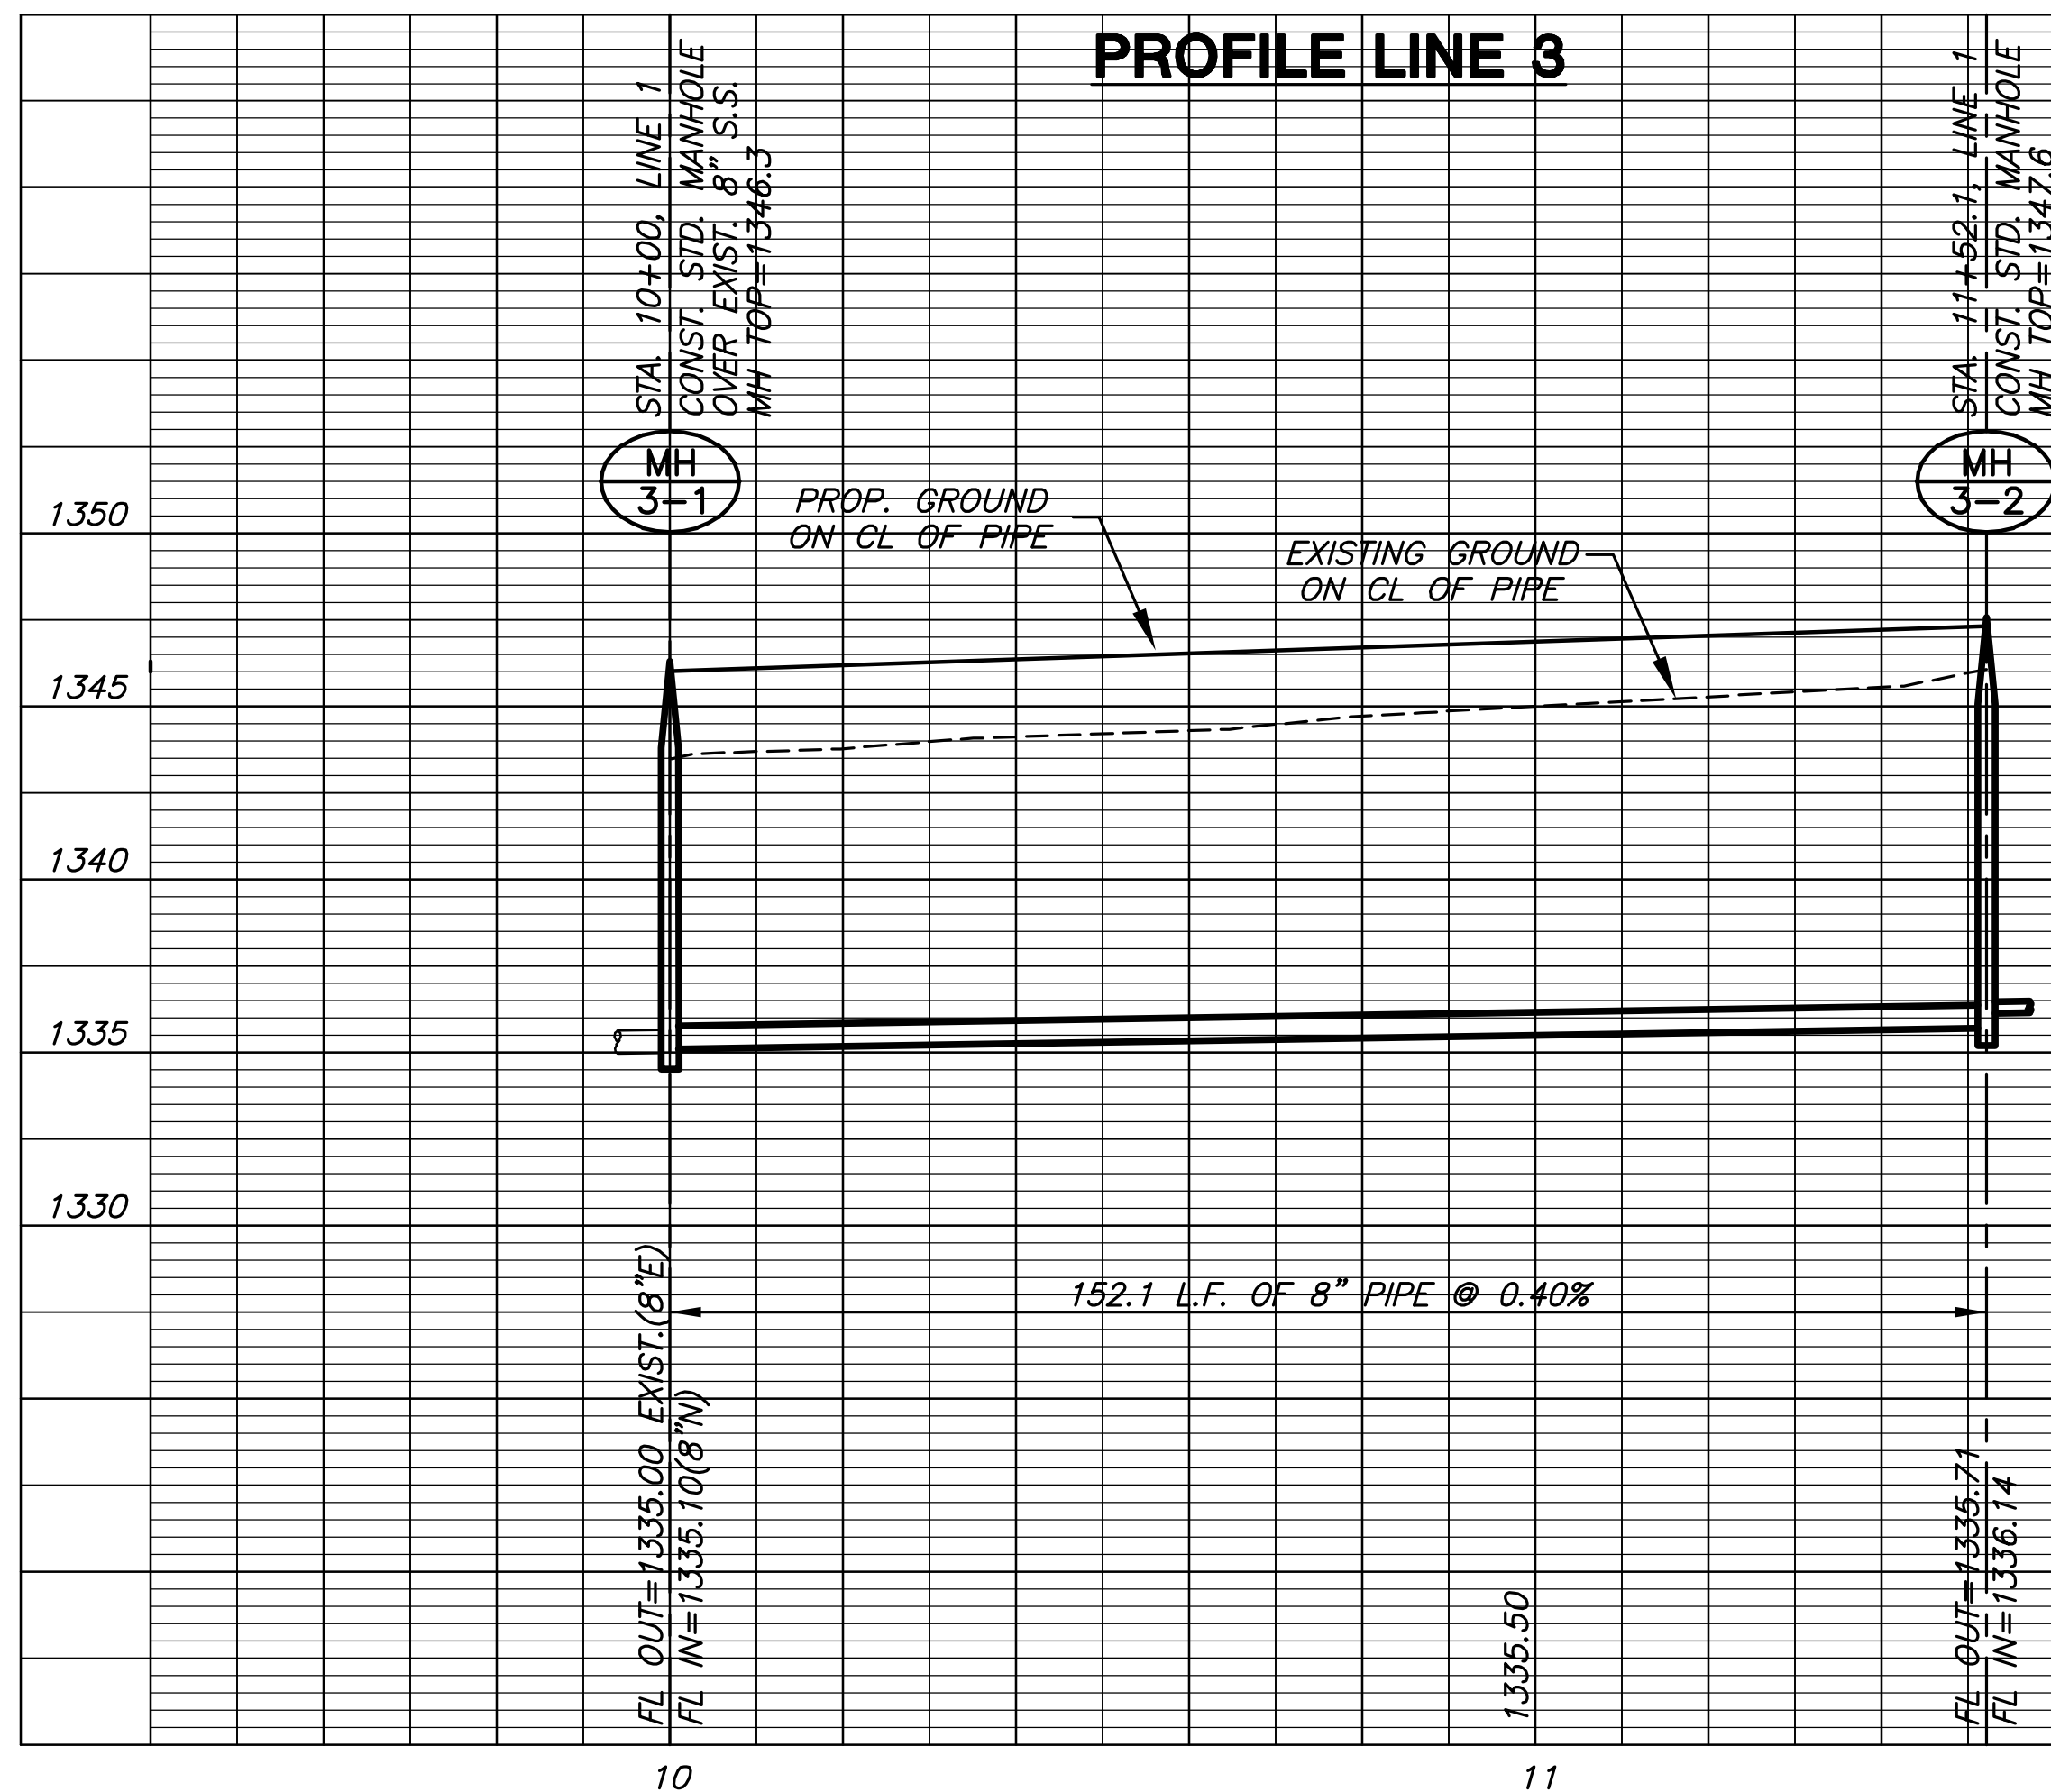


**CEDAR VIEW VILLAGE ADDITION**

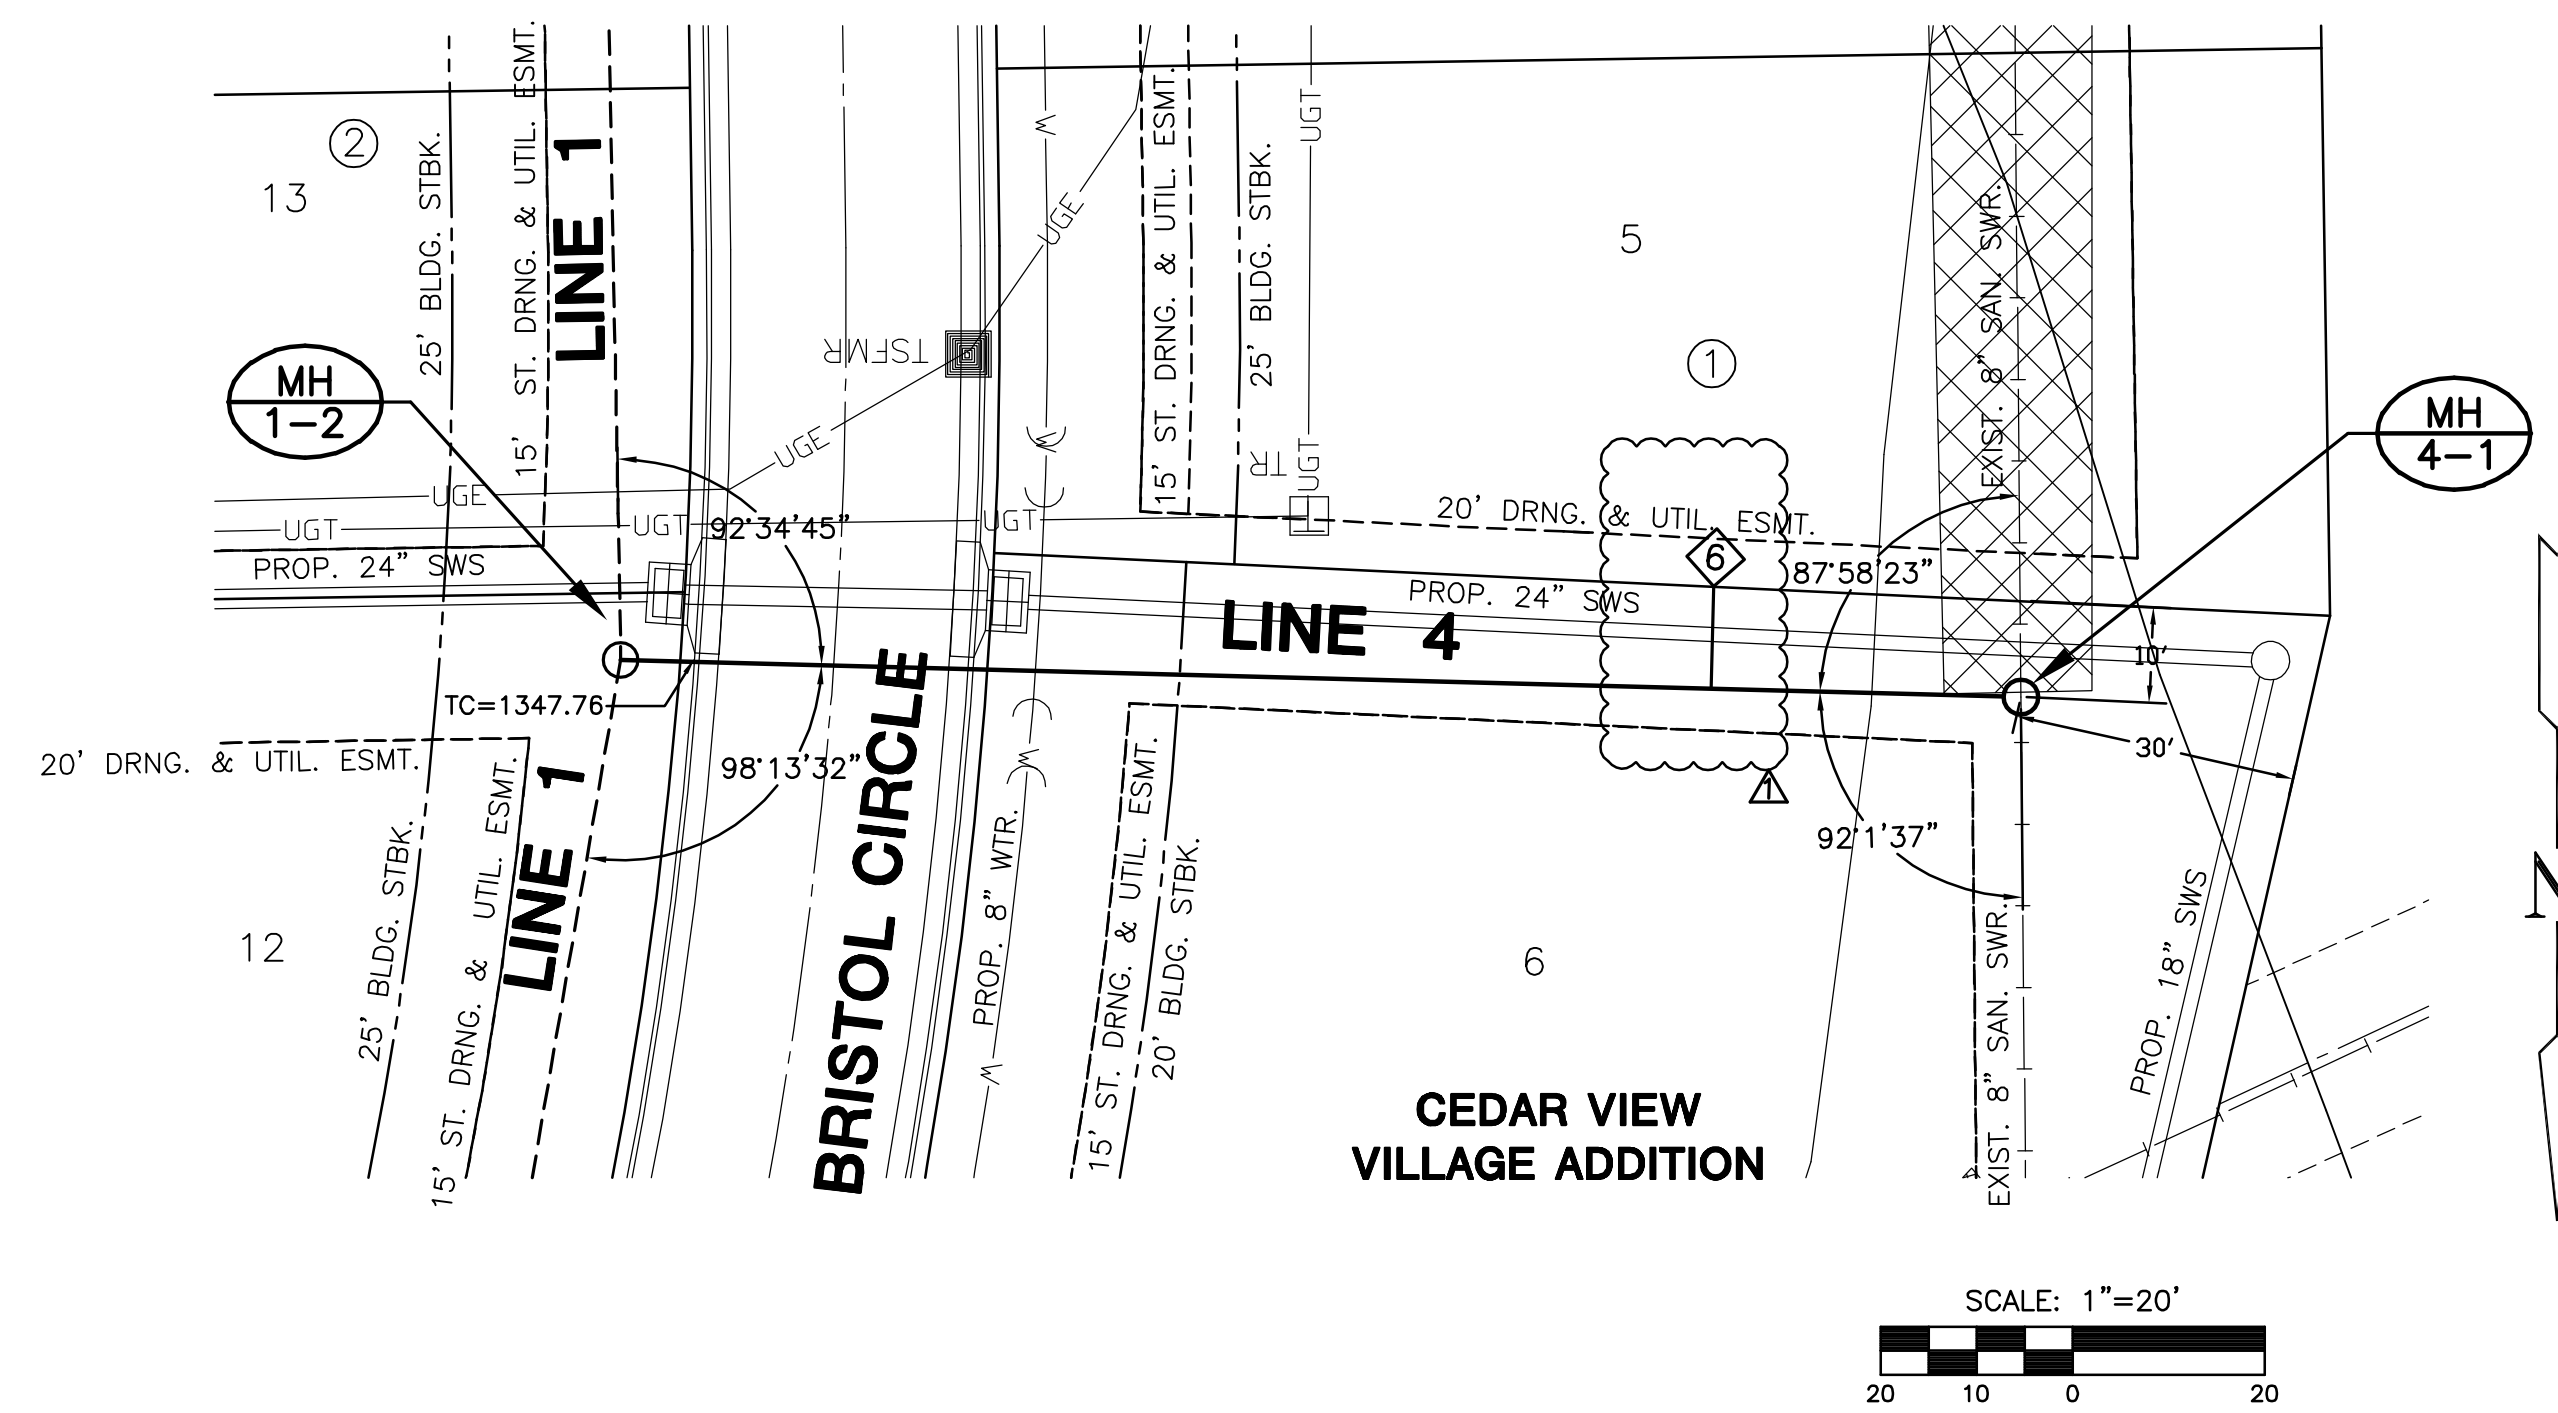

**PLAN LINE 4**

**PROFILE LINE 4**

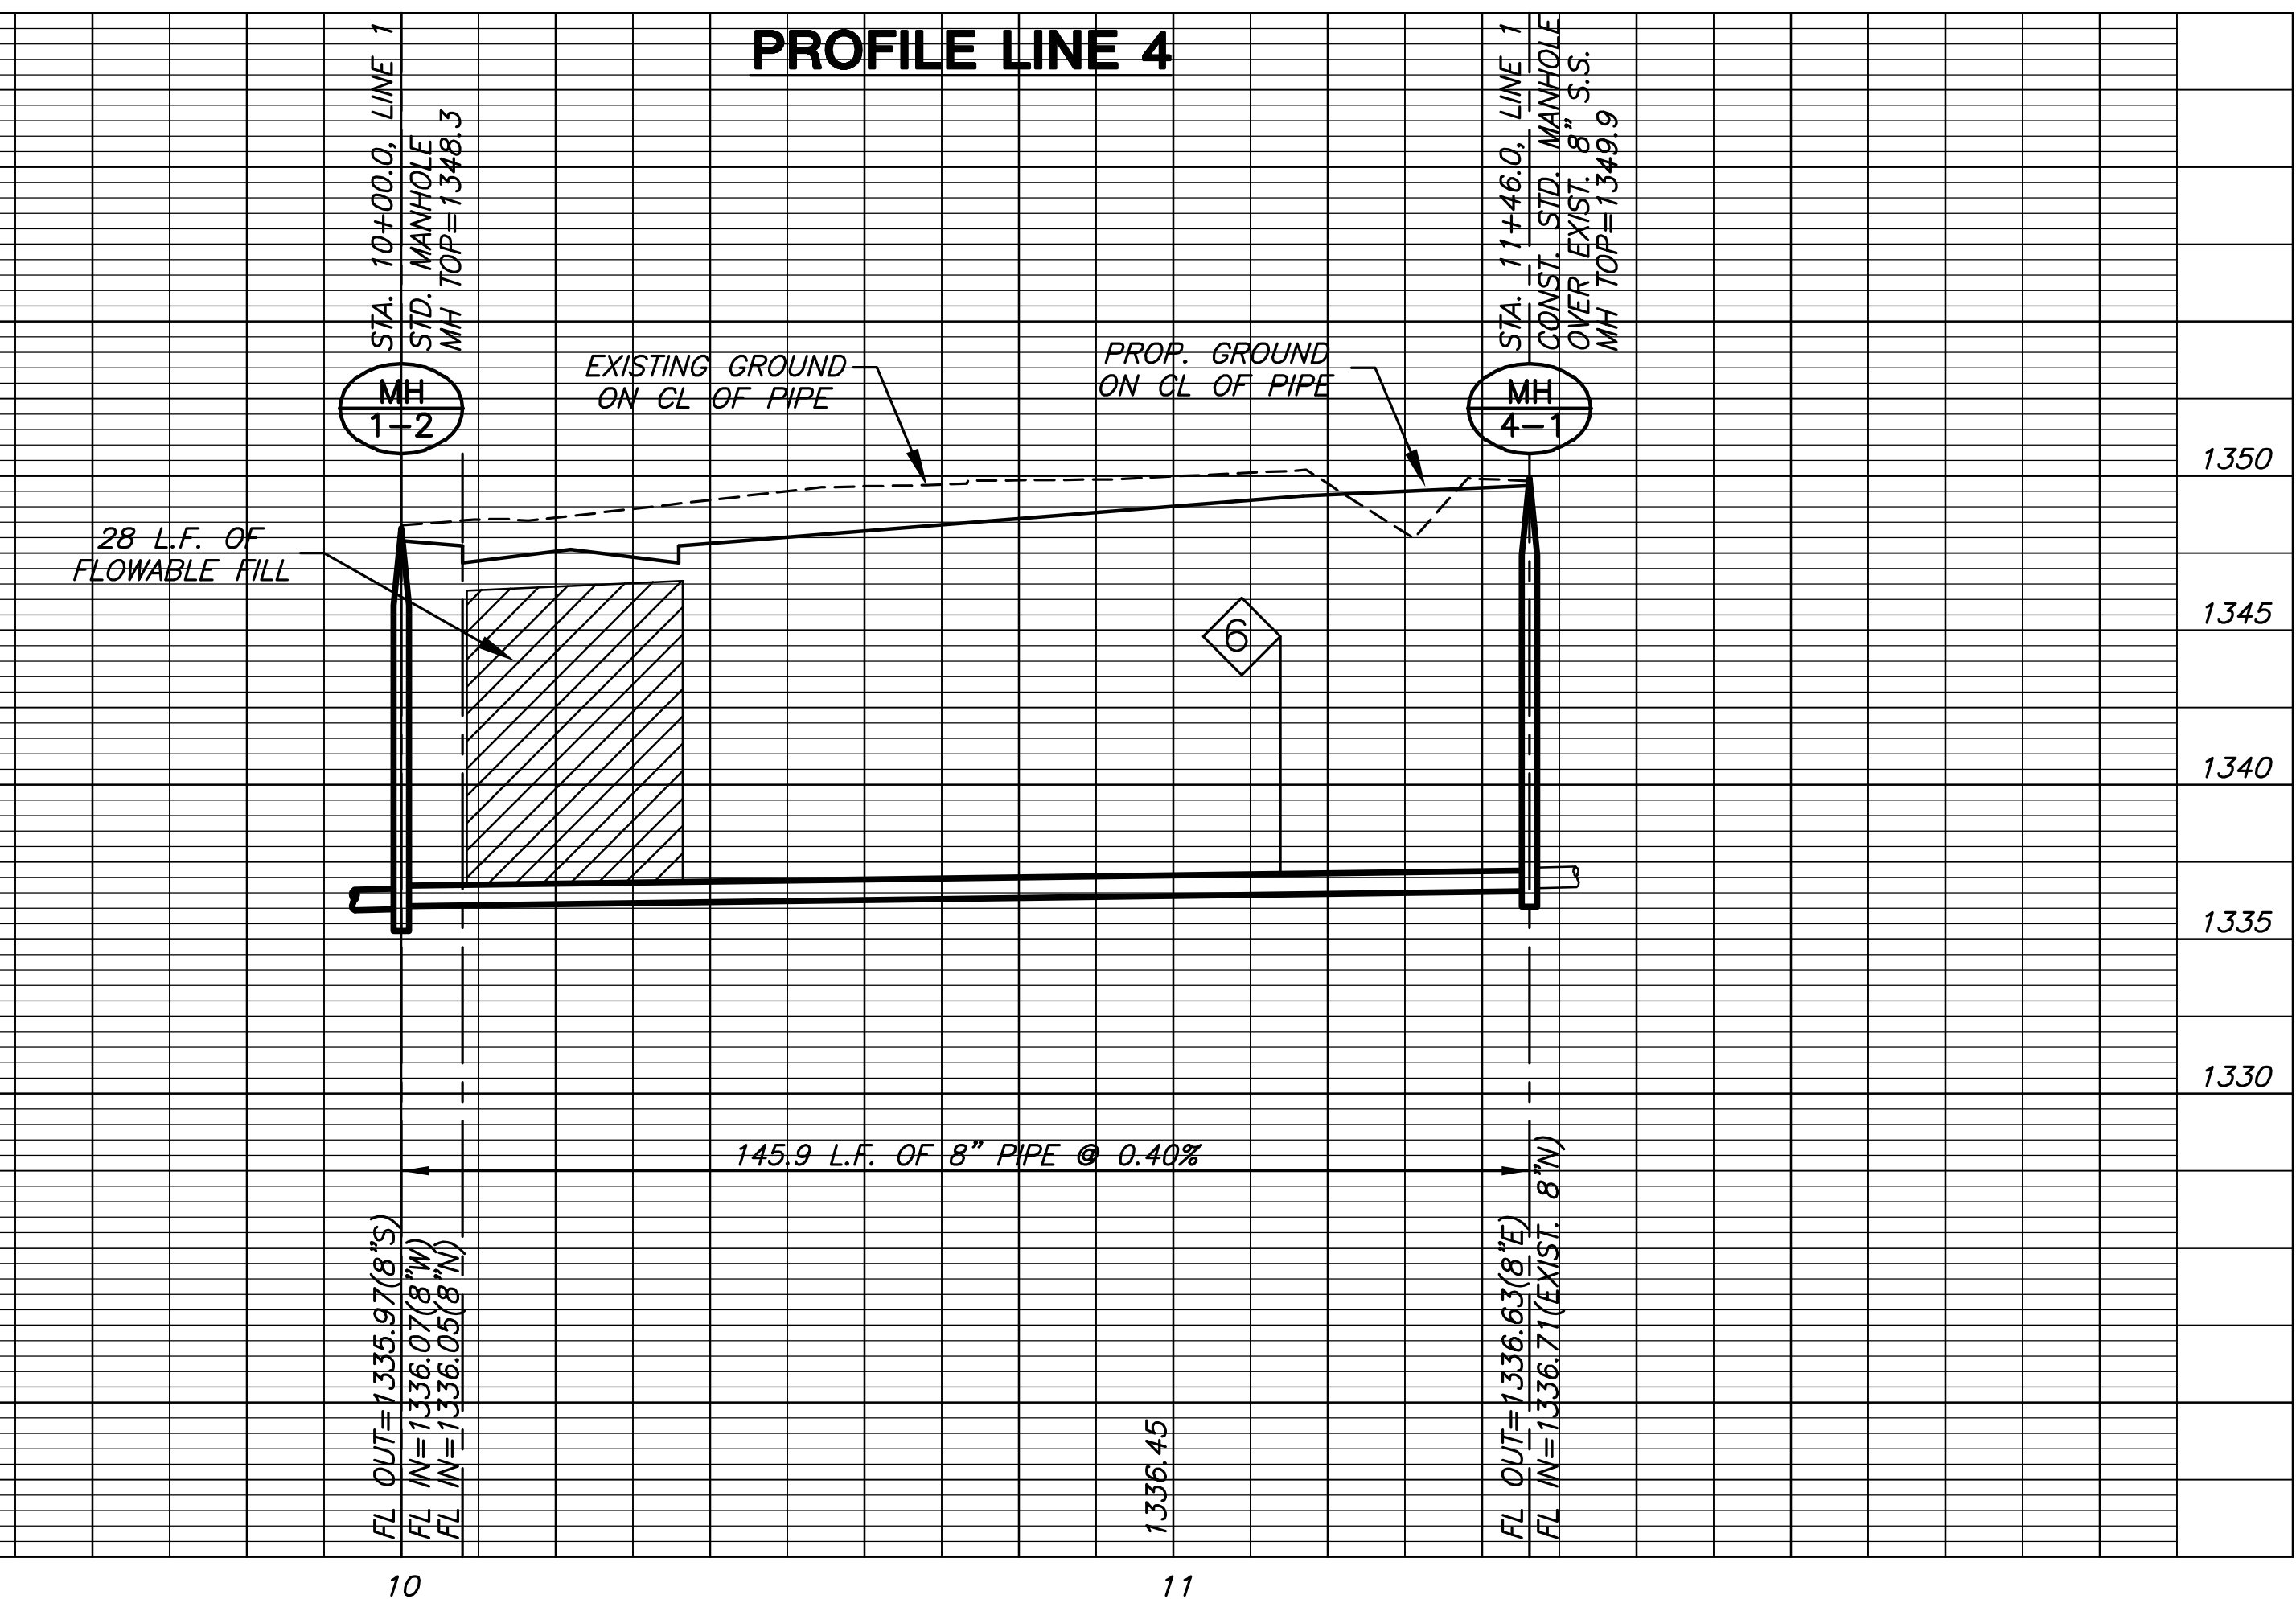

= SANITARY TO BE ABANDONED IN PLACE

**SANITARY SEWER PLANS**  
**CEDAR VIEW VILLAGE**  
**PHASE 1**

**LINES 3 & 4**  
SHEET TITLE  
06189  
PROJECT NUMBER

SRS  
DESIGN BY  
TKL  
DRAWN BY  
MAB  
CHECKED BY

ISSUED  
July 2008  
REVISED  
7-30-08

SHEET NO.  
6 of 16

PLOTTED: Wednesday, July 30, 2008 @ 08:37 AM

J:\CIVIL\06189\WORK\SAN\06189\_B3.DWG