
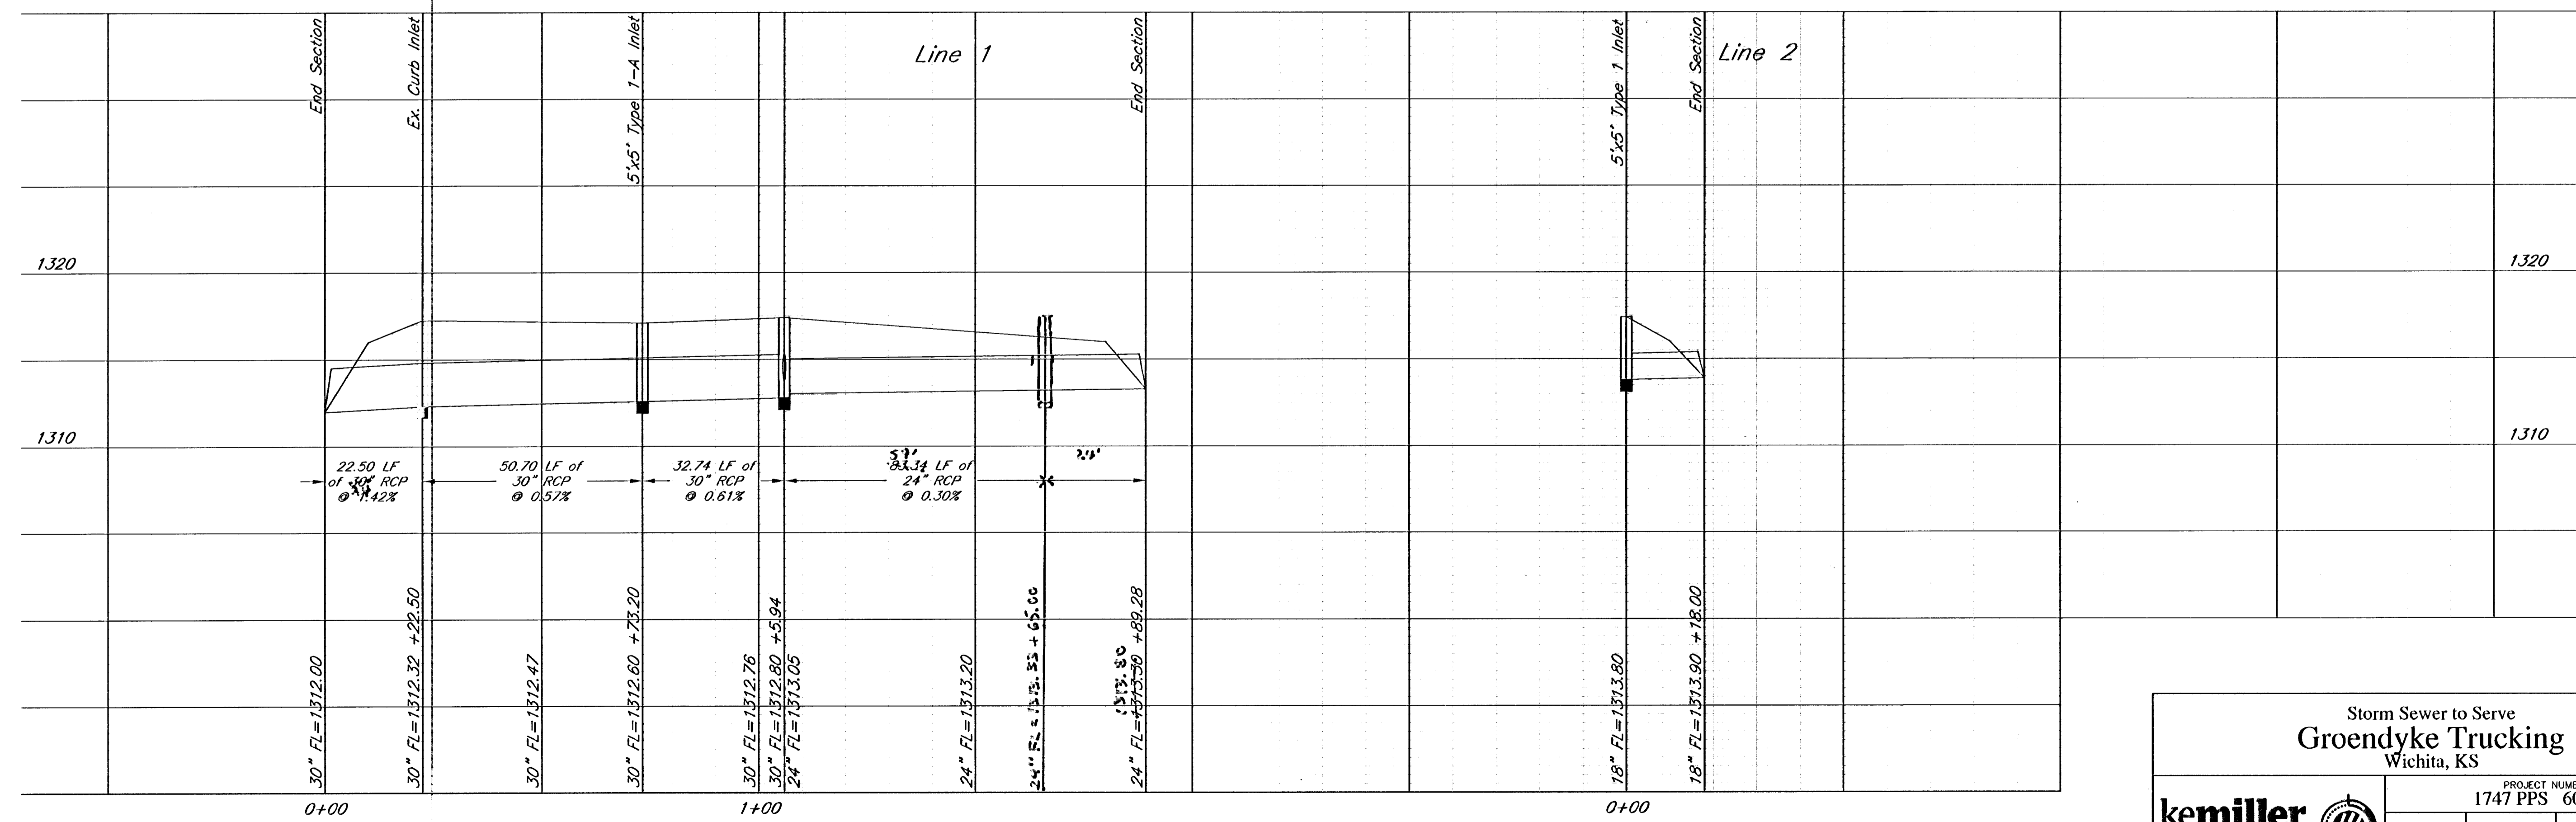


Baseline
 Intersection of Ohio and Quarter
 Section Line, being Sta. 10+00.

Benchmark:
 Rail Road Spike in Hubguard
 SW Corner of RCBC under Ohio
 St. 75' N. of 29th St. N.
 Elev. = 1317.01

On Site BM: "□" on Top of Curb
 at S. End of Catch Basin E. Side
 of Ohio at S. Curb Return.
 Elev. = 1316.75

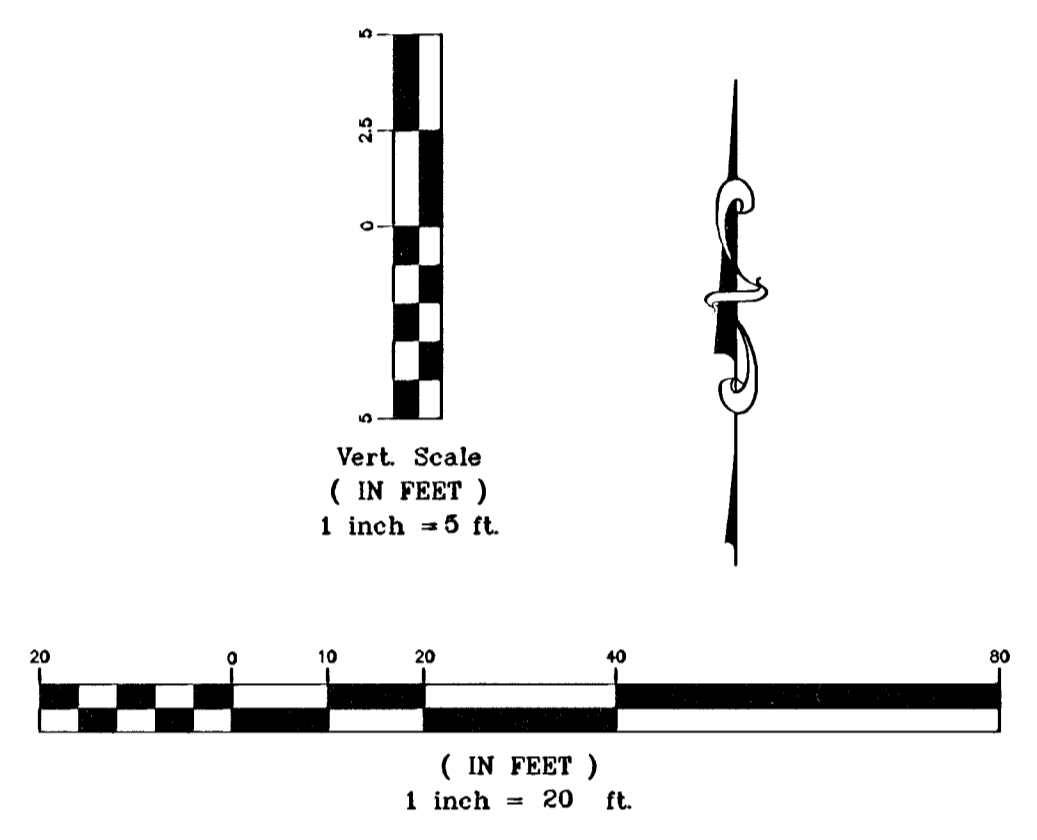

**Storm Sewer to Serve
 Groendyke Trucking
 Wichita, KS**

kemiller engineering	PROJECT NUMBER 1747 PPS 607861		
	KEM NO. 06177	FILE pps	DATE 2/07
DESIGN PB	DRAWN JO	REVISED 2/20/07	SHEET 2 OF 5

518 S. Market, Wichita, KS 67202 316/264-0242