



LINE NO. 1

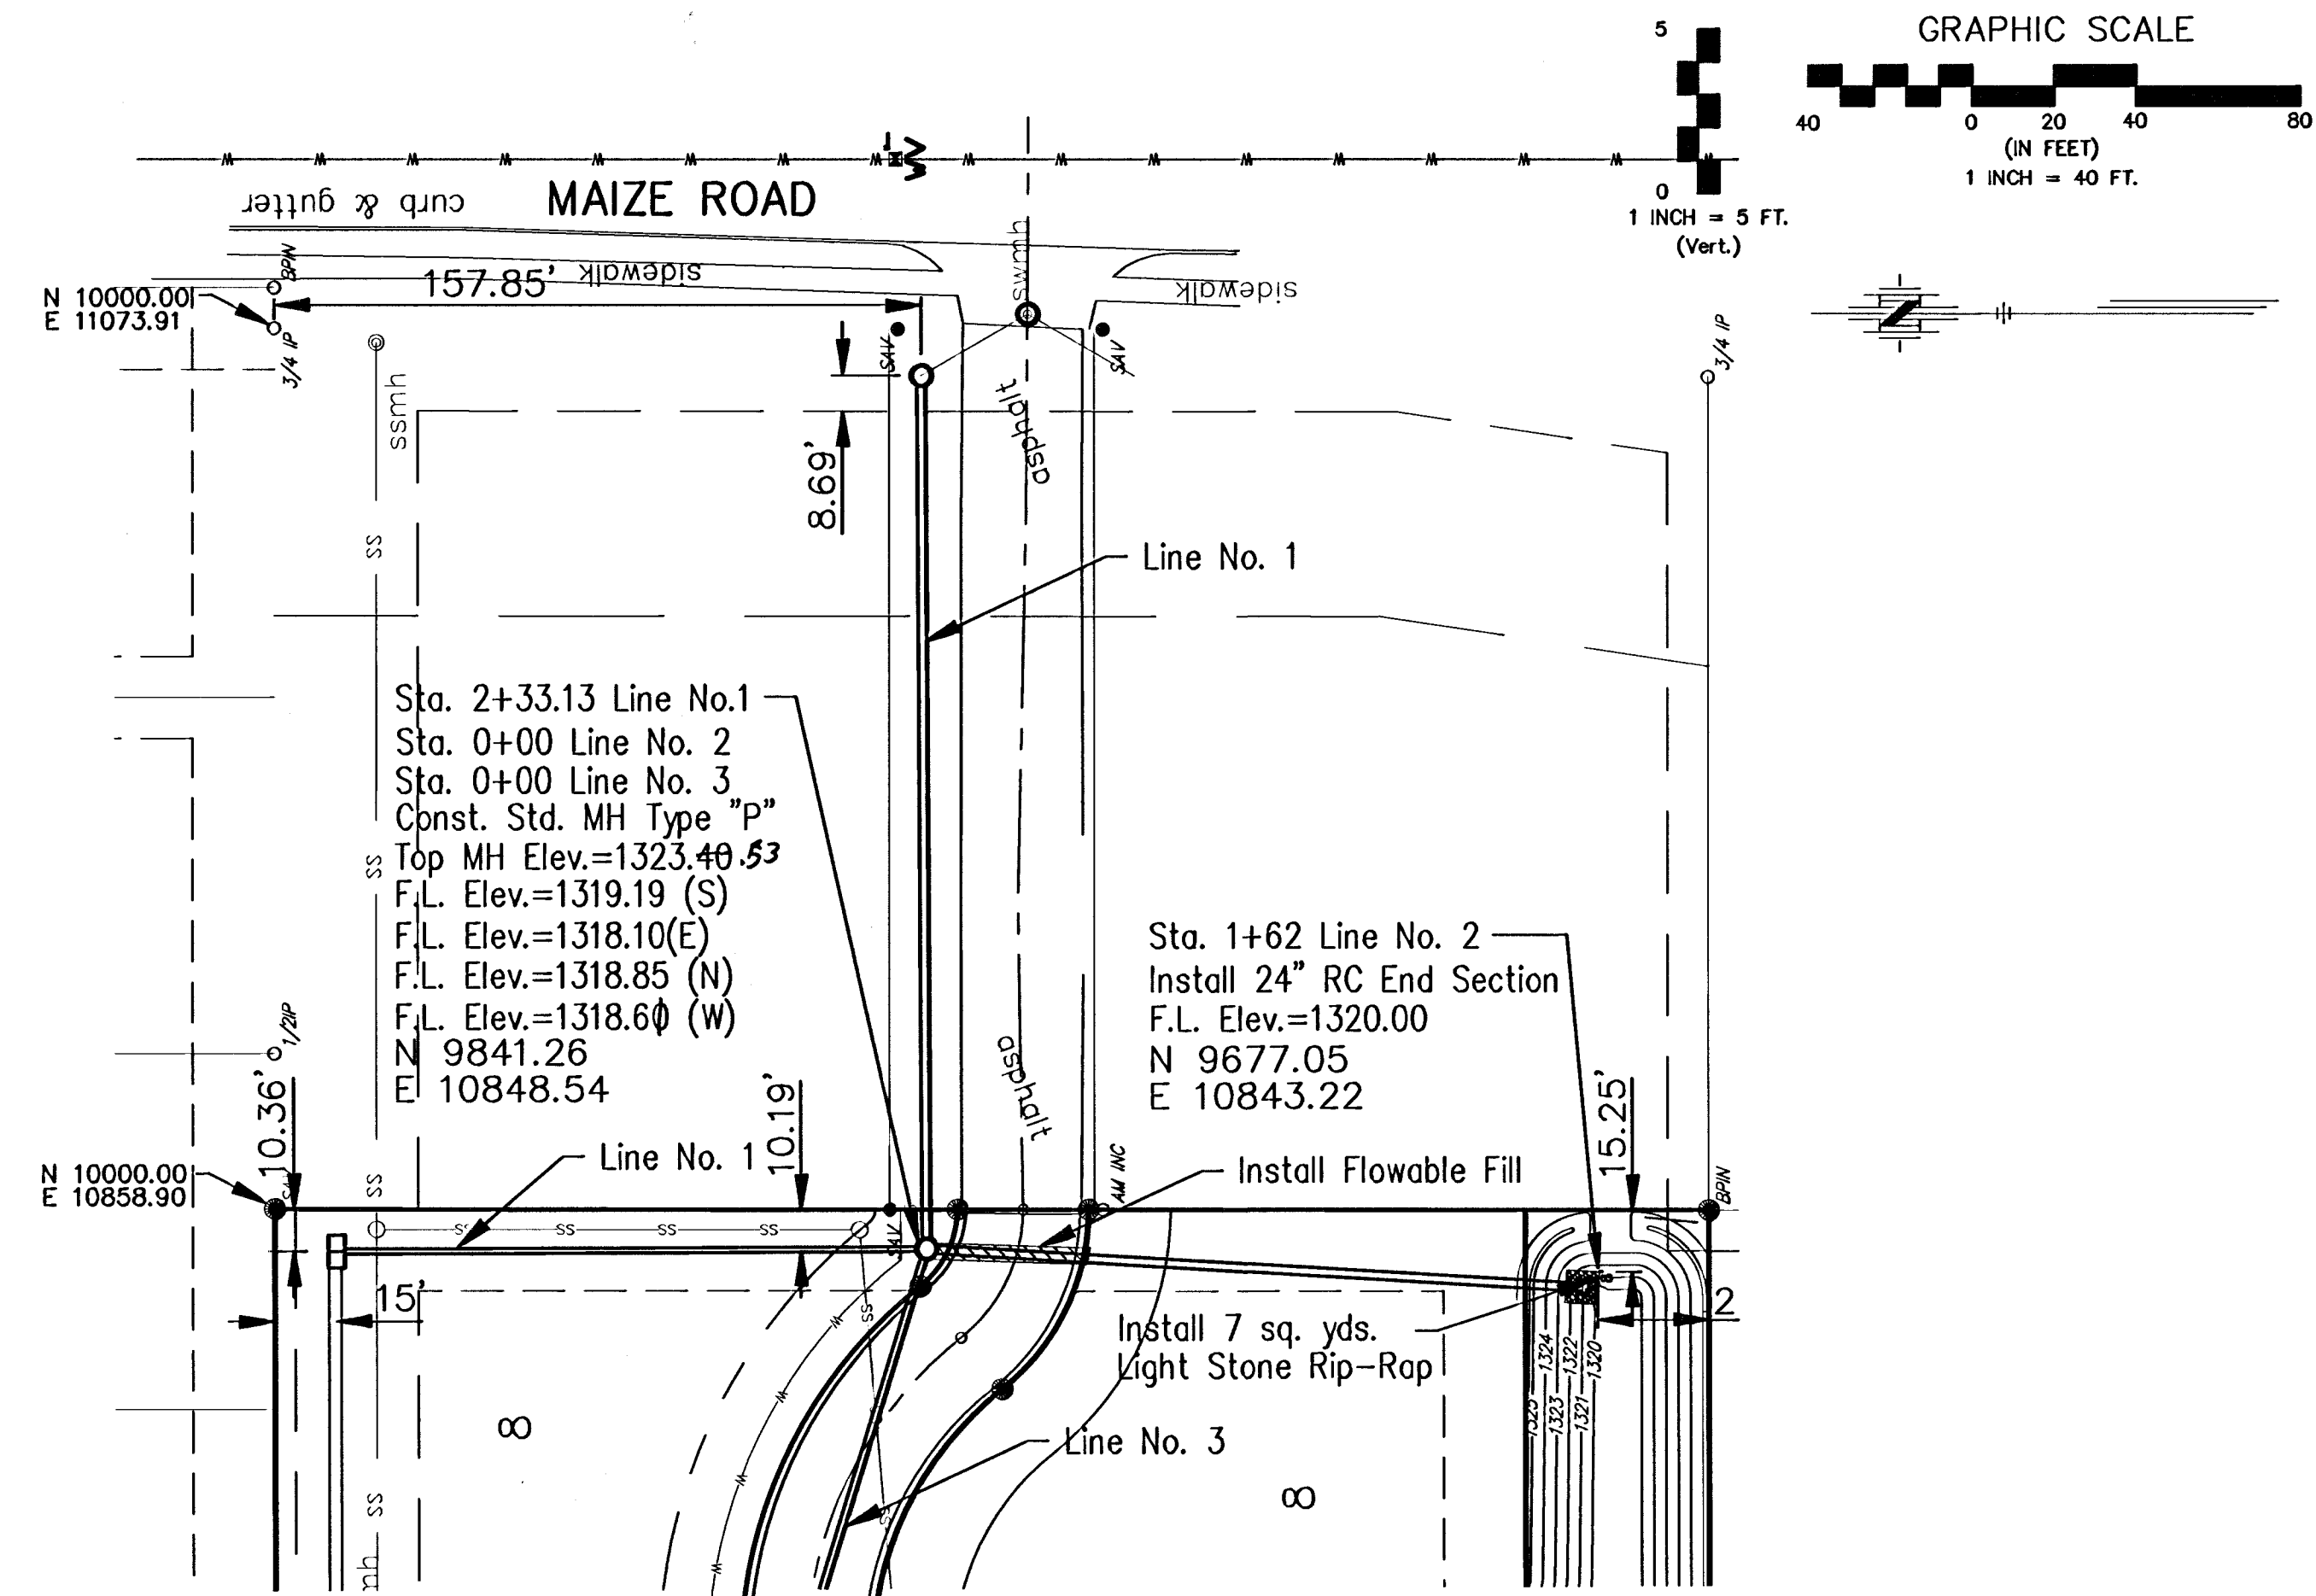

LINE NO. 2

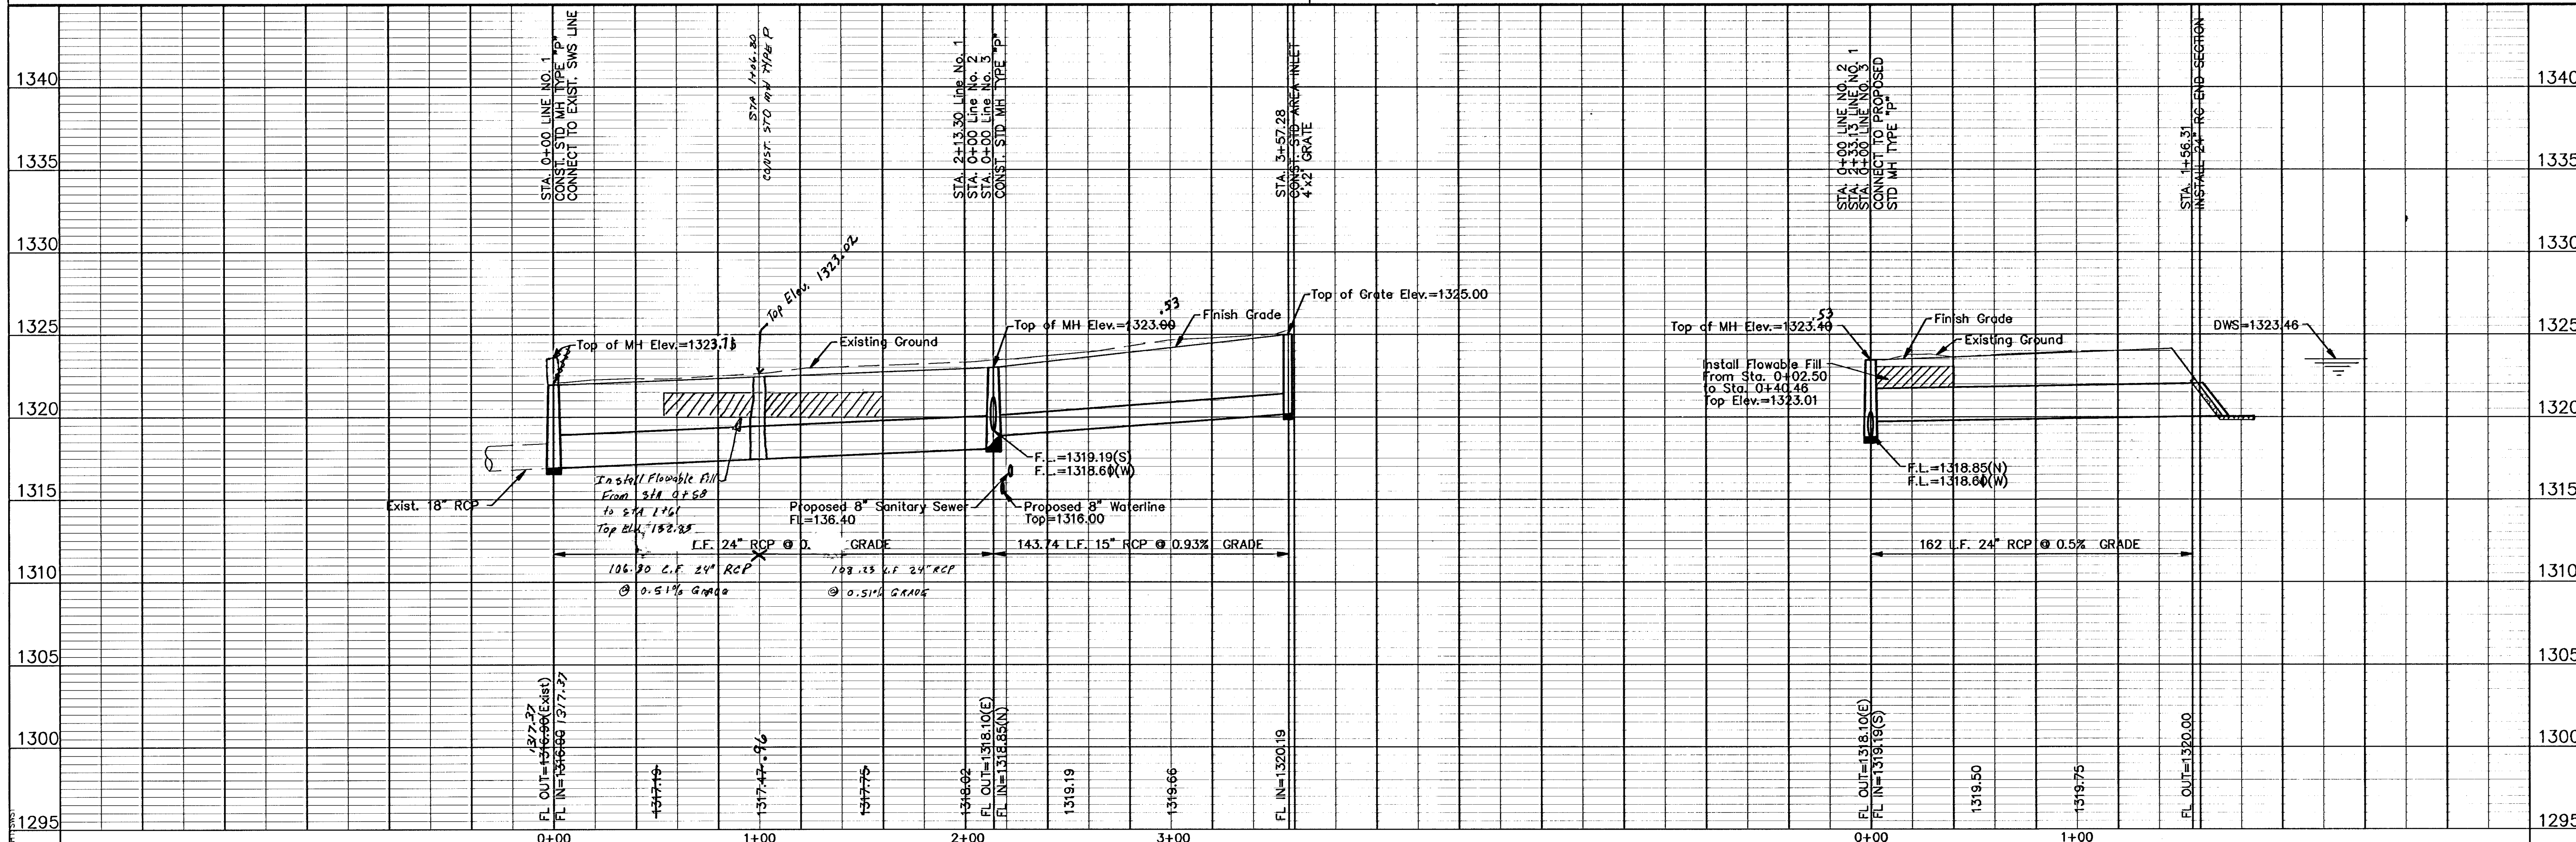

GRAPHIC SCALE
1 INCH = 40 FT.
1 INCH = 5 FT. (Vert.)

No.	Date	By	Approved	Reason

OAK CLIFF ESTATES 6TH ADDITION
STORM SEWER IMPROVEMENTS
SEWER LINES NO. 1 & 2
CITY OF WICHITA, KANSAS
JAMES ARMOUR, P.E. - CITY ENGINEER
1687 FPS (607879)

POE & ASSOCIATES, INC.
CONSULTING ENGINEERS
5940 E. Central, Suite 200 ■ Wichita, KS 67208-4242
Phone 316.685-4114 ■ FAX 316.685-4444

FINAL

Designed By: T. Austin/S. Schmidt
Drawn By: S. Schmidt
Poe Job No.: 1821/Oak Cliff/Dese-sws.dwg
Date: 09/06/06

2 of 12