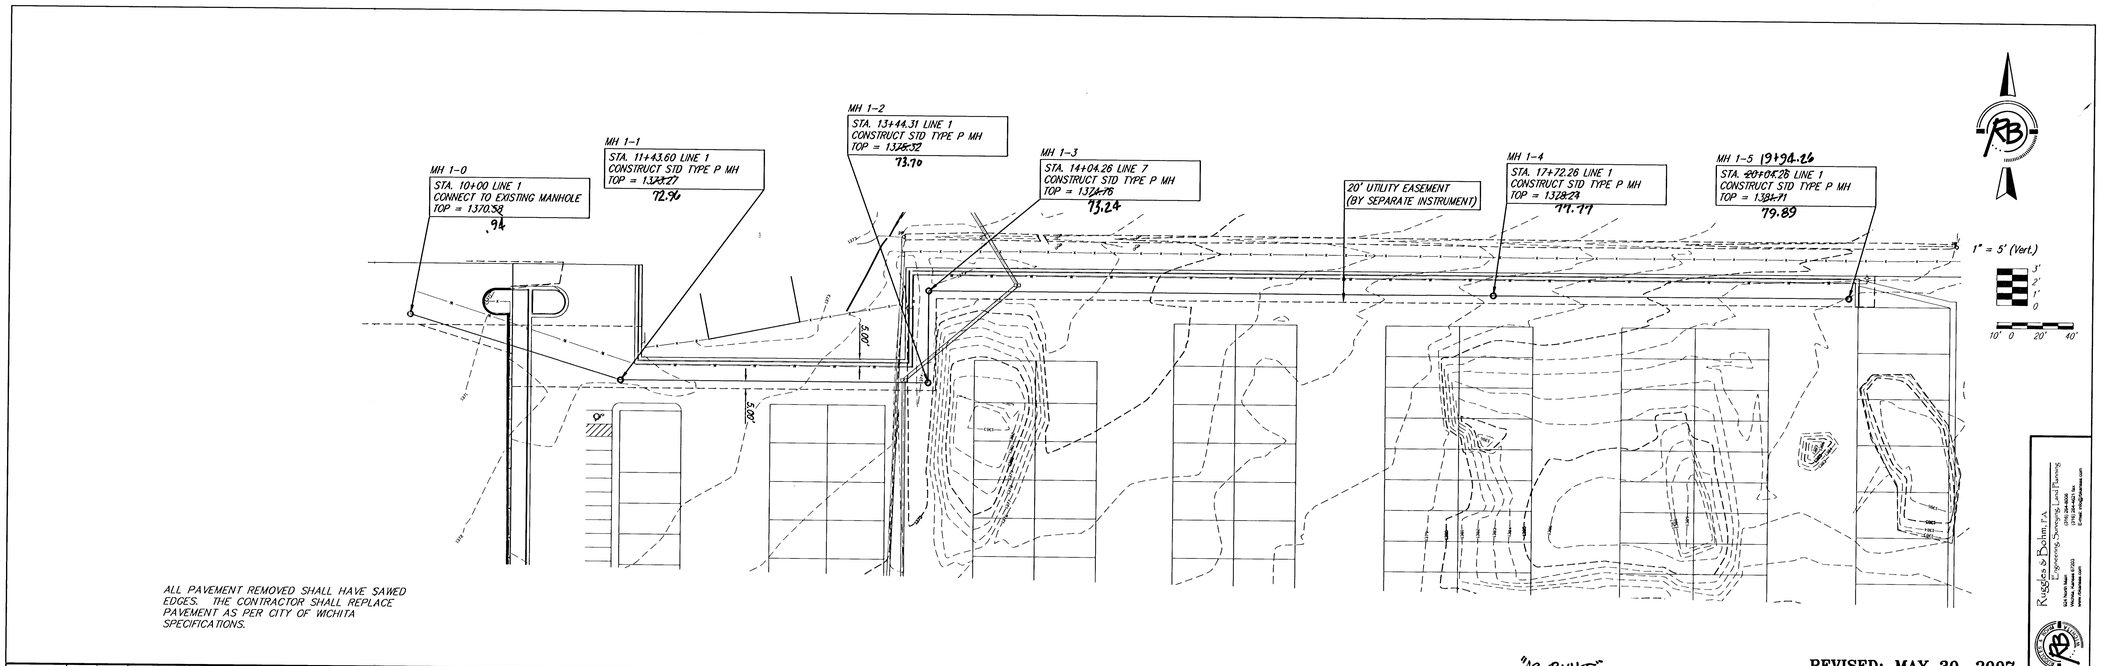

ALL PAVEMENT REMOVED SHALL HAVE SAWED EDGES. THE CONTRACTOR SHALL REPLACE PAVEMENT AS PER CITY OF WICHITA SPECIFICATIONS.

"AS BUILT"
RdB
TE
8-8-07

REVISED: MAY 30, 2007

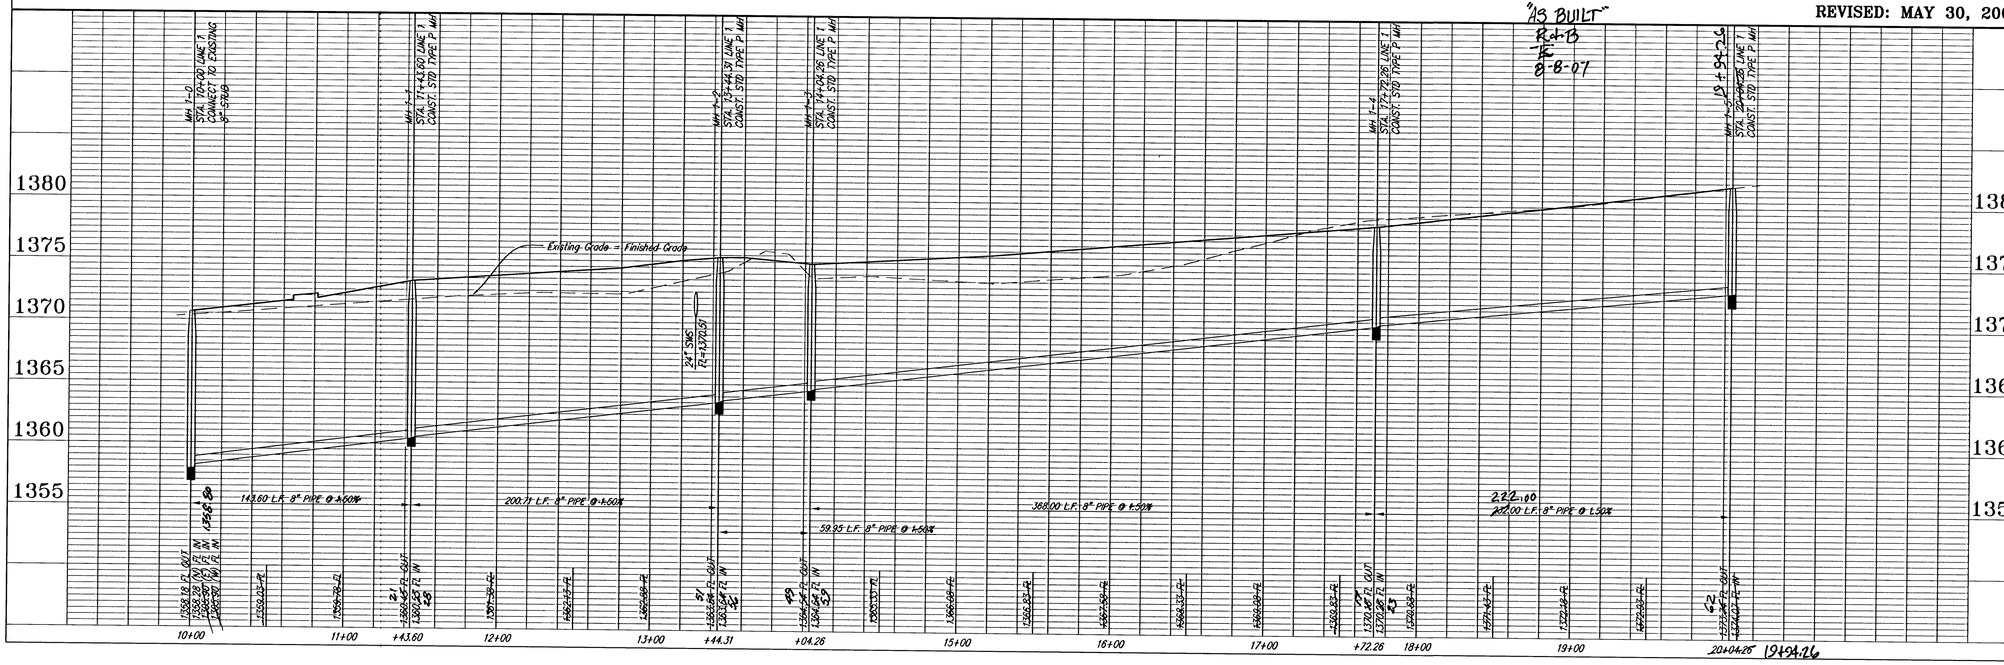

Ruggles & Bohm, P.A.
Engineering, Surveying & Land Planning
(316) 264-6600
(316) 264-1589
Email: info@rbks.com
www.rbks.com

DESIGN	PDC
DRAWN	PDC
CHECKED	
DATE	4/16/07
UTILITY	
REVISED	
REVIEW	
PROJECT NUMBER	1771
DRAWING FILE	Engg Base

SANITARY SEWER LATERALS
Exec-U-Stor
Wichita, KS

PB JOB 2996E
SHEET 4 of 4