
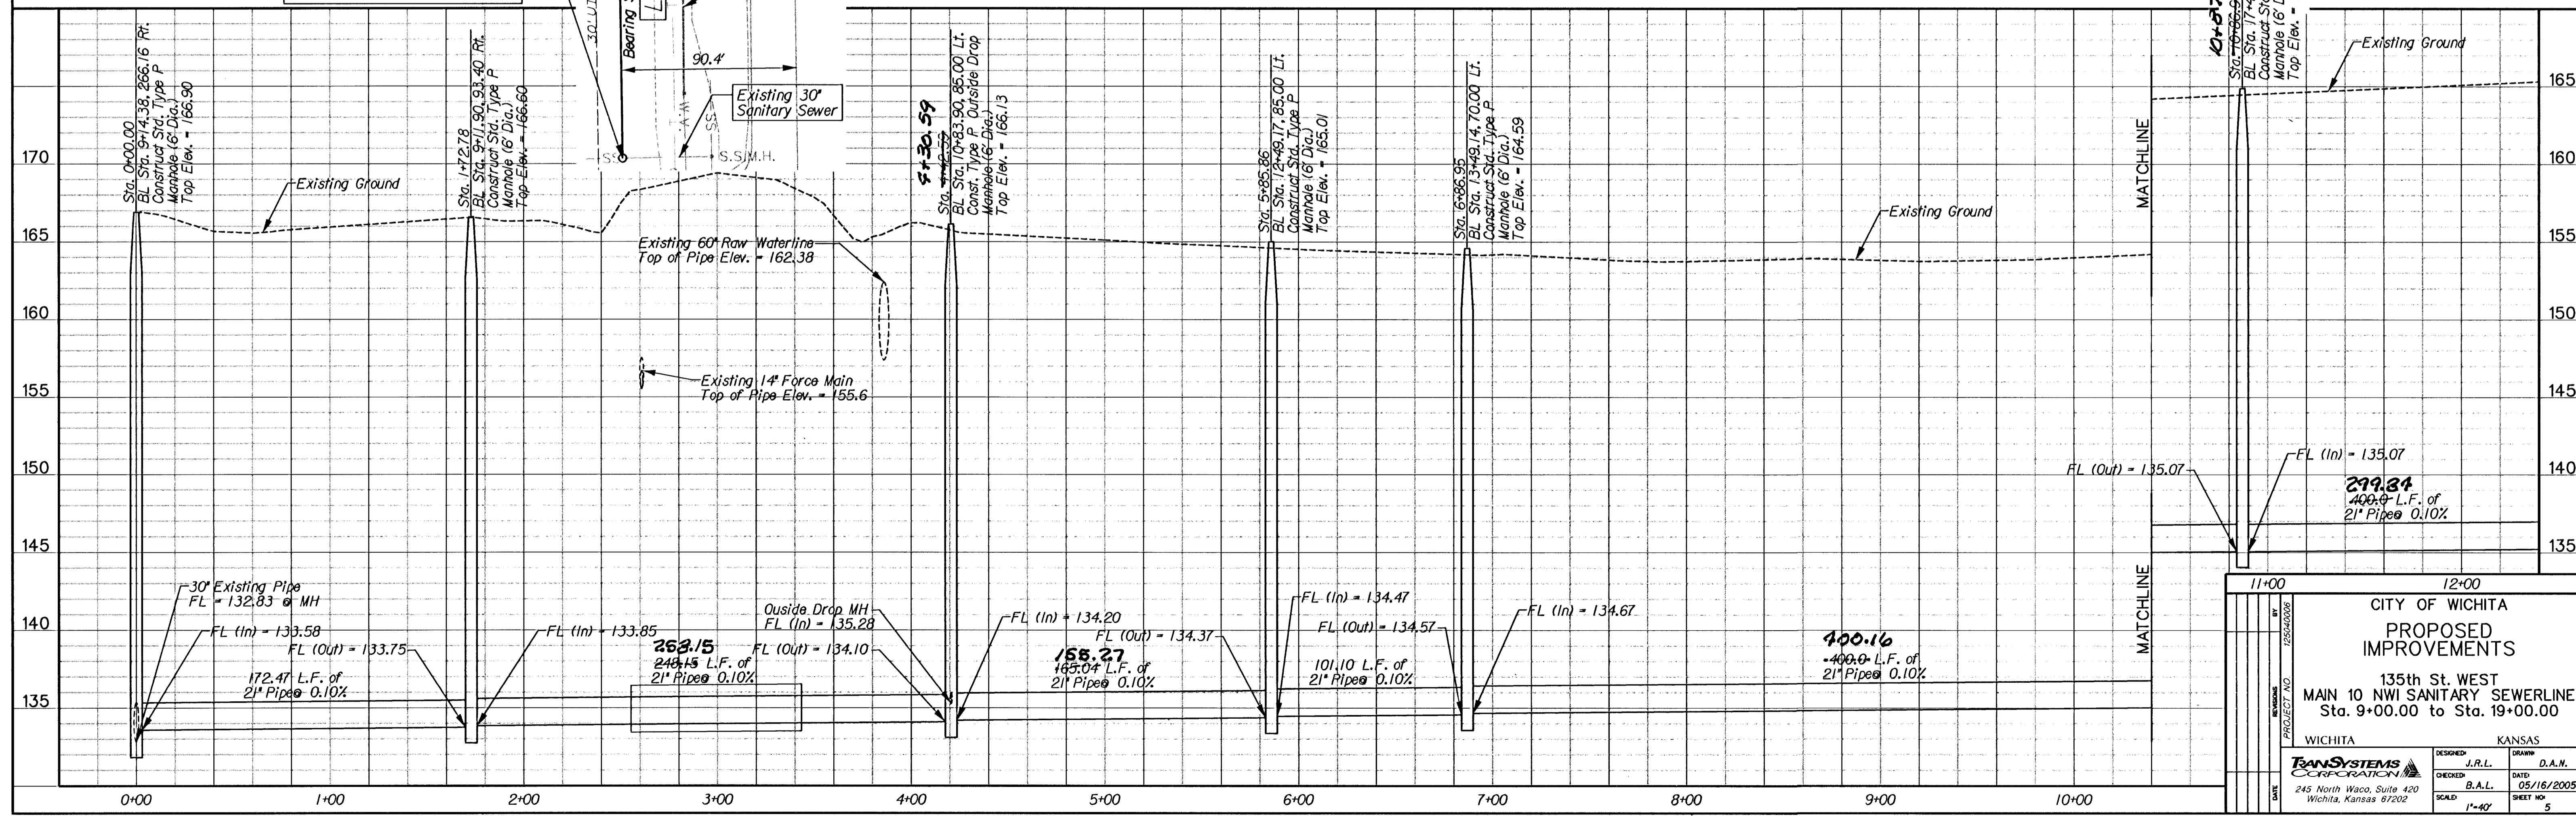


City of Wichita Bench Mark  
135th St. W. and 21st St. N  
SW Corner Intersection  
49.00' S. of Center Line of 21st St.  
43.00' W. of Center Line of 135th St.  
65.50' SW of Section Corner Iron  
11.60' N. of Chain Link Fence  
27.60' W. of Back of Curb  
City Elev. = 169.19

Scale  
Horizontal 1" = 40'

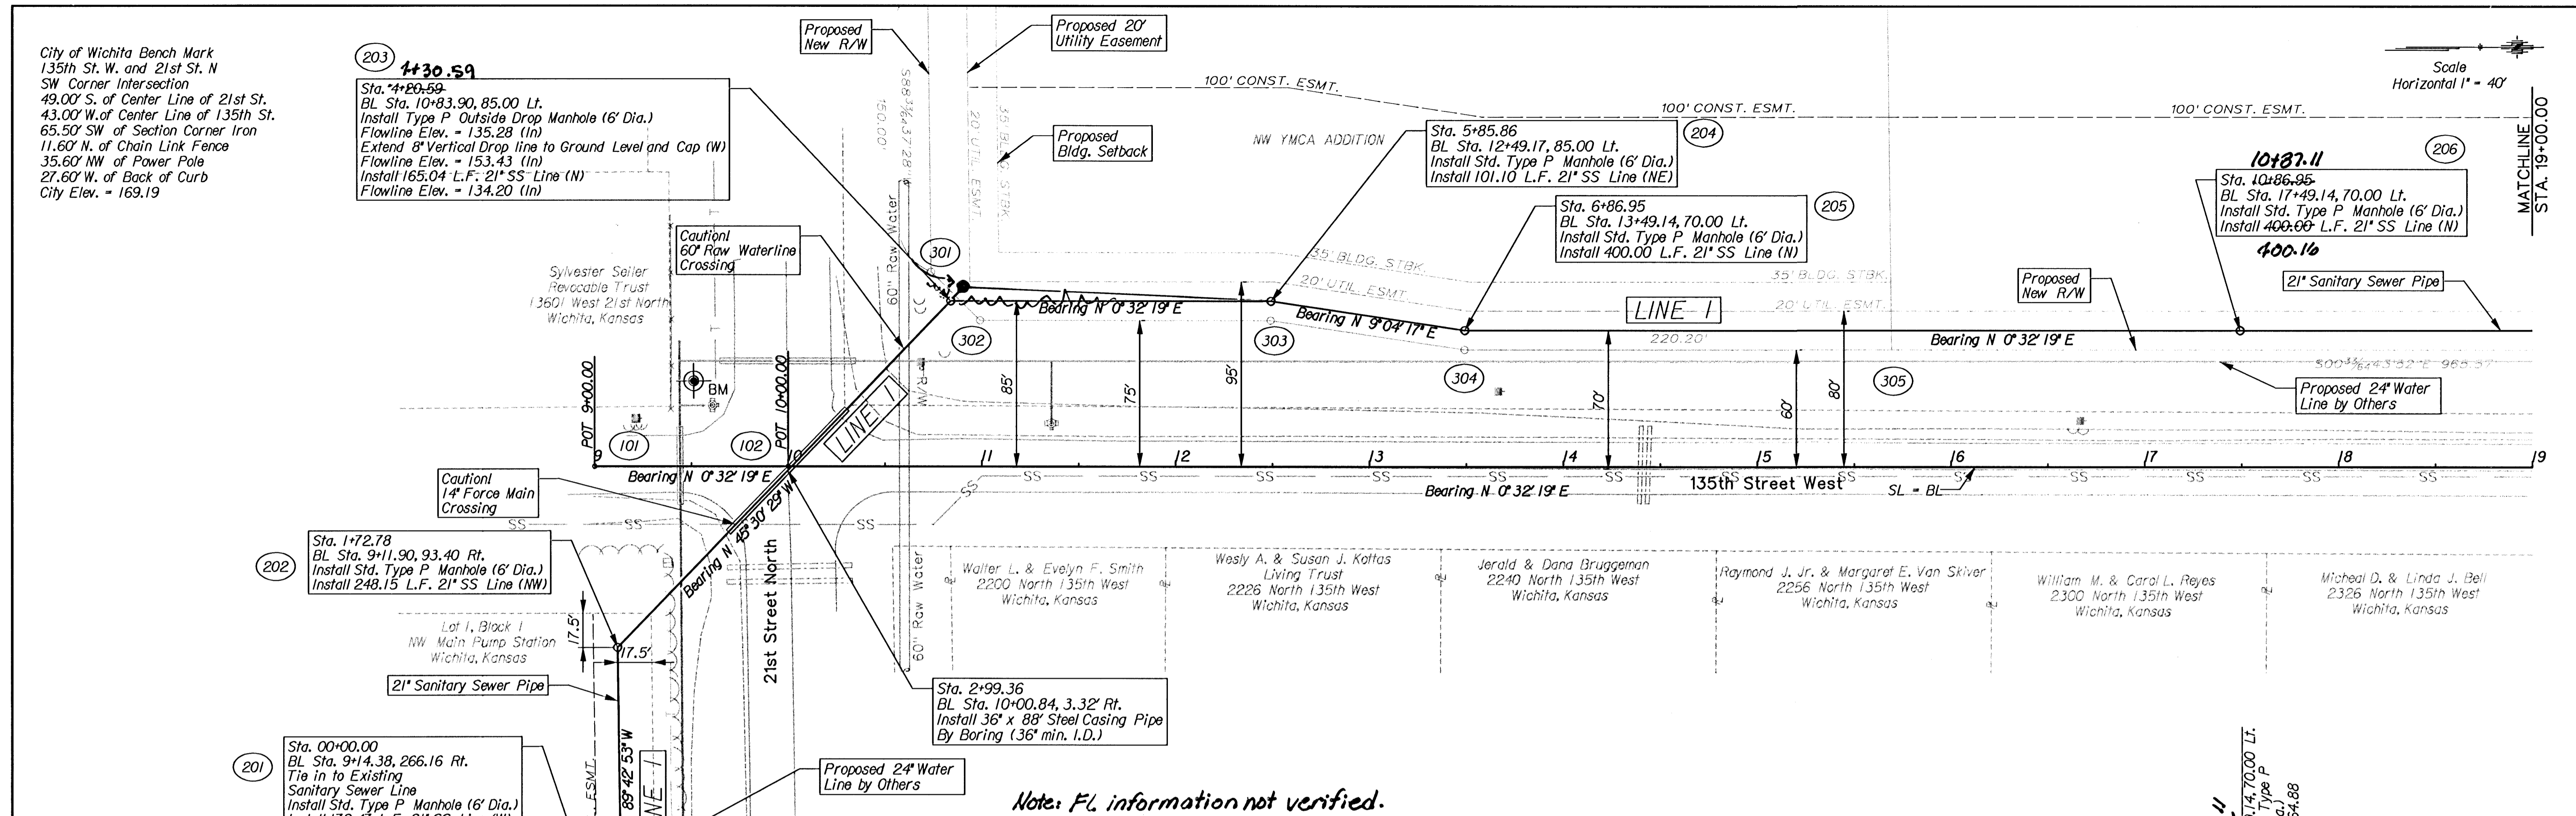

Note: FL information not verified.

CITY OF WICHITA	
PROPOSED IMPROVEMENTS	
135th St. WEST MAIN 10 NW SANITARY SEWERLINE Sta. 9+00.00 to Sta. 19+00.00	
WICHITA	KANSAS
DESIGNED: J.R.L.	DRAWN: D.A.N.
CHECKED: B.A.L.	DATE: 05/16/2005
SCALE: 1"=40'	SHEET NO: 5

9:\w04\0006\reod\pp01.sht  
05/16/2005 10:35:24 AM