


Scale
Horizontal 1" = 40'

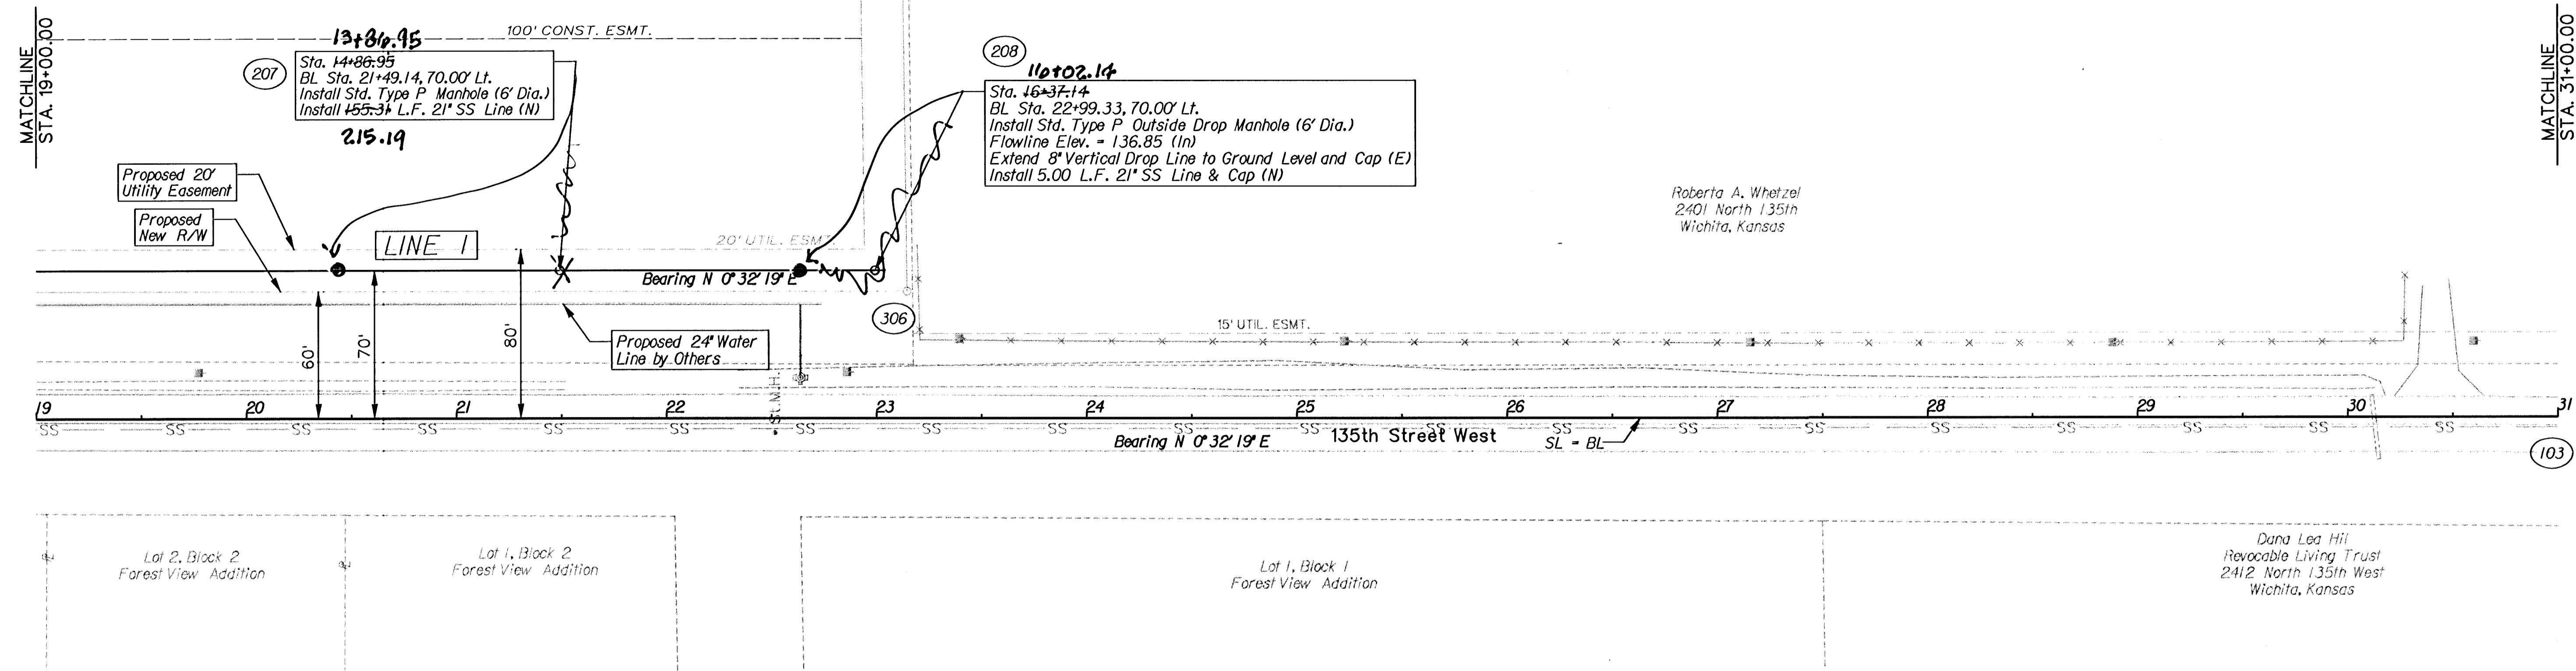

Roberta A. Whetzel
2401 North 135th
Wichita, Kansas

Lot 2, Block 2
Forest View Addition


Lot 1, Block 2
Forest View Addition

Lot 1, Block 1
Forest View Addition

Dana Lea Hill
Revocable Living Trust
2412 North 135th West
Wichita, Kansas

Note: FL information not verified.

Note:
No Construction Activities are allowed
on Private Property without a Construction
Easement.

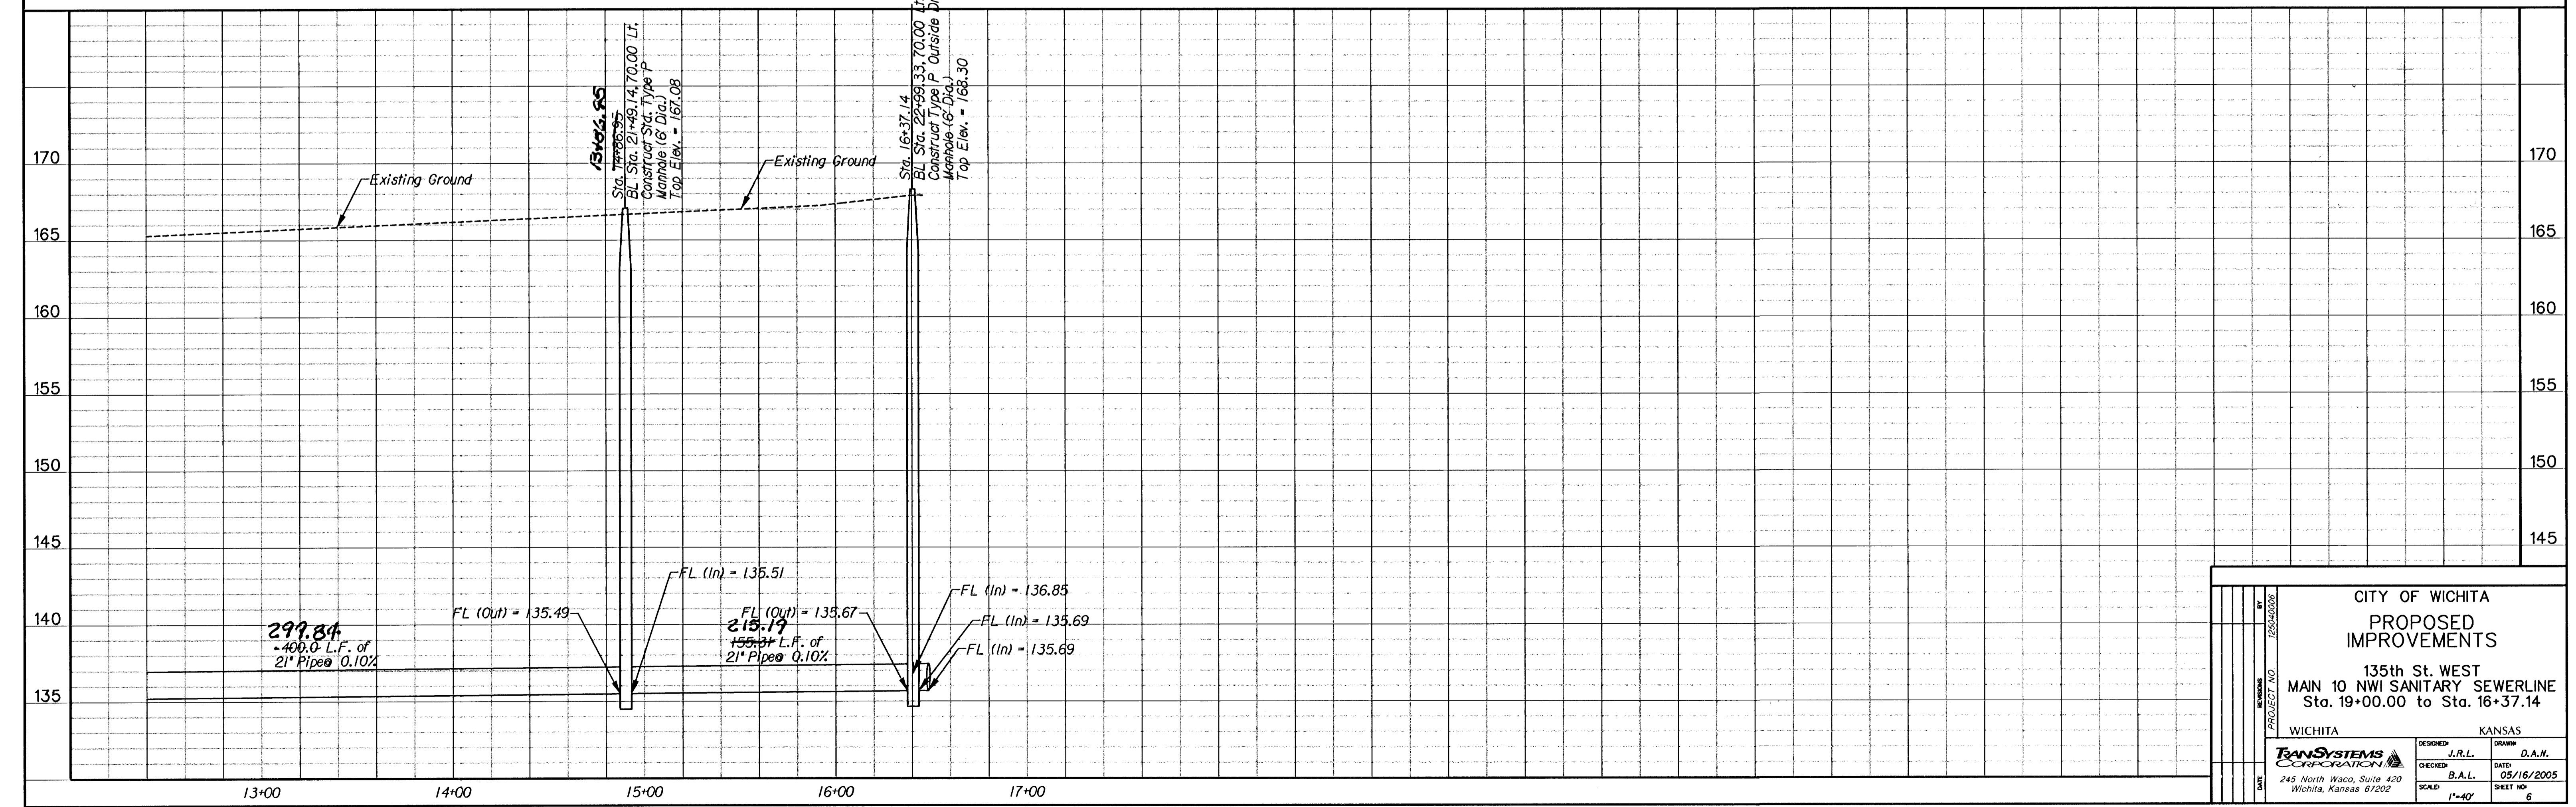

CITY OF WICHITA		PROPOSED IMPROVEMENTS	
135th St. WEST MAIN 10 NWI SANITARY SEWERLINE Sta. 19+00.00 to Sta. 16+37.14			
WICHITA		KANSAS	
DESIGNED J.R.L.	DRAWN D.A.W.	CHECKED B.A.L.	DATE 05/16/2005

g:\104\10006\road\pp02.sht
05/16/2005 10:35:25 AM