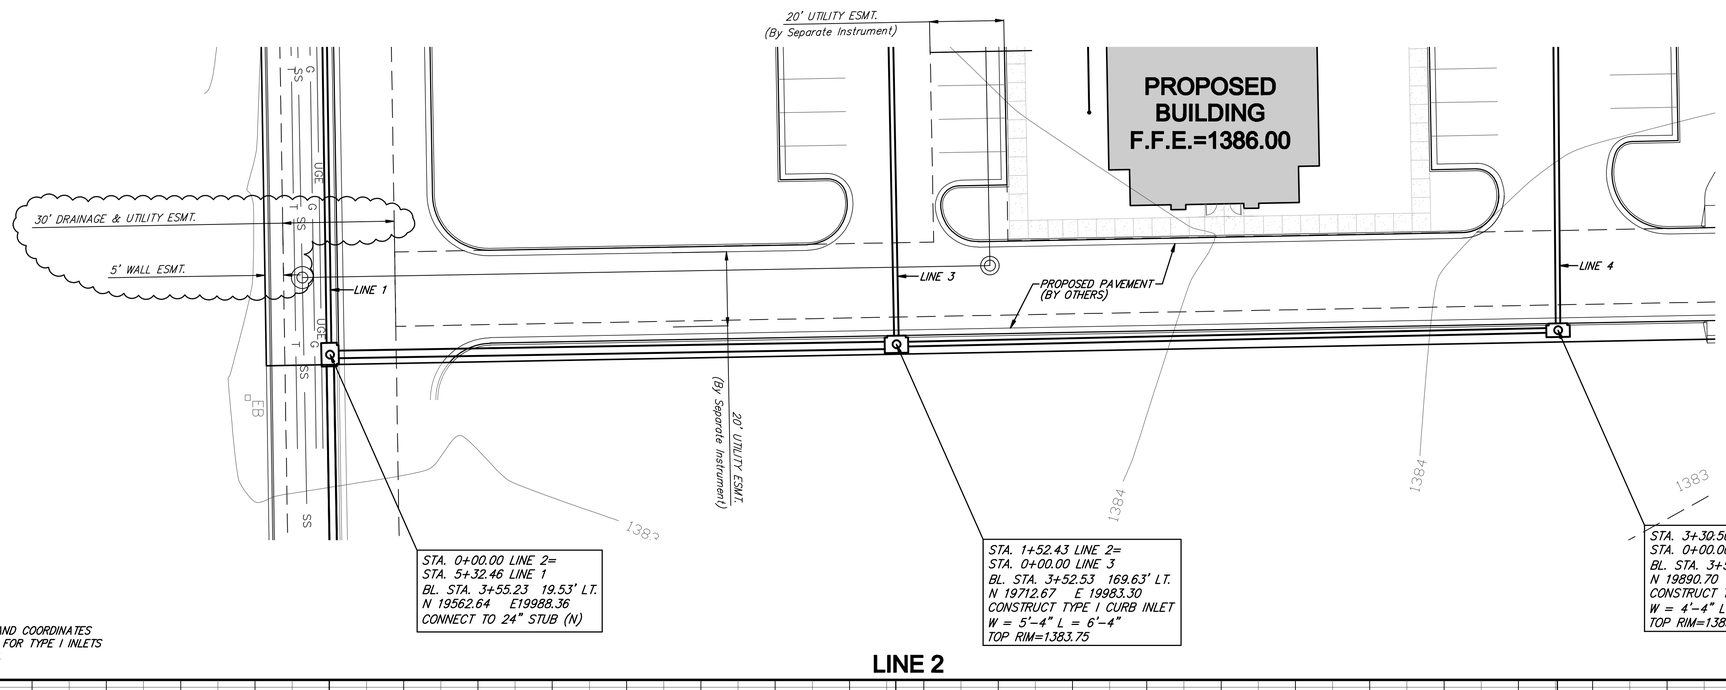

NOTE: BASELINE STATIONS AND COORDINATES ARE TO FRONT INSIDE FACE FOR TYPE I INLETS AND CENTER OF 2x2 INLETS.

LINE 2

REVISED 7/22/08

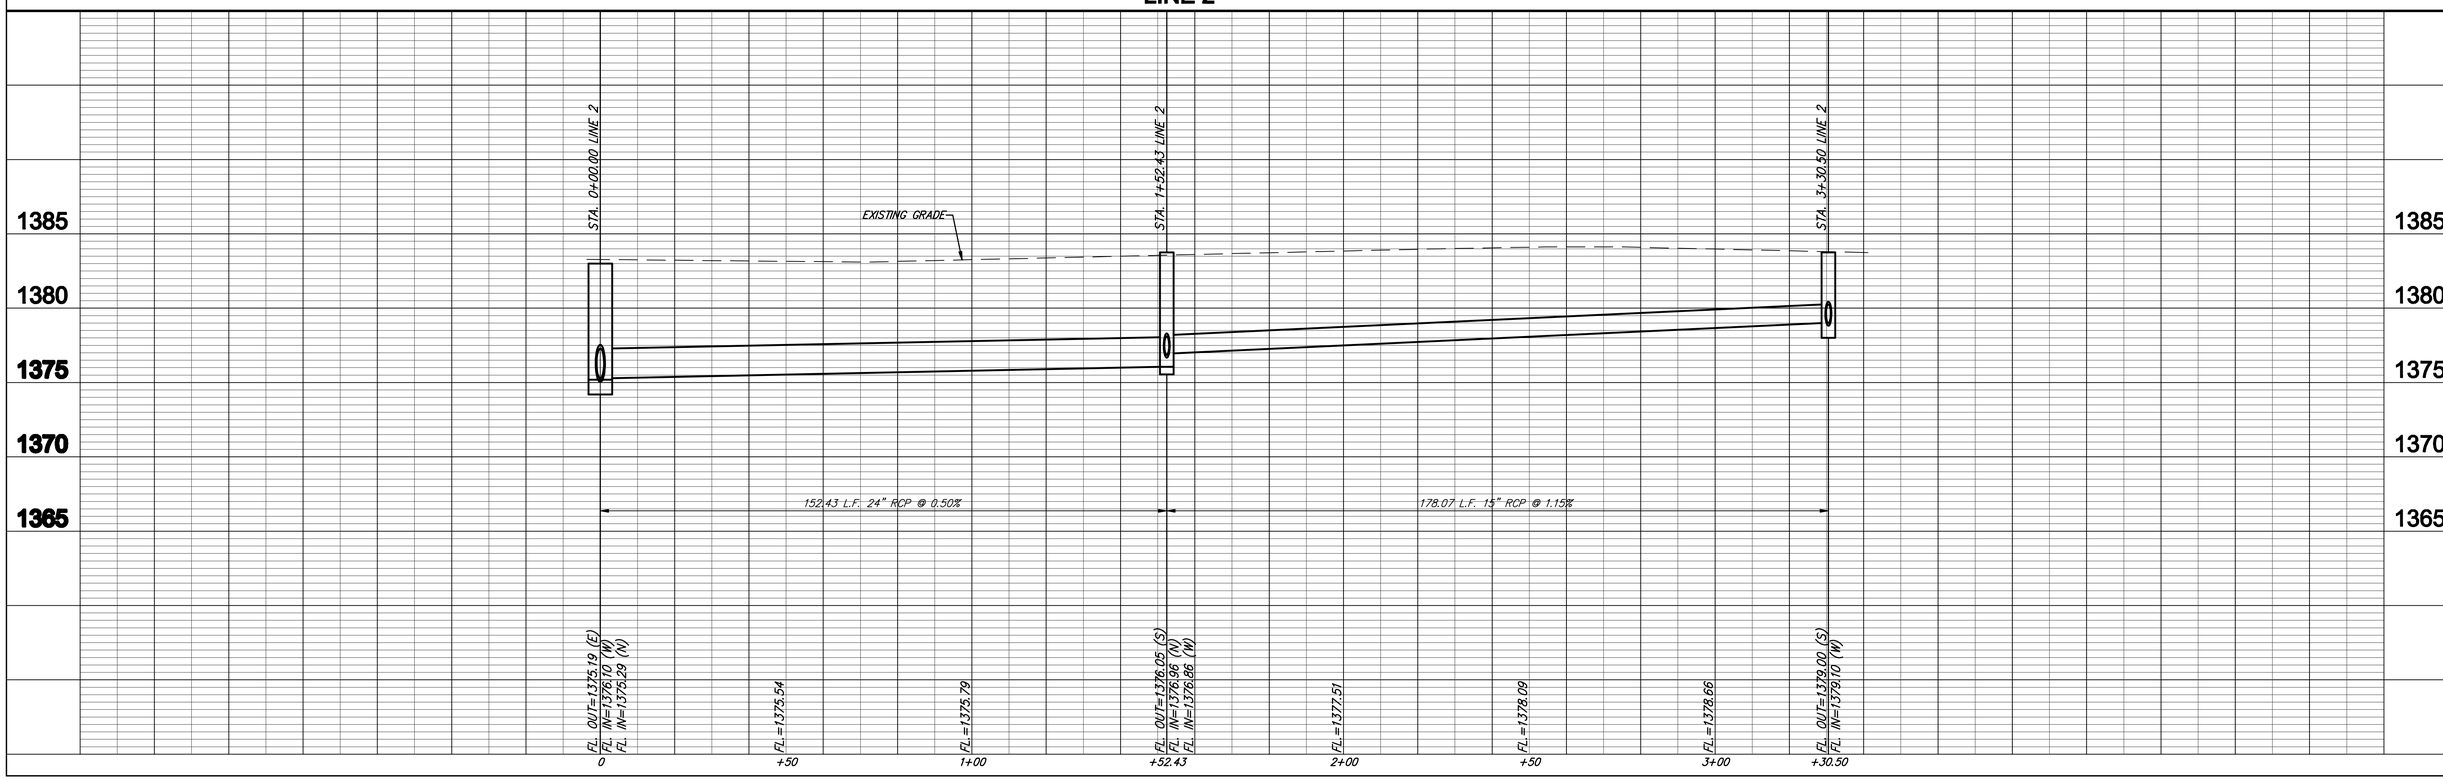

Rieger & Boehm, P.A.
Engineering Surveying Land Planning
Wichita, Kansas
Phone: 316-263-5691
Fax: 316-263-5696

DESIGNED TCR
DRAWN JDM
DATE June 19, 2007

PROJECT NUMBER Proj. No. 1787
PFS 02/2007
SHEET TITLE Storm Sewer (SWS Line 2)

SPRING HILL SUITES, GATEWAY CENTER
LINE 1 & 4 STORM SEWER
WICHITA, KANSAS

3064E

9 of 9