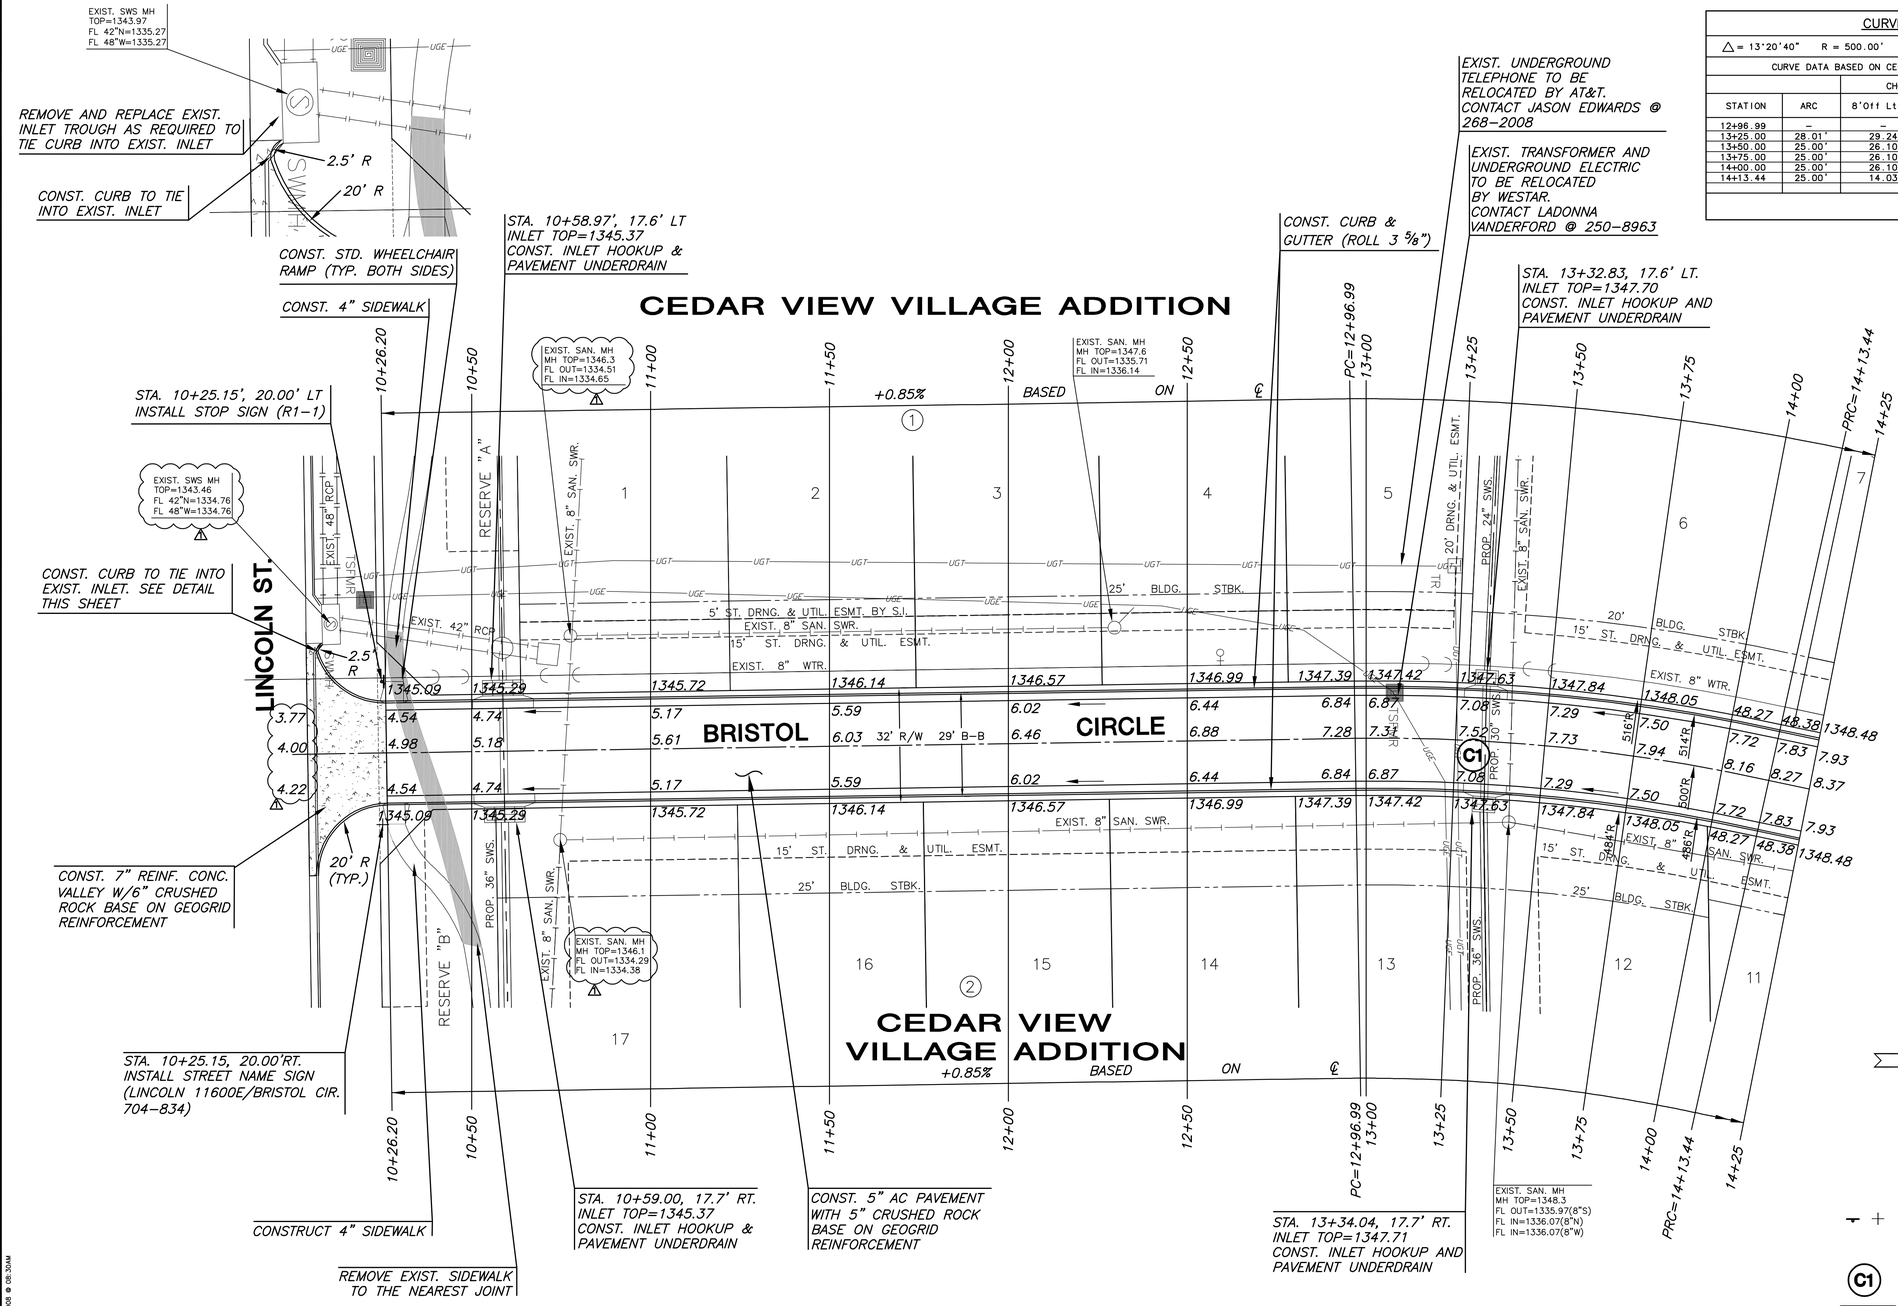

CURVE TABLE – C1					
△ = 13°20'40" R = 500.00' T = 58.49' L = 116.45' LC = 116.19'					
CURVE DATA BASED ON CENTERLINE △ /2 = 06°40'20"					
		CHORD LENGTH			
STATION	ARC	8'Off LtCb	8'Off RtCb	DEFLECTION	TOTAL DEFLECTION
12+96.99	–	–	–	00°00'00"	00°00'00"
13+25.00	28.01'	29.24'	26.77'	01°36'17"	01°36'17"
13+50.00	25.00'	26.10'	23.90'	01°25'57"	03°02'14"
13+75.00	25.00'	26.10'	23.90'	01°25'57"	04°28'11"
14+00.00	25.00'	26.10'	23.90'	01°25'57"	05°54'07"
14+13.44	25.00'	14.03'	12.85'	00°46'13"	06°40'20"
				Def/Ft = 3.43775 Min.	

NOTE: THE PROPOSED STORM SEWER PIPE, STRUCTURES AND RELATED APPURTENCES SHOWN ON THESE DRAWINGS SHALL BE CONSTRUCTED BY OTHERS PRIOR TO PLACEMENT OF PAVEMENT.

LEGEND

- STREET SIGN & SIGN LOCATION (SEE SIGN ASSEMBLY TABLE FOR TYPE & STATION OF SIGN)
- C1 CURVE TABLE REFERENCE
- VALLEY GUTTER
- SIDEWALK REMOVAL

MKEC ENGINEERING CONSULTANTS, INC.
411 N. WEBB ROAD
WICHITA, KS. 67206
316 - 684 - 9600

PAVING PLANS FOR
CEDAR VIEW VILLAGE

BRISTOL CIRCLE PAVING
SHEET TITLE

06189
PROJECT NUMBER

SRS
DESIGN BY

TKL
DRAWN BY

MAB
CHECKED BY

ISSUED
AUGUST 2008

REVISED
⚠ 9-11-08

SHEET NO.
5 of 18

J:\CIVIL\06189\DWG\PAV\06189_E1.DWG

PLOTTED: Tuesday, September 16, 2008 @ 08:30AM