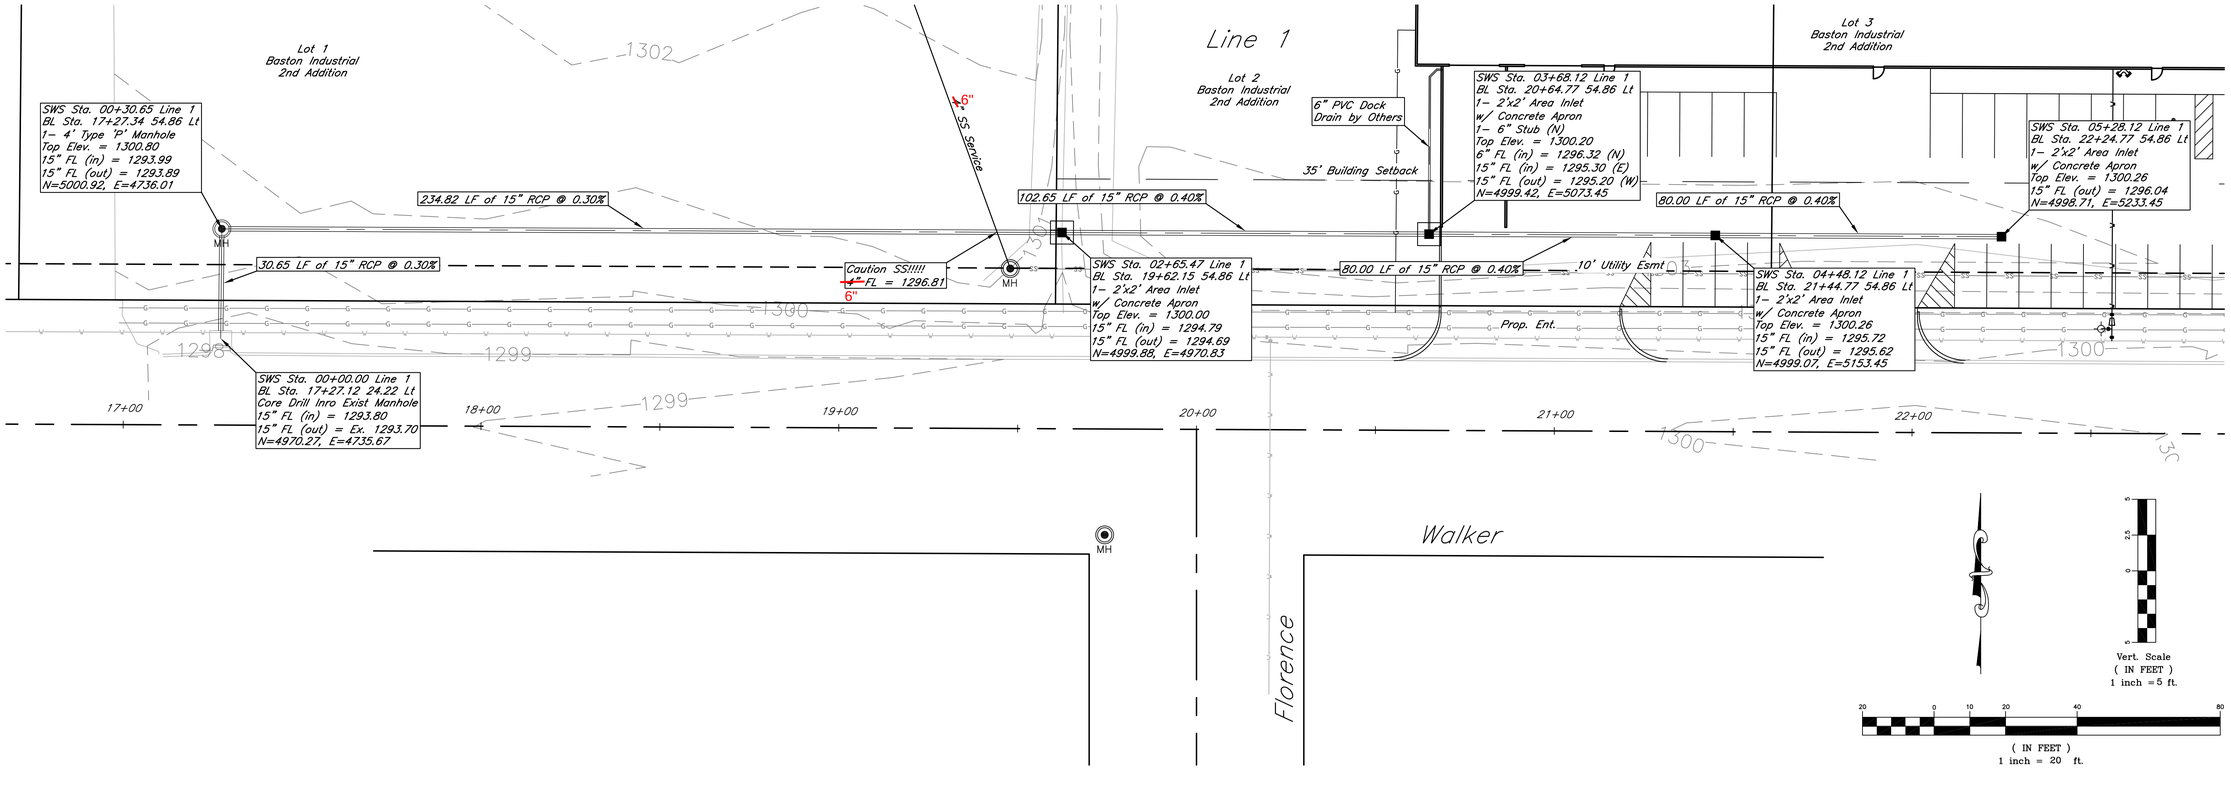

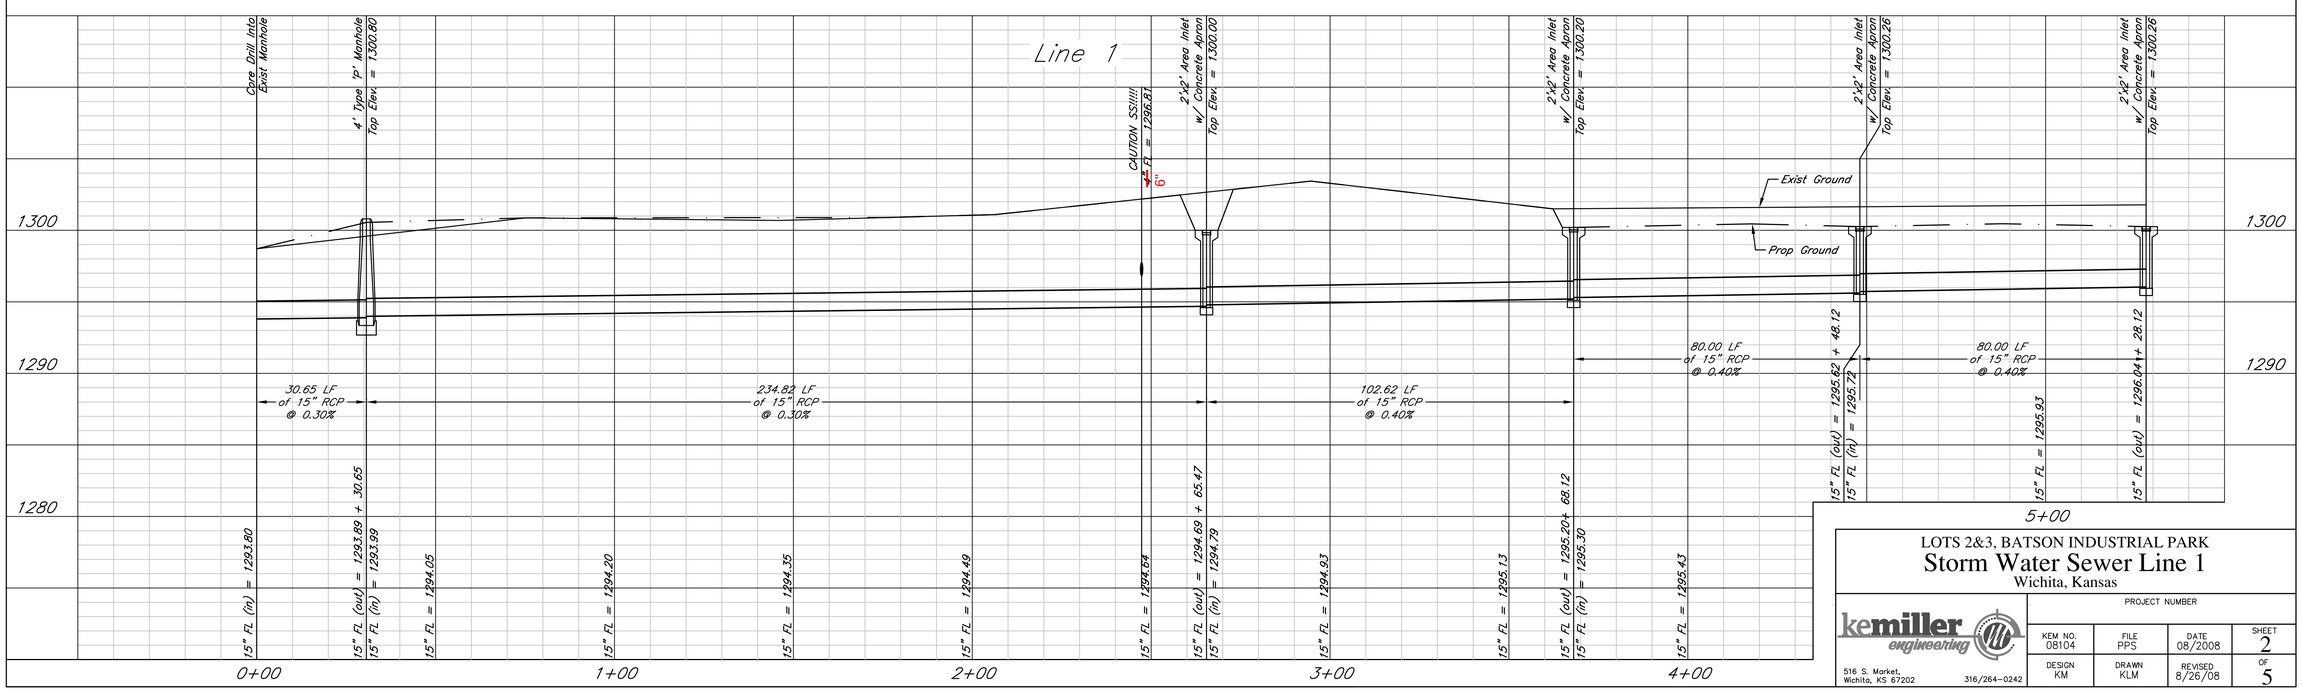

LOTS 2&3, BATSON INDUSTRIAL PARK

Storm Water Sewer Line 1

Wichita, Kansas

kemiller engineering

516 S. Market,
Wichita, KS 67202
316/264-0242

PROJECT NUMBER			
KEM NO. 08104	FILE PPS	DATE 08/2008	SHEET 2
DESIGN KM	DRAWN KLM	REVISED 8/26/08	OF 5