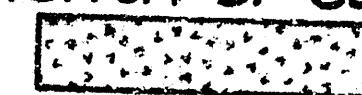
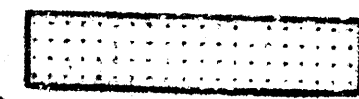


NOTES

1. All construction and materials to comply with standard City of Wichita Specifications.
2. Sewer line to be inspected by the Dept. of Public Works Inspection.
3. Sidewalks, drives, and parking to be constructed under separate contract after completion of sanitary sewer construction.
Sidewalk 
Bituminous parking and drive 
4. The contractor will be required to notify each of the following utility companies prior to the beginning of construction and should request that any existing lines be flagged:

City of Wichita Water Dept.
455 N. Main St.
268-4557 Benny Gegen



5. The contractor is responsible for supporting and protecting the 8" A.C. Waterline during the period of time it is uncovered and for properly backfilling it in accordance with standard City of Wichita Specifications.
6. The existing 8" Sanitary Sewer and MH4 were constructed under City of Wichita Sanitary Sewer Project No. DBKW 7070G3.

NOTE TO CONTRACTOR

This project will be under the supervision of the City Engineer and conforming to the City of Wichita Specifications. The contractor will be responsible for all costs of inspection.

5-20-78

APPROVED AS NOTED
BY CITY ENGINEER
Sanitary Sewers
Storm Sewers
Drainage Approaches

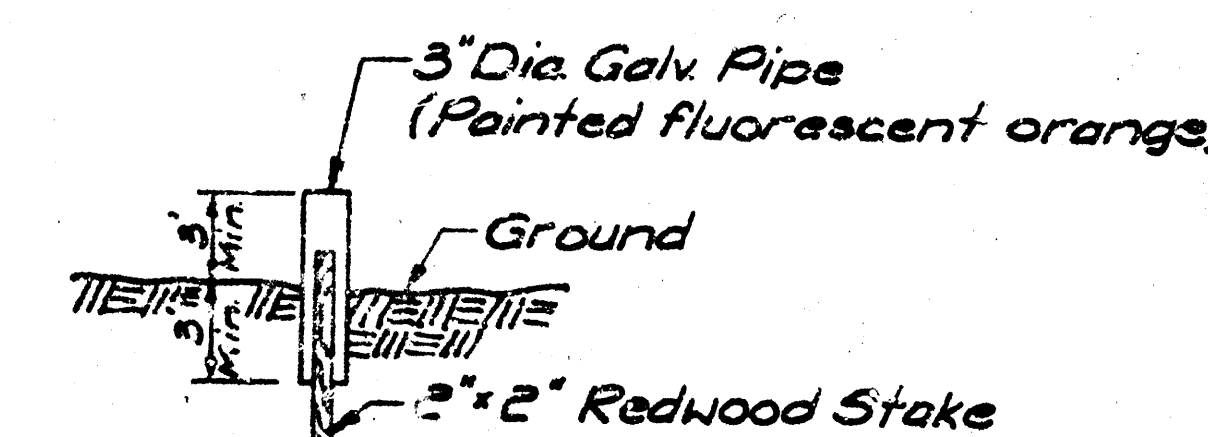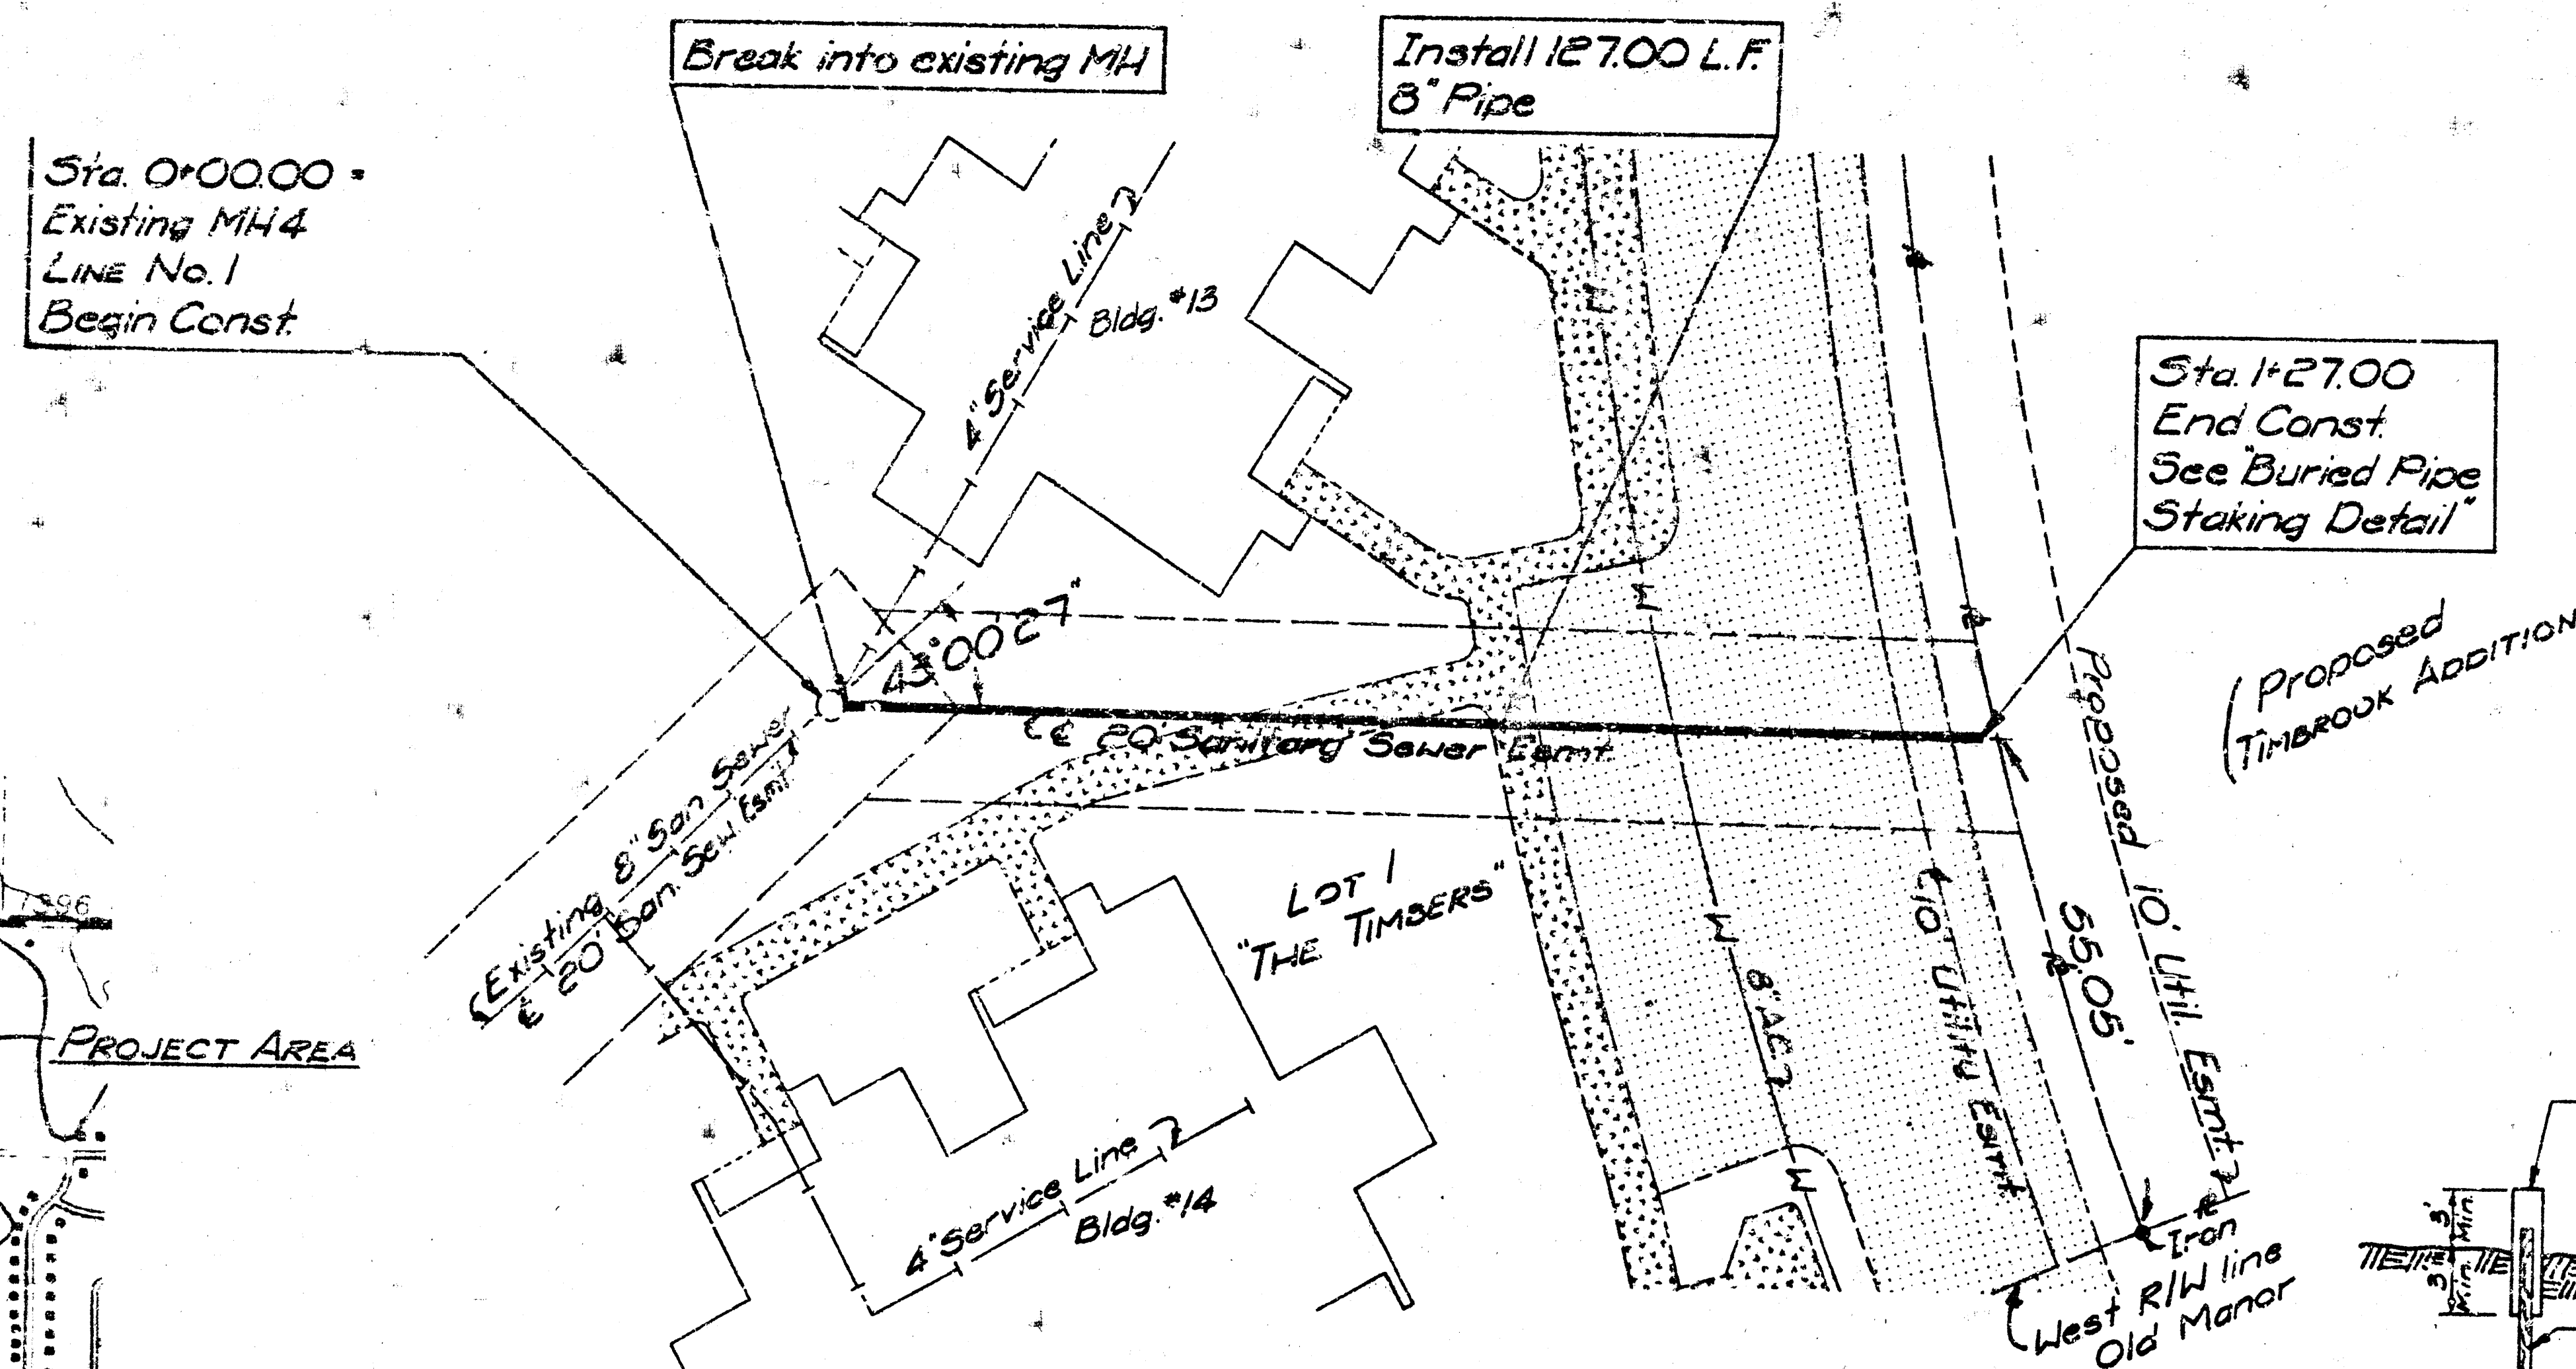



NOTE: Galvanized Pipe, Redwood Stake, Pipe Plug, Painting, all incidental work for Plugging, Staking and Marking shall be subsidiary to the unit price bid for 8" Pipe.

BURIED PIPE STAKING DETAIL

B.M. - Chis. "d" east end of curb return at SE cor. 1st Section of 20th St. & Old Manor. Elev. 229.25

SCALE:
PLAN 1"=20'
PROFILE Horiz. 1"=20'
Vert. 1"=5'

B.M. - City of Wichita disc, 33' West & 42' North of E Intersection of 21st North & Oliver Elev. 217.02

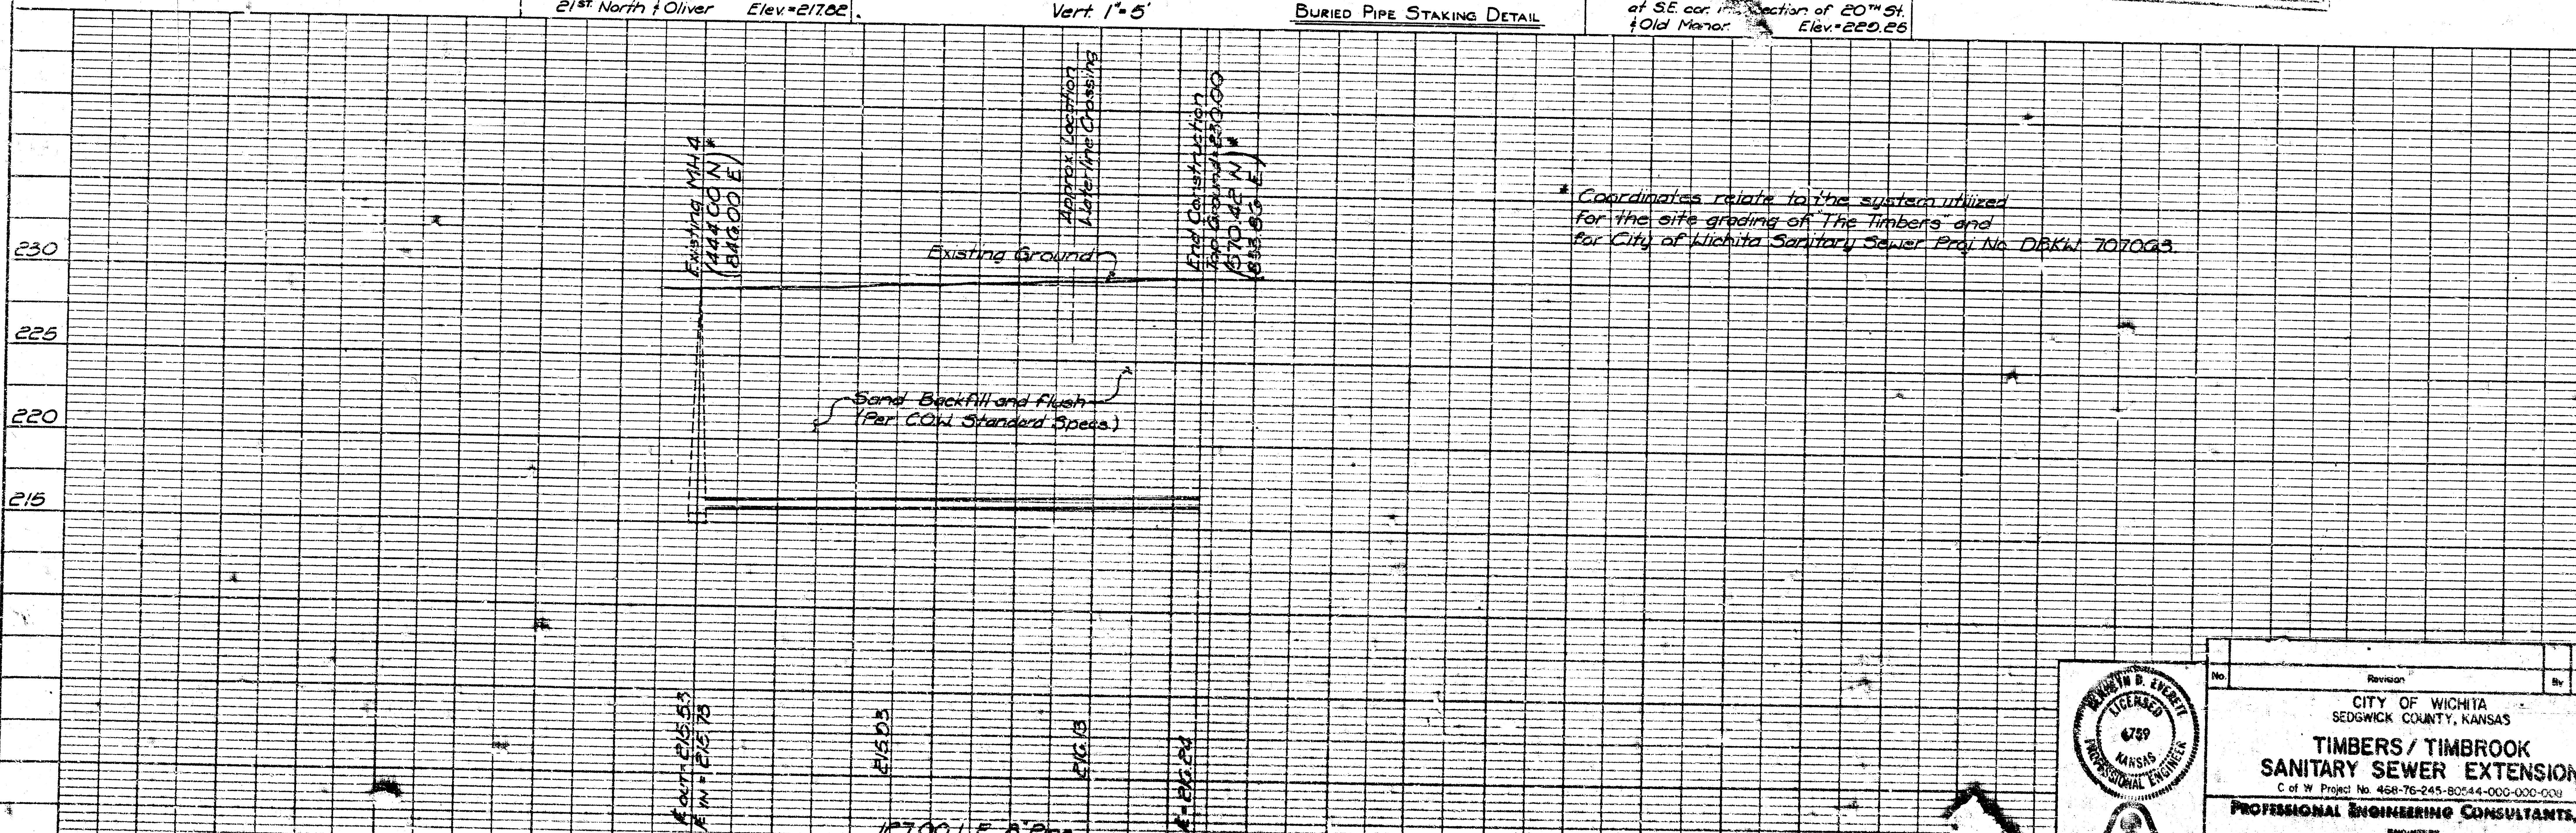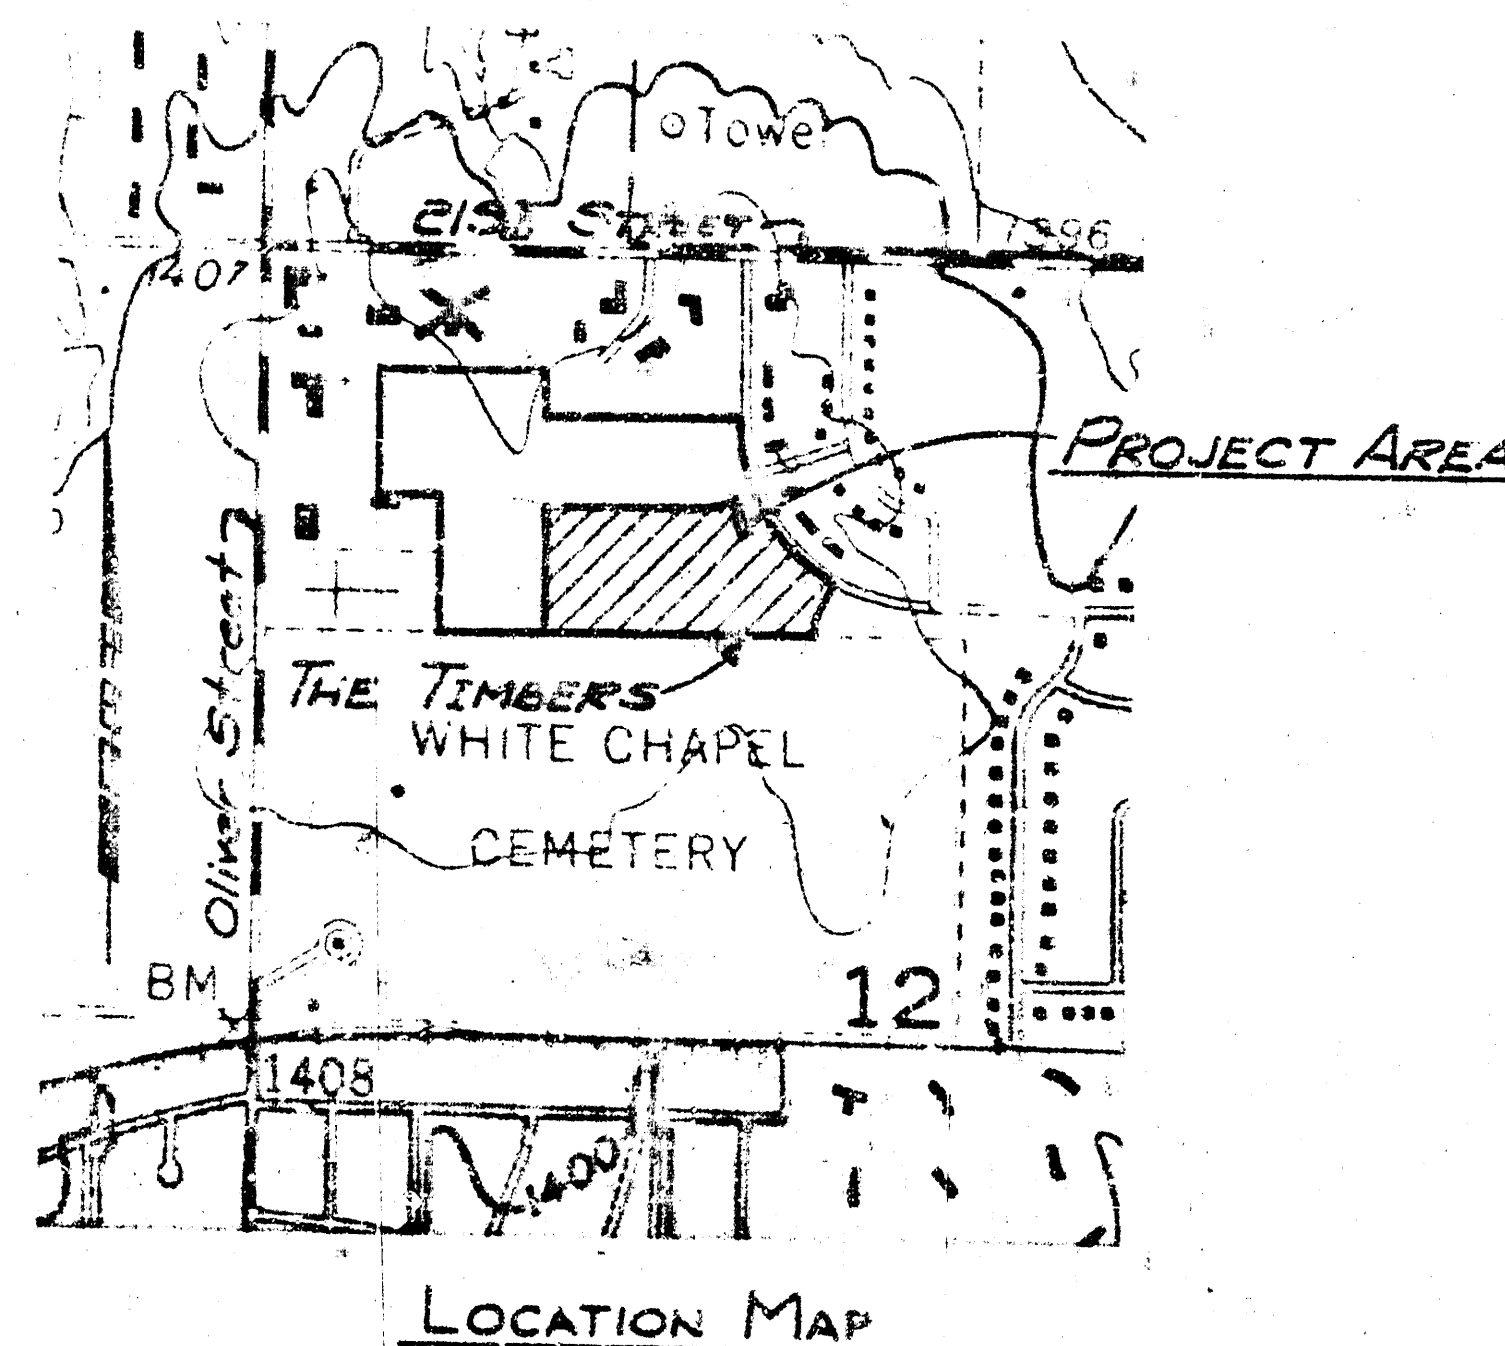

No.	Revision	By
CITY OF WICHITA SEDGWICK COUNTY, KANSAS		
TIMBERS / TIMBROOK SANITARY SEWER EXTENSION		
C of W Project No. 458-76-245-80244-000-000		
PROFESSIONAL ENGINEERING CONSULTANTS		