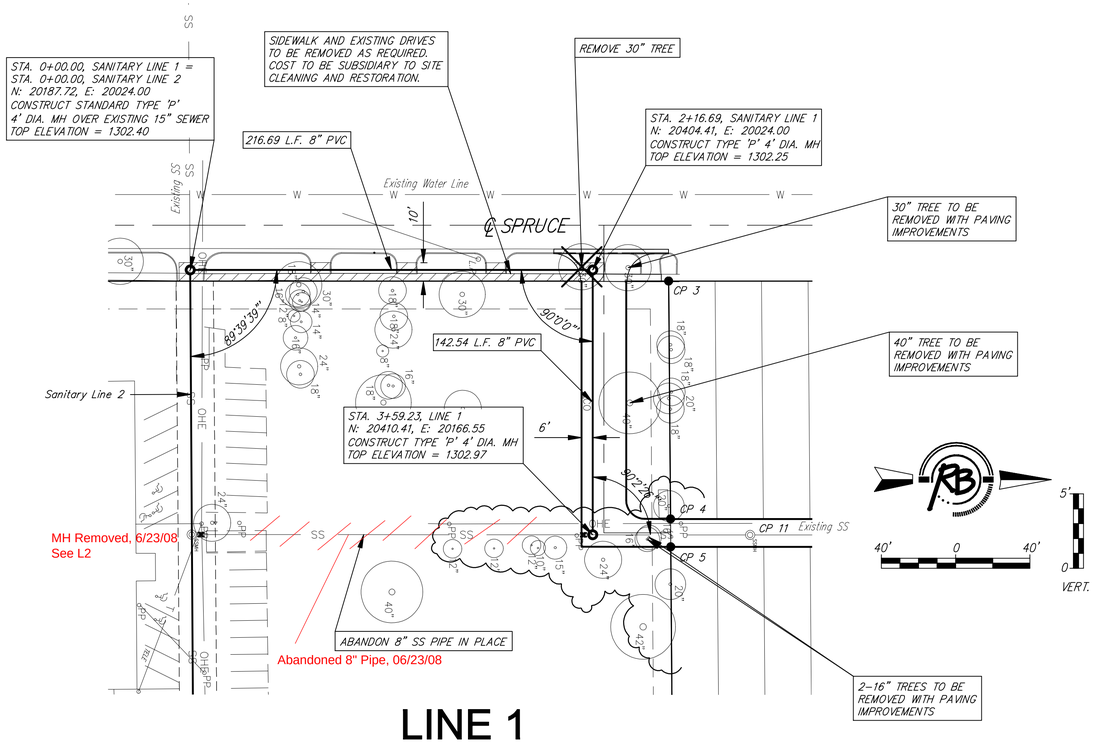

LINE 1

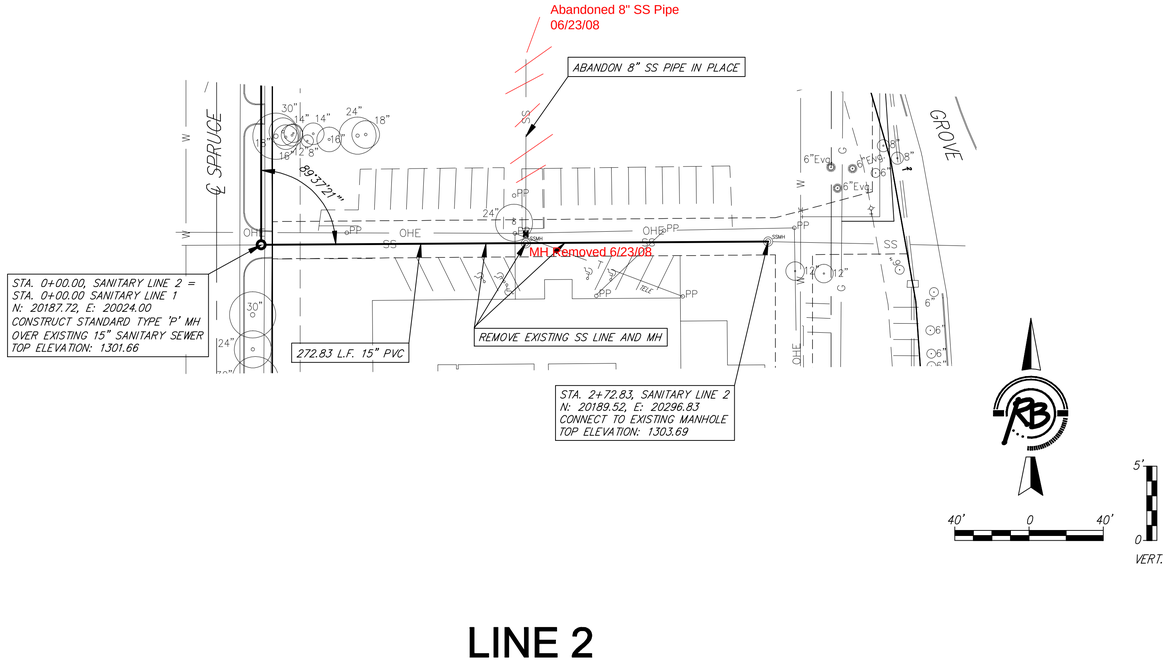

LINE 2

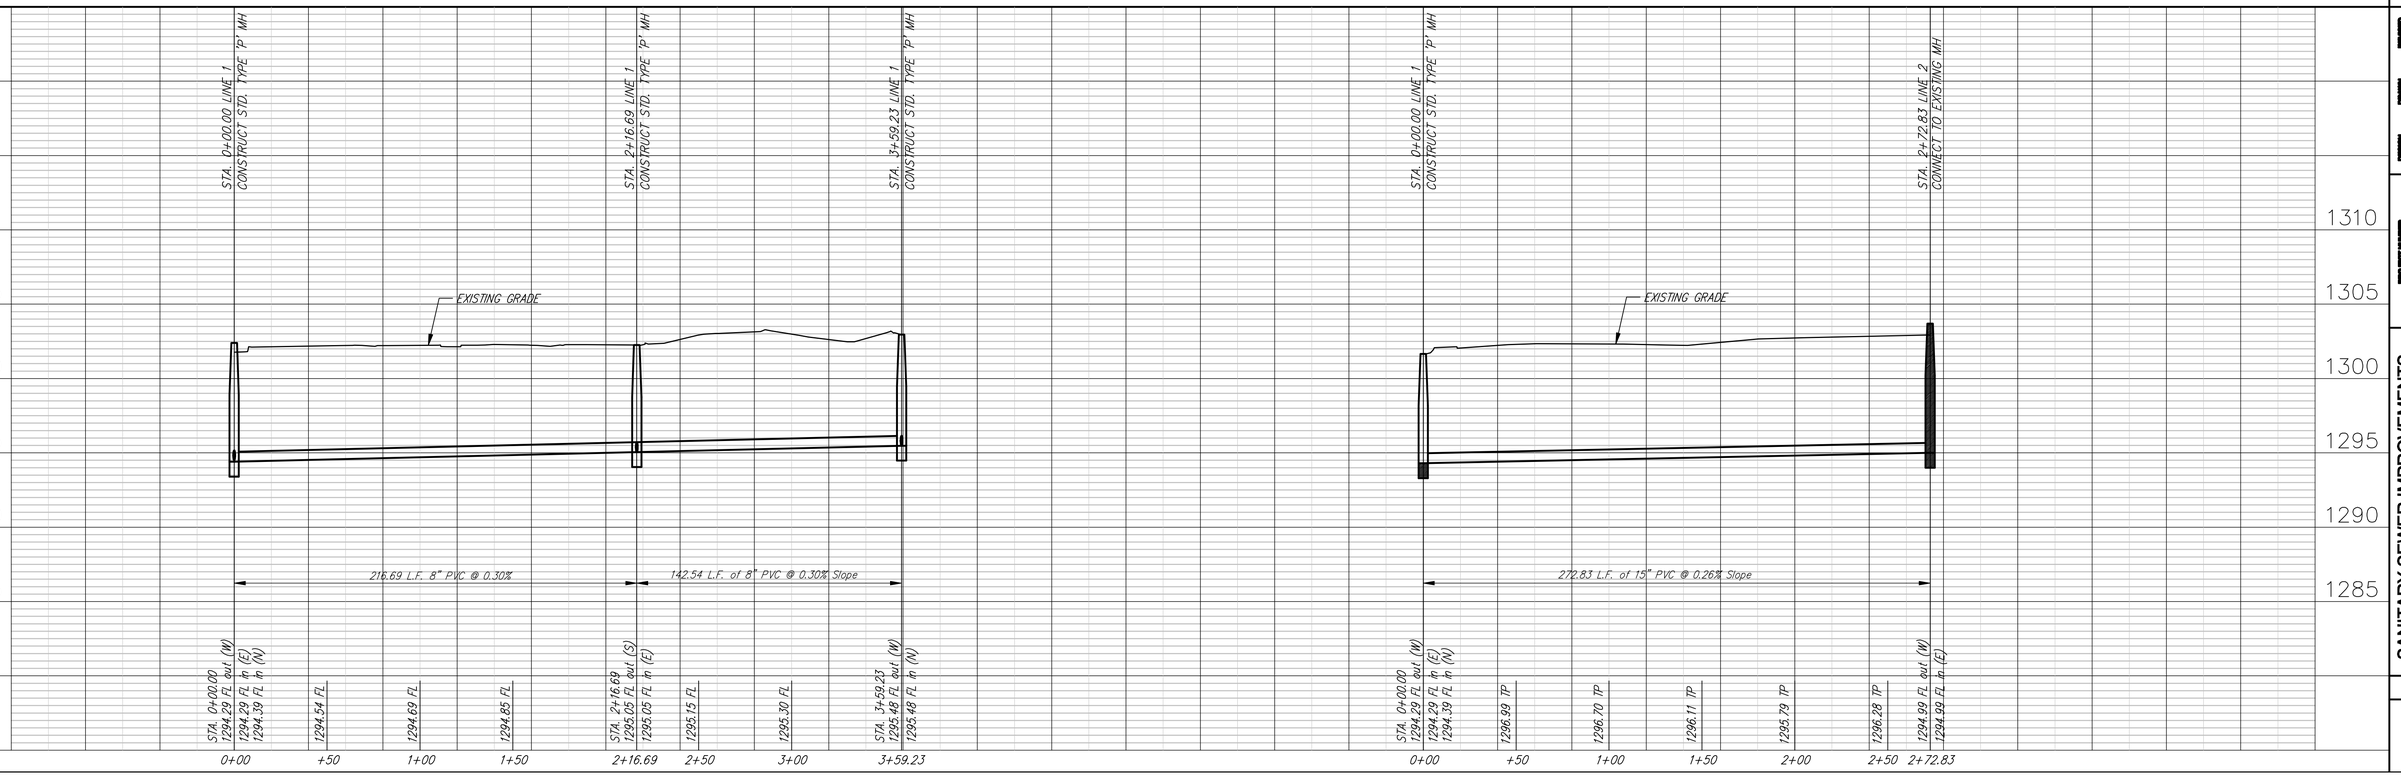

Ruggeri-Jacobson Engineering Surveying Planning

JDM | TCR | Apr. 18, 2008

PROJECT NUMBER 468-84350

DRAWING FILE

SANITARY SEWER IMPROVEMENTS
LINE #1
CITY OF WICHITA, KANSAS

PID JOB 3175E

2
10