



BENCHMARKS:

135th St. W. & Pawnee—
City of Wichita Benchmark
Disc on SW Corner of
Concrete Base of High Line
Pole.
Elev. = 1359.65 NGVD29

119th St. W. & Pawnee—
City of Wichita Benchmark
Disc 0.5 miles S of Kellogg.
42.2' E of centerline & 6.4"
S of Power Pole.
Elev. = 1332.09 MSL



Scale:
1" = 40' Horizontal
1" = 5' Vertical
• = Iron

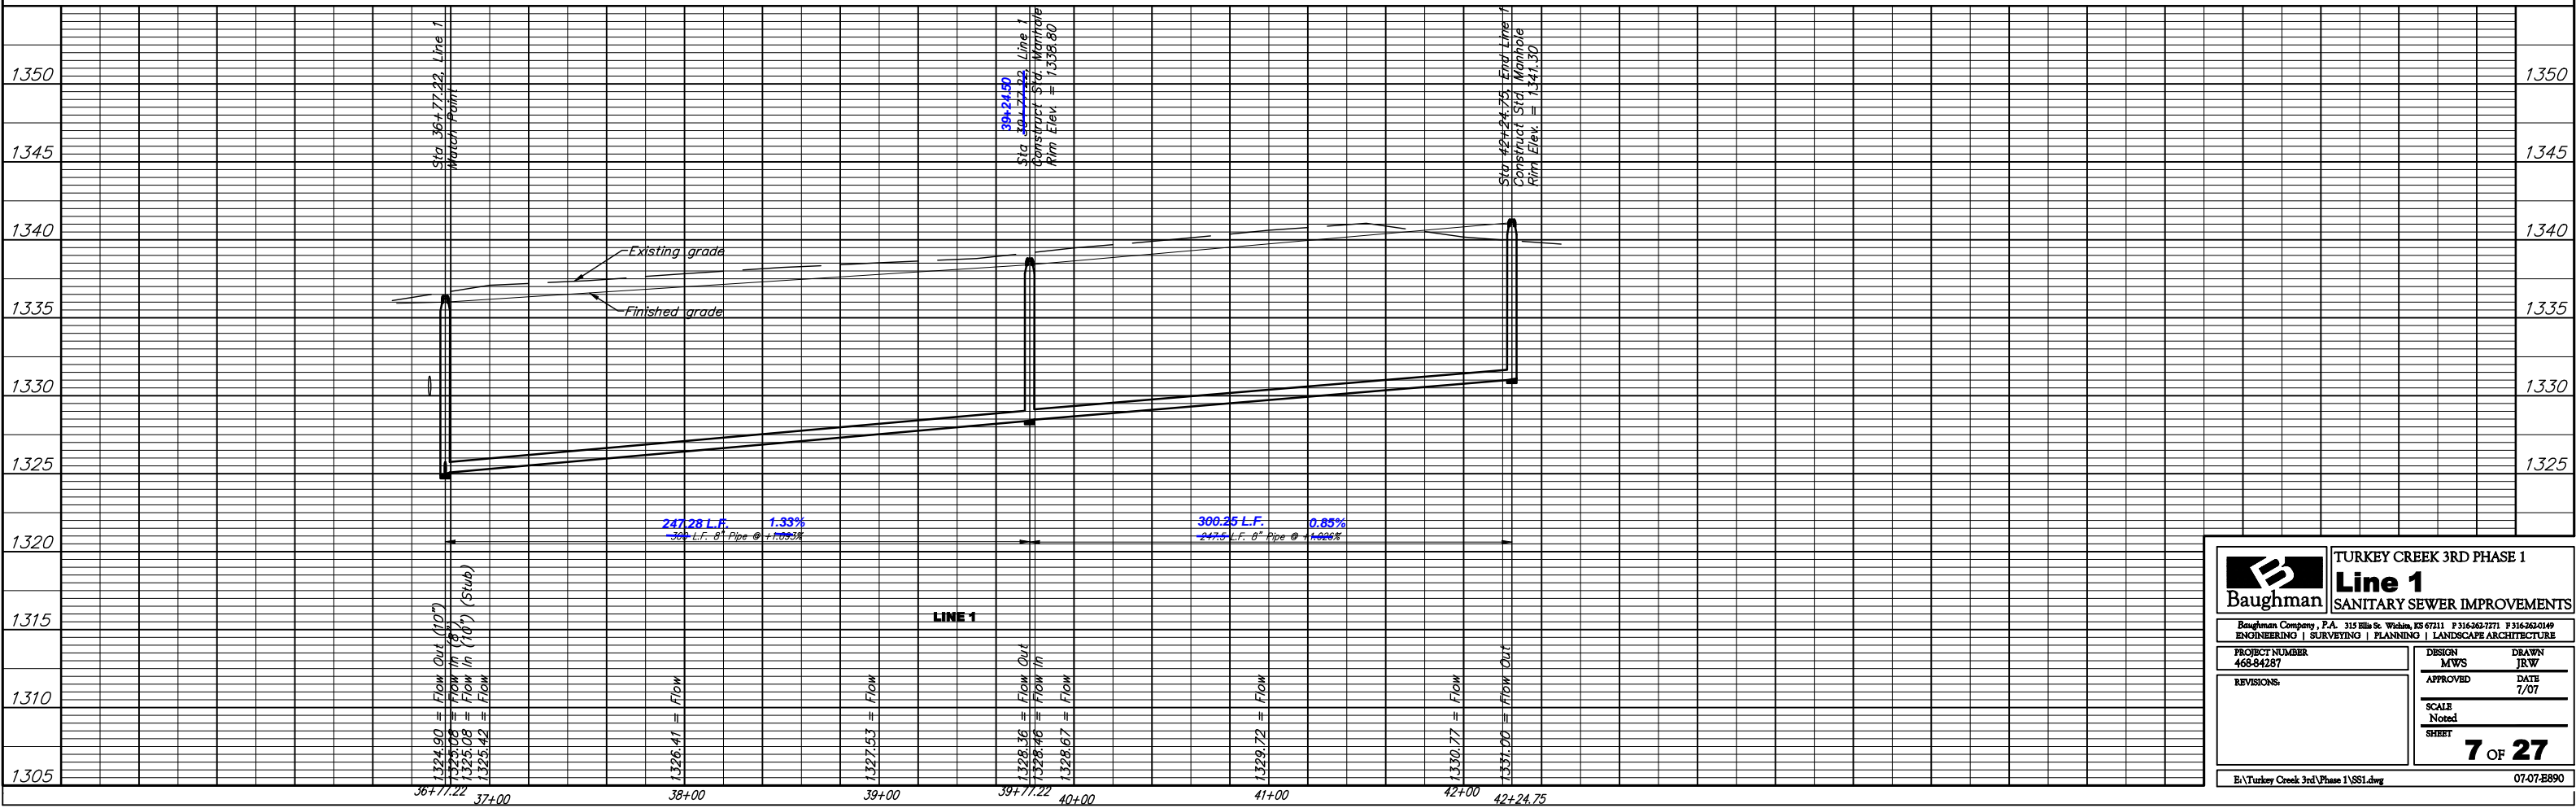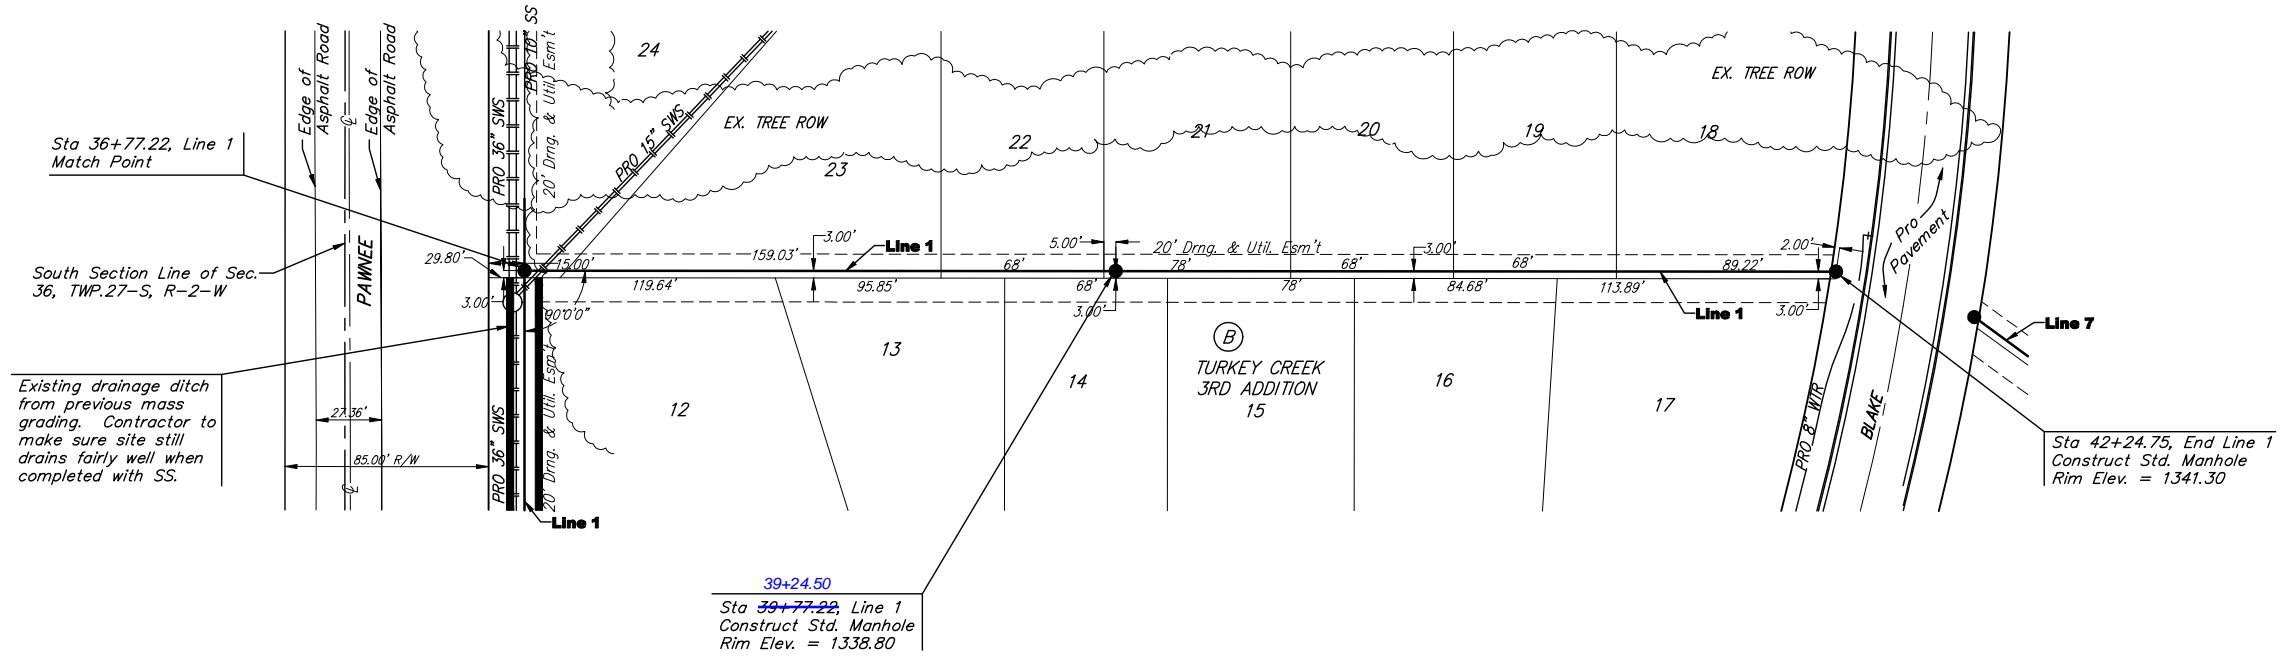

		TURKEY CREEK 3RD PHASE 1	
		Line 1	
ENGINEERING SURVEYING PLANNING LANDSCAPE ARCHITECTURE		SANITARY SEWER IMPROVEMENTS	
<small>Baughman Company, P.A. 315 Ellis St. Wichita, KS 67211 P 316-262-7771 F 316-262-0149 468-84287</small>			
PROJECT NUMBER 468-84287	DESIGN MWS	DRAWN JRW	DATE 7/07
REVISIONS	APPROVED	SCALE Noted	SHEET 7 OF 27
E:\Turkey Creek 3rd Phase 1\SS1.dwg		07-07-E890	