


**SANITARY SEWER MAIN PLANS FOR
MONARCH LANDING
SECOND ADDITION**

UNPLATTED



NOTE:
MANHOLES SHALL BE LINED PER CITY OF WICHITA STD SPEC. USING RAVEN 405, SAUERREISEN, WARREN ENVIRONMENTAL 5301, OR ZEBRON MANHOLE LINERS.

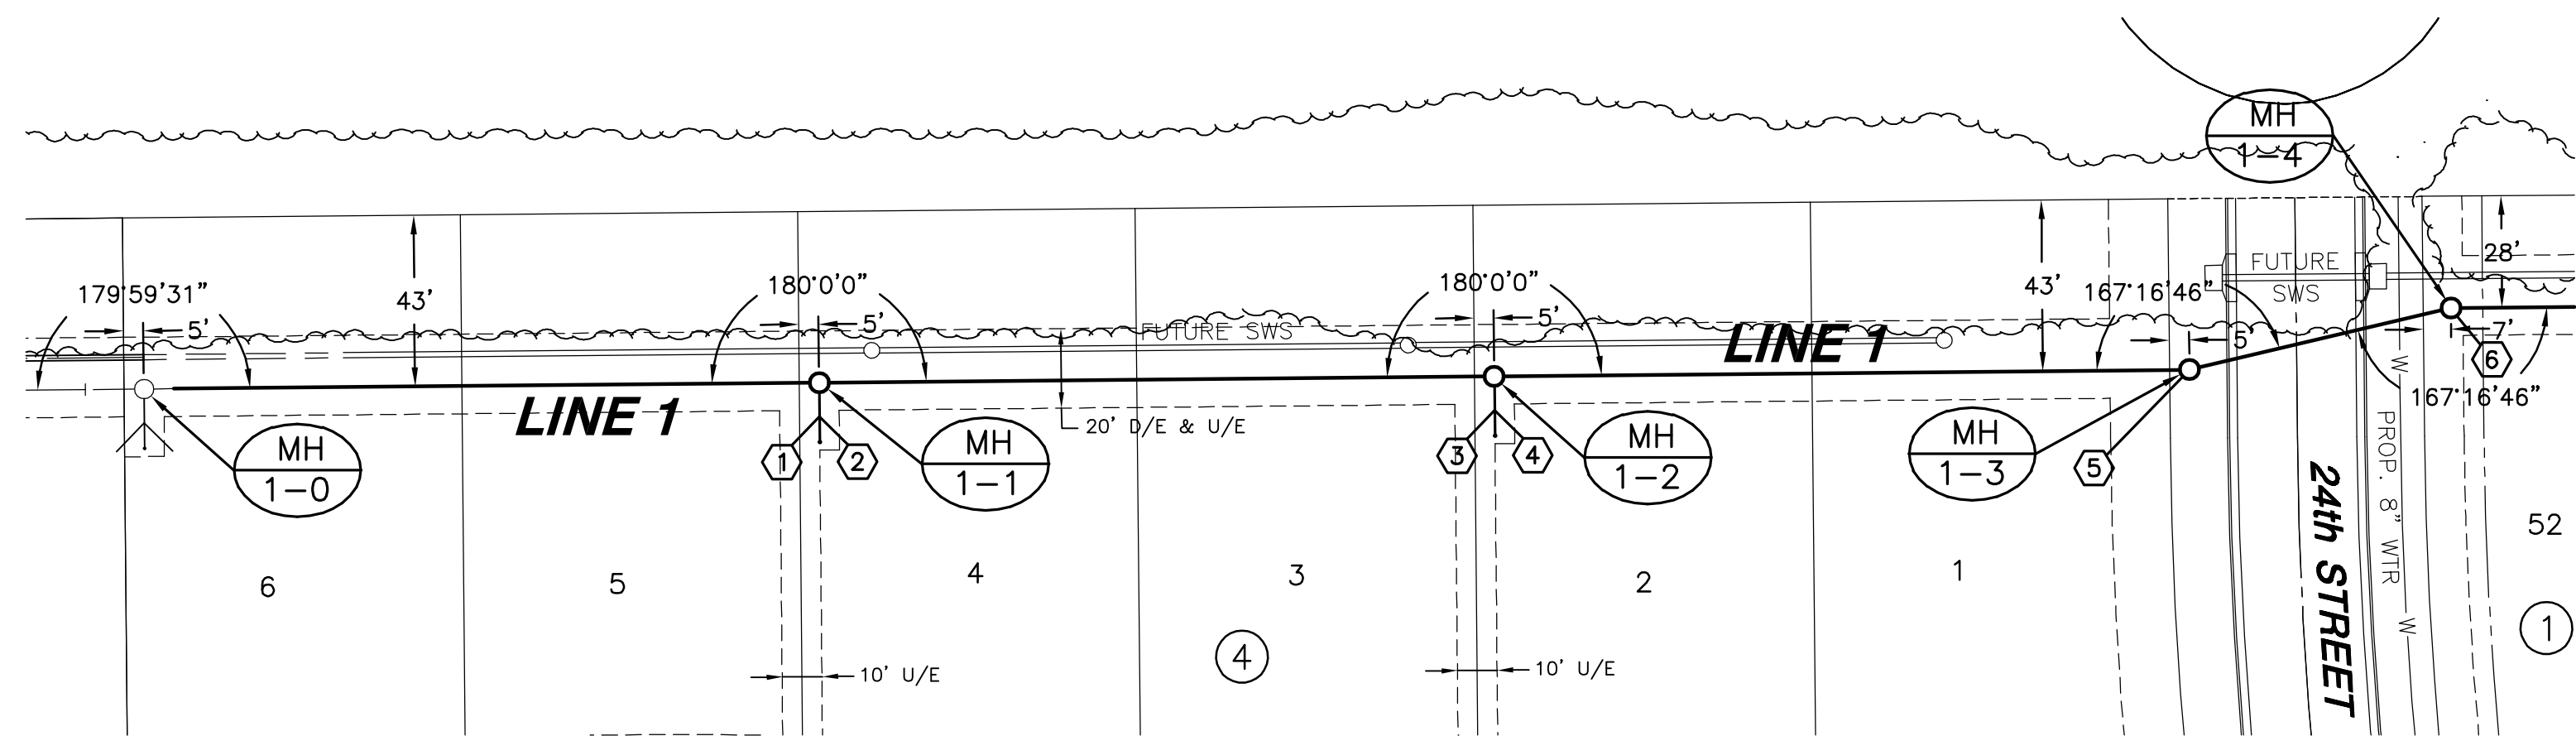


MONARCH LANDING SECOND ADDITION

PLAN LINE 1

SCALE: 1" = 40'

PROFILE LINE 1

SCALE: HORIZ. 1" = 40'
SCALE: VERT. 1" = 5'

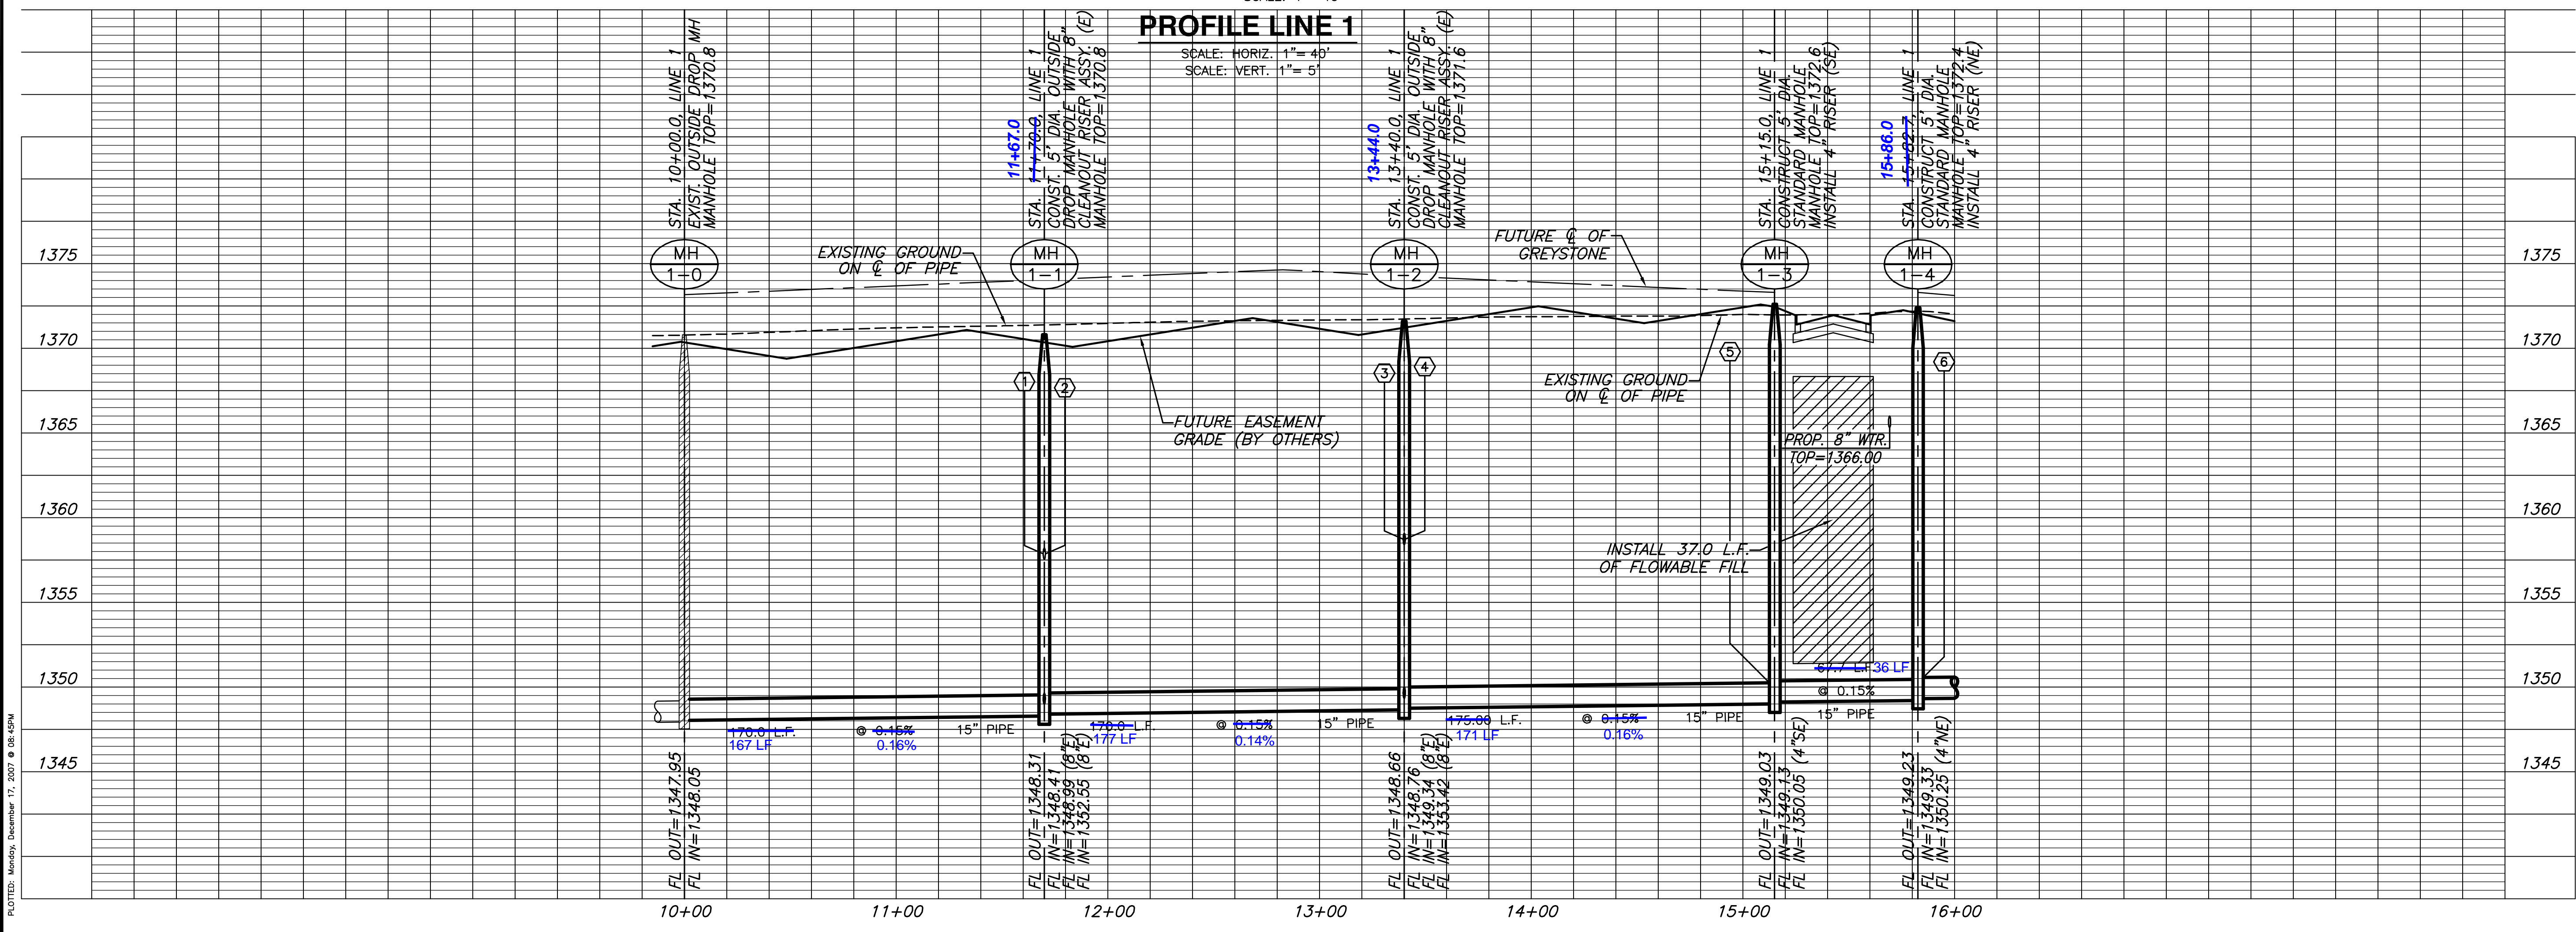

LINE 1
SHEET TITLE
468-84429
PROJECT NUMBER

DESIGN BY: JLB
DRAWN BY: JLB
CHECKED BY: GJA

ISSUED: December 2007
REVISED:

SHEET NO.
5 of 13

PLOTTED: Monday, December 17, 2007 @ 08:45PM

J:\CIVIL\06201\07165\SAN_MANN\07165_MAIN-B1.DWG