

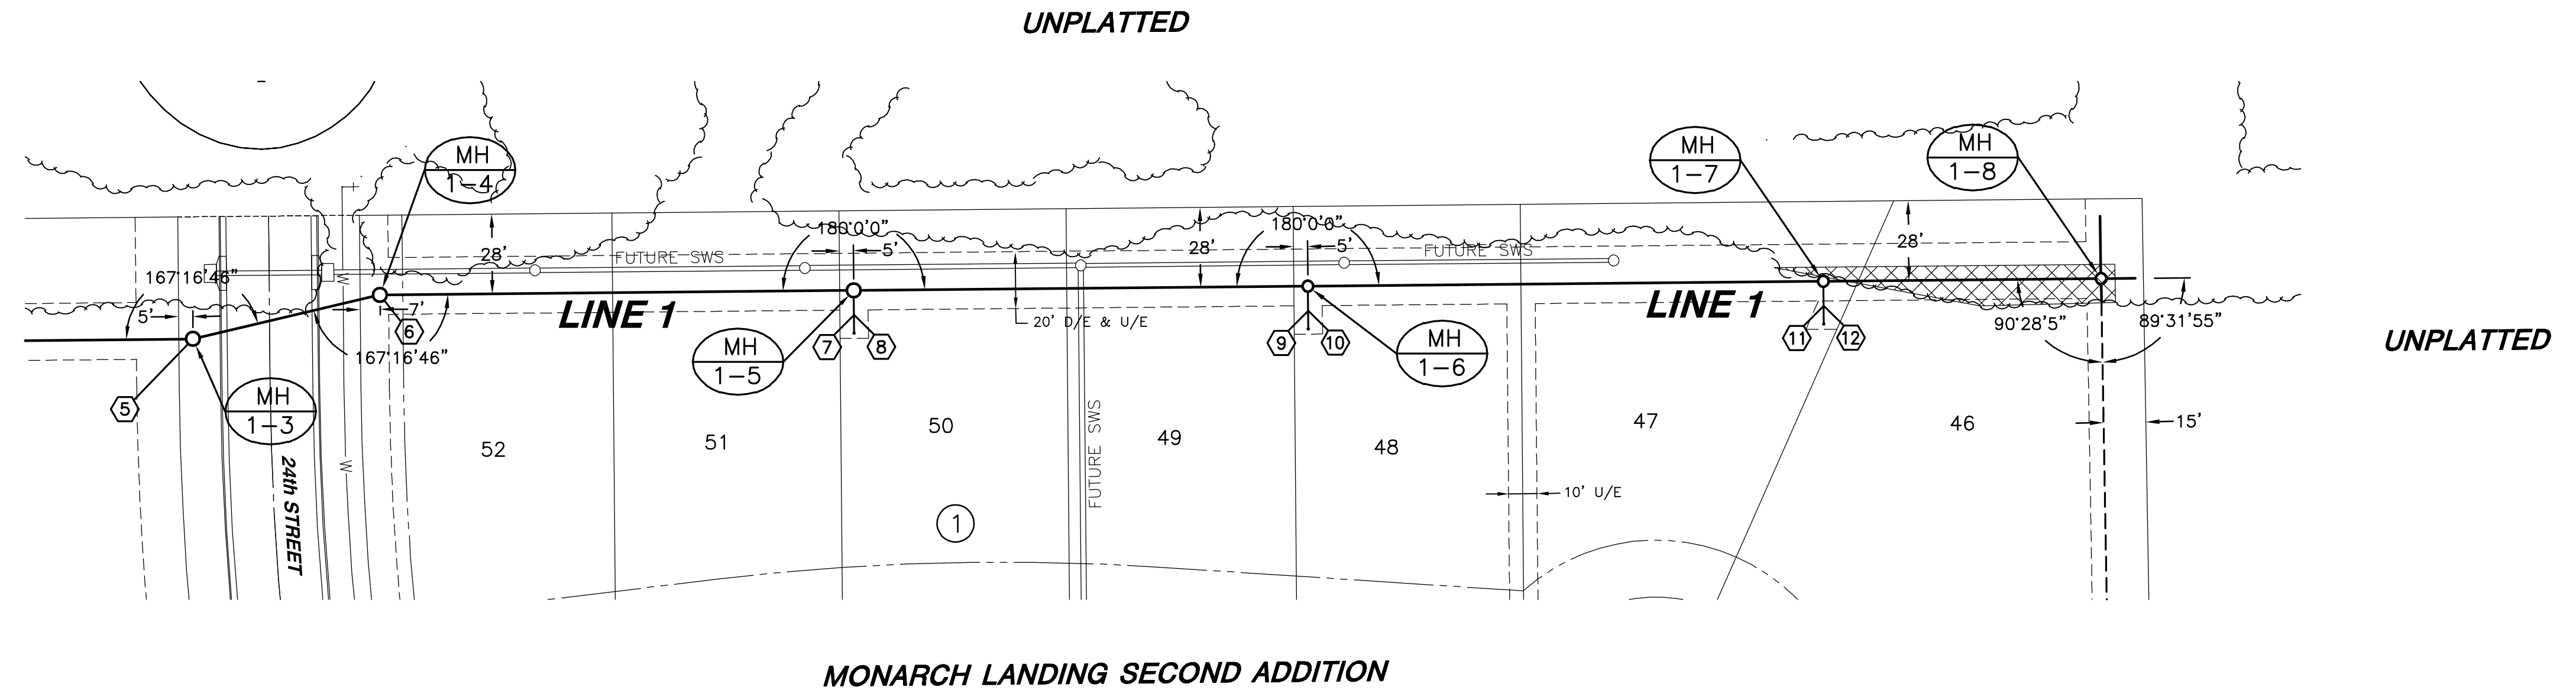


NOTE:
MANHOLES SHALL BE LINED PER
CITY OF WICHITA STD SPEC.
USING RAVEN 405, SAUERREISEN,
WARREN ENVIRONMENTAL 5301,
OR ZEBRON MANHOLE LINERS.

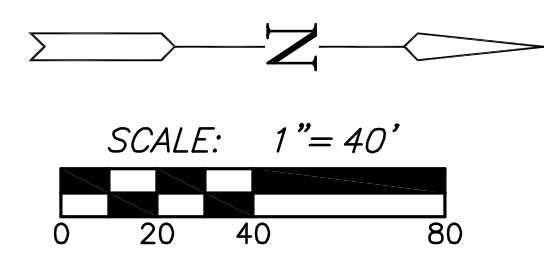

PLAN LINE 1
SCALE: 1"=40'

▨ = TREE REMOVAL

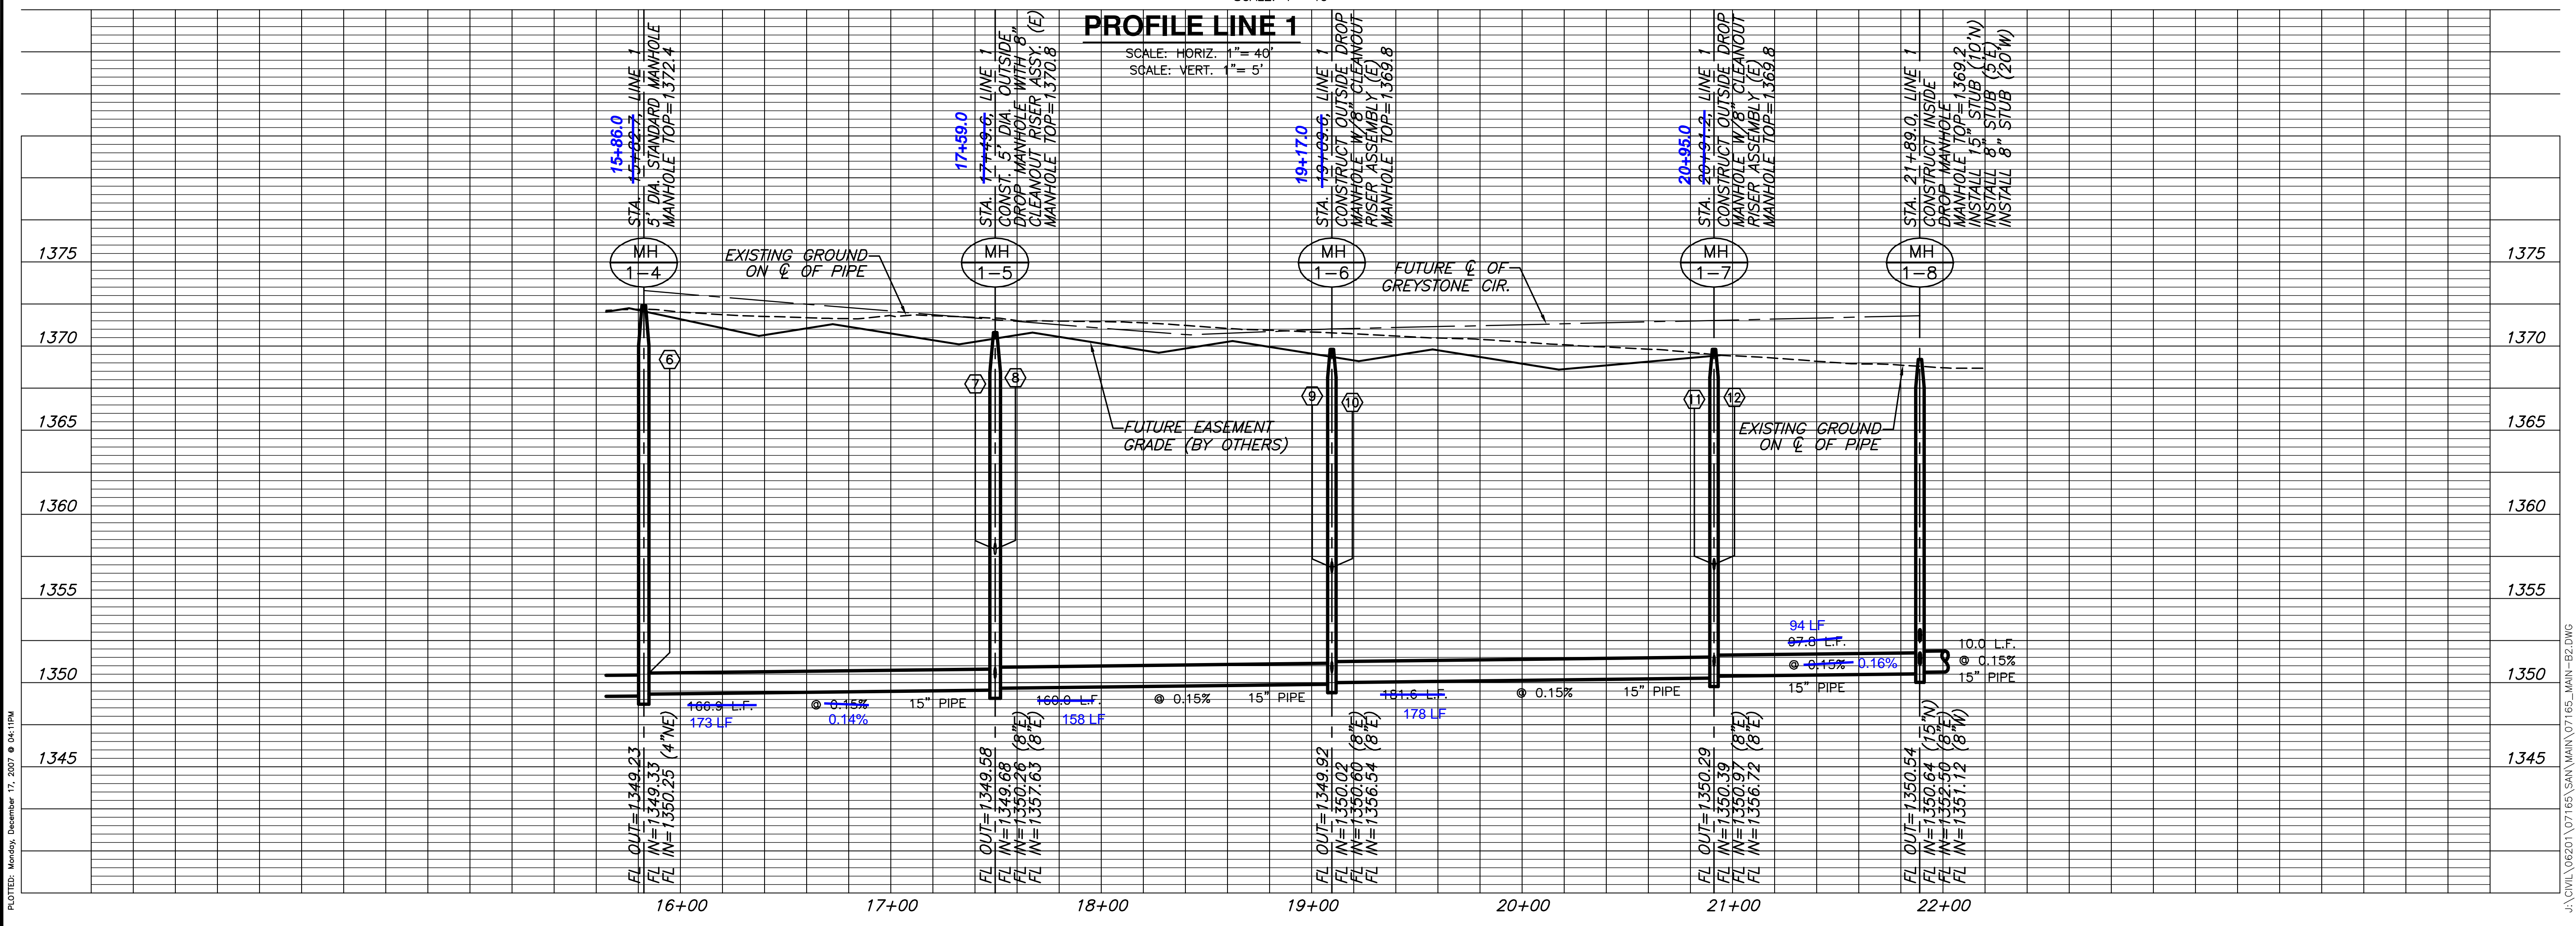

PLOTED: Monday, December 17, 2007 @ 04:11PM

J:\CIVIL\06207\07165\SAN_MANN\07165_MAIN-B2.DWG