
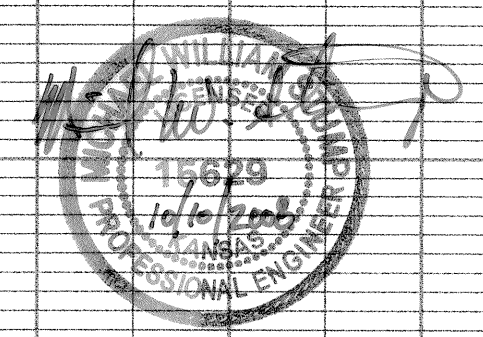
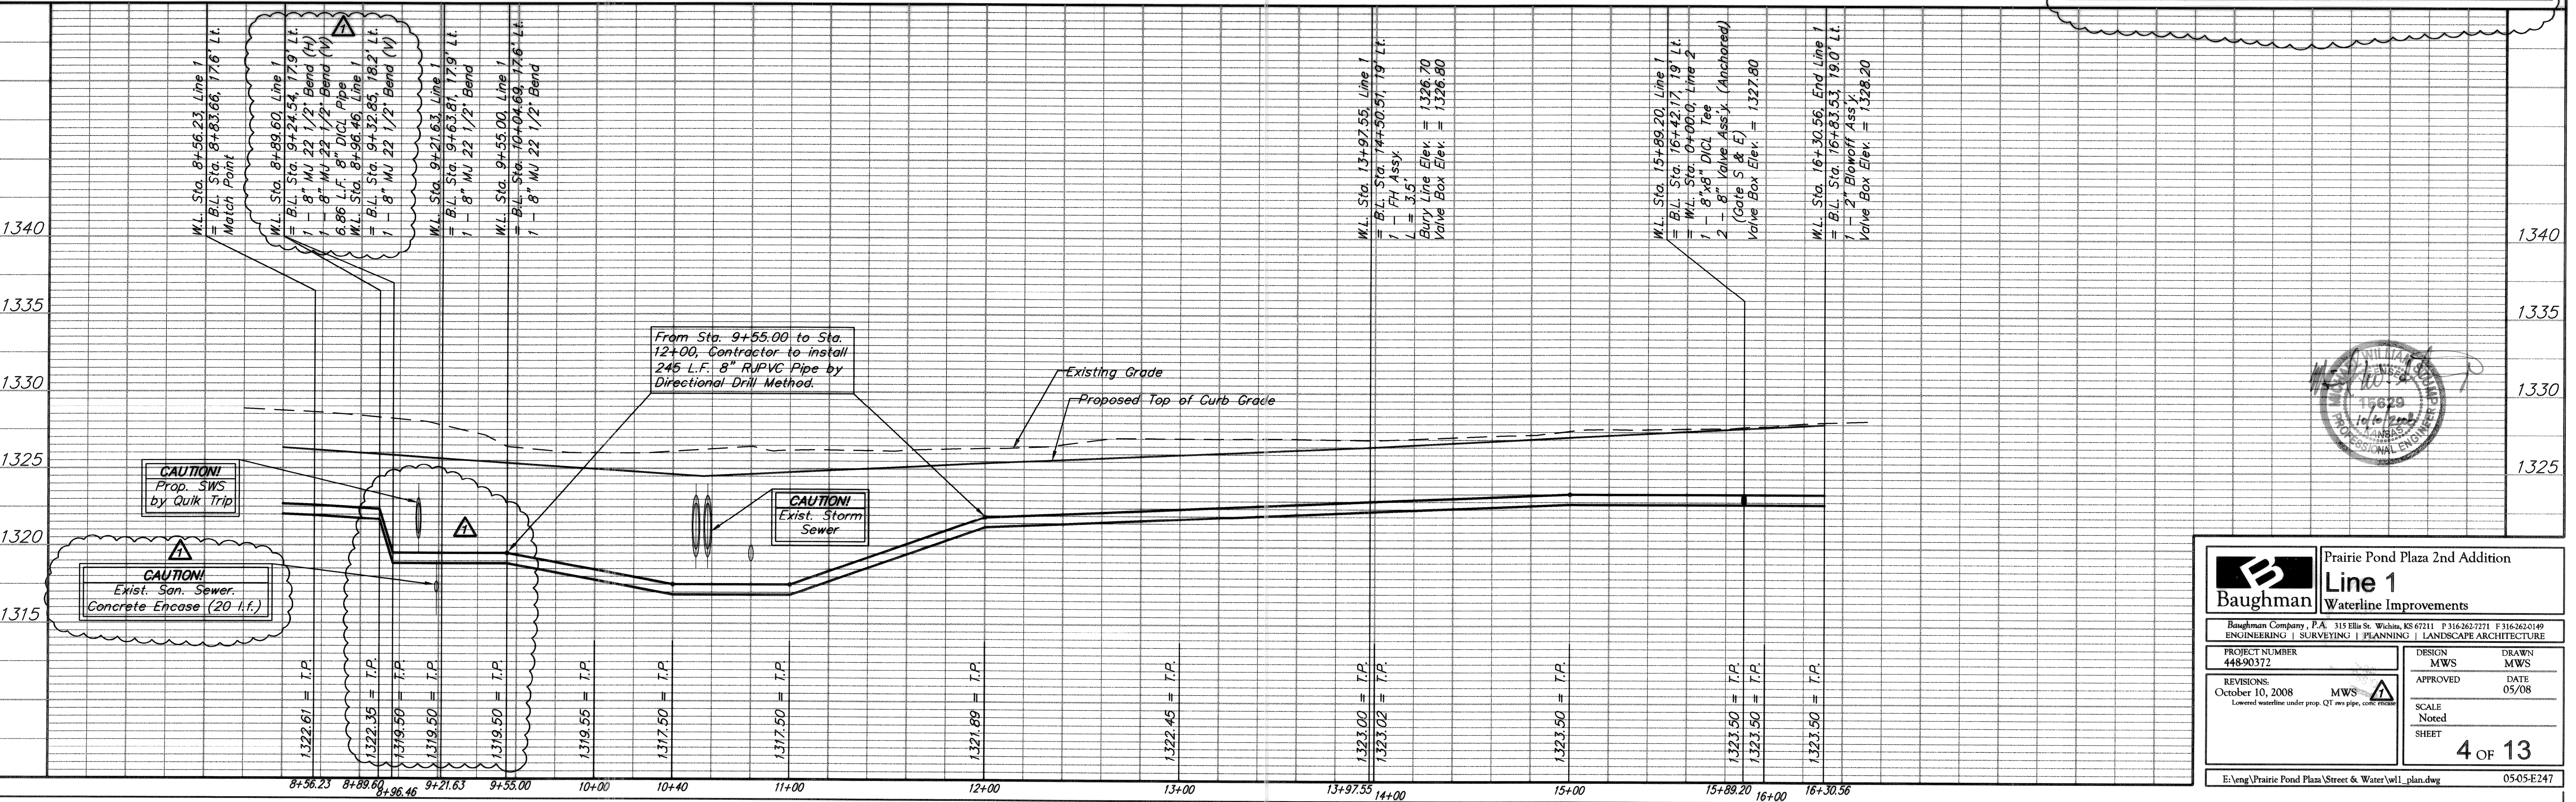


**BENCHMARK:**  
 "□" CUT ON TRAFFIC SIGNAL  
 LIGHT POLE BASE, NW CORNER  
 OF KELLOGG & 143RD STREET  
 EAST.

ELEV. = 1318.61 NGVD  
 ELEV. = 131.21 CITY DATUM

Scale: 1" = 40' Horizontal  
 1" = 5' Vertical  
 • = Iron

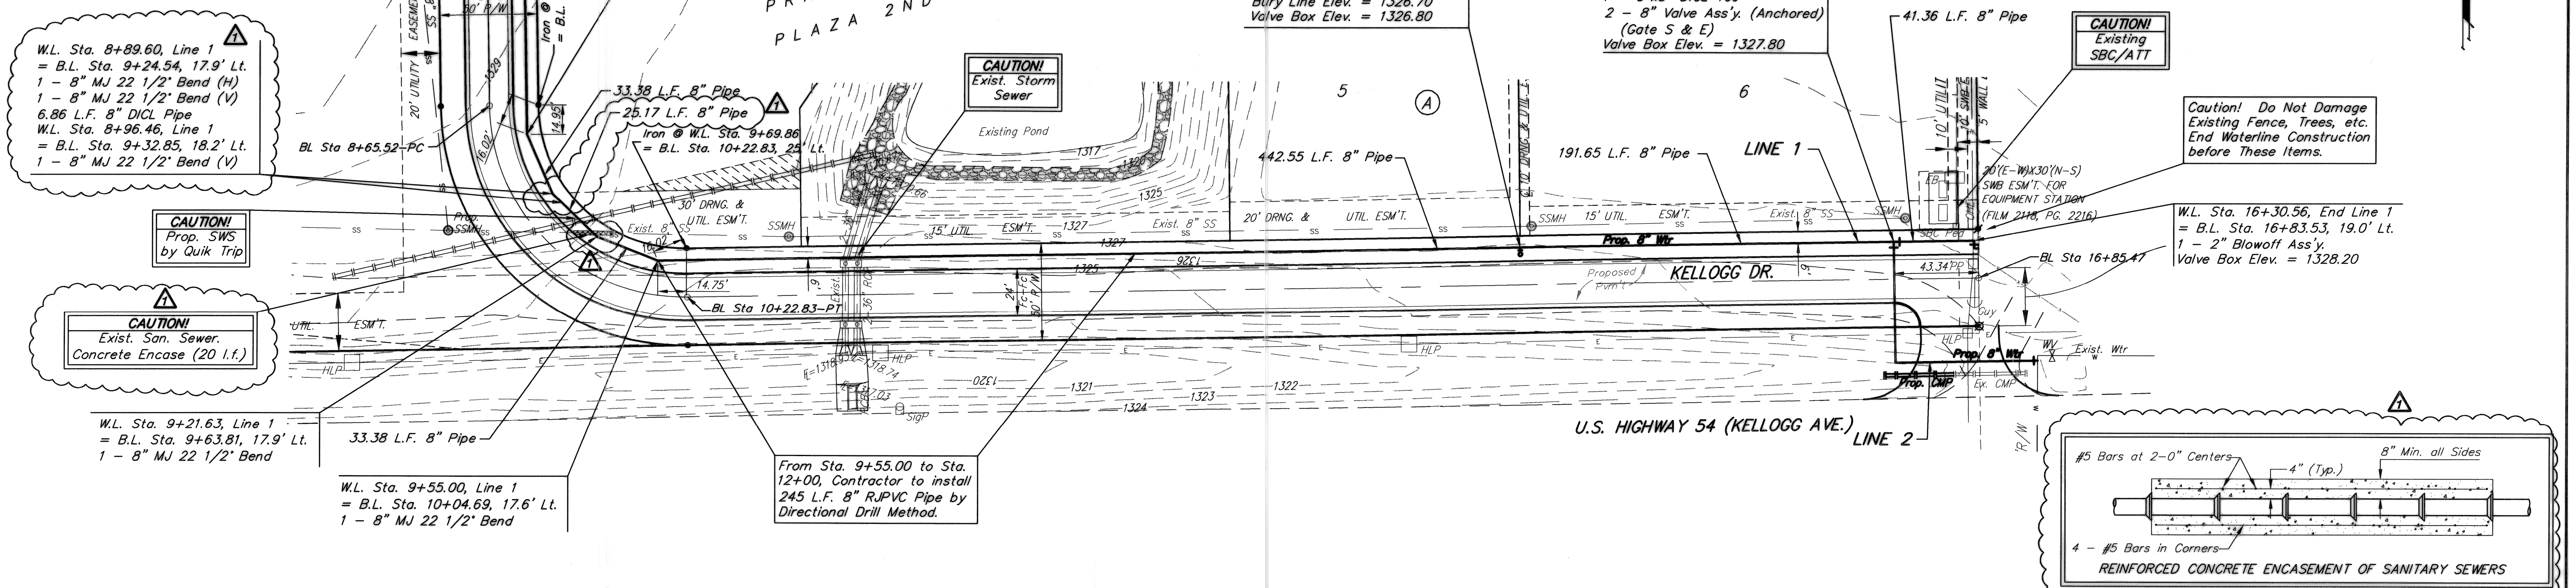

**Baughman** Prairie Pond Plaza 2nd Addition  
**Line 1**  
 Waterline Improvements

PROJECT NUMBER: 44890372  
 DESIGN: MWS  
 DRAWN: MWS  
 REVISIONS: October 10, 2008  
 MWS  
 Lowered waterline under prop. QT m pipe, one elev.

APPROVED: DATE 05/08  
 SCALE: Noted  
 SHEET: 4 OF 13

E:\eng\Prairie Pond Plaza Street & Water\wt1\_plan.dwg 05-05-E247