


Bench Marks:

- "□" Chiseled on top of curb, west side of Custer approximately 850.7' North of the Center Line of Pawnee & East of the Northeast Corner of said property. Elev. = 1292.43 (NGVD29)
- Railroad Spike in Power Pole, East side of Custer approximately 248.5' North of the Center Line of Pawnee. Elev. = 1292.44 (NGVD29)

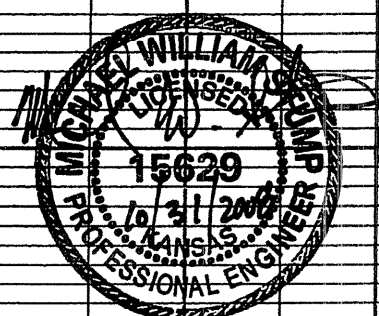

Baughman Engineering & Surveying, Inc.
 1422 PPW (607853)
 PROJECT NUMBER

REVISIONS:
 10-31-08 MWS
 Released Line PVI, added new drive

DESIGN LU
 DRAWN LU
 APPROVED LU
 DATE 07/08
 SCALE Noted
 SHEET

3 OF 5

KB Properties/Wtr-IRI 08-01-E028