


Bench Marks:

1. "□" Chiseled on top of curb, west side of Custer approximately 850.7' North of the Center Line of Pawnee & East of the Northeast Corner of said property. Elev. = 1292.43 (NGVD29)
2. Railroad Spike in Power Pole, East side of Custer approximately 248.5' North of the Center Line of Pawnee. Elev. = 1292.44 (NGVD29)

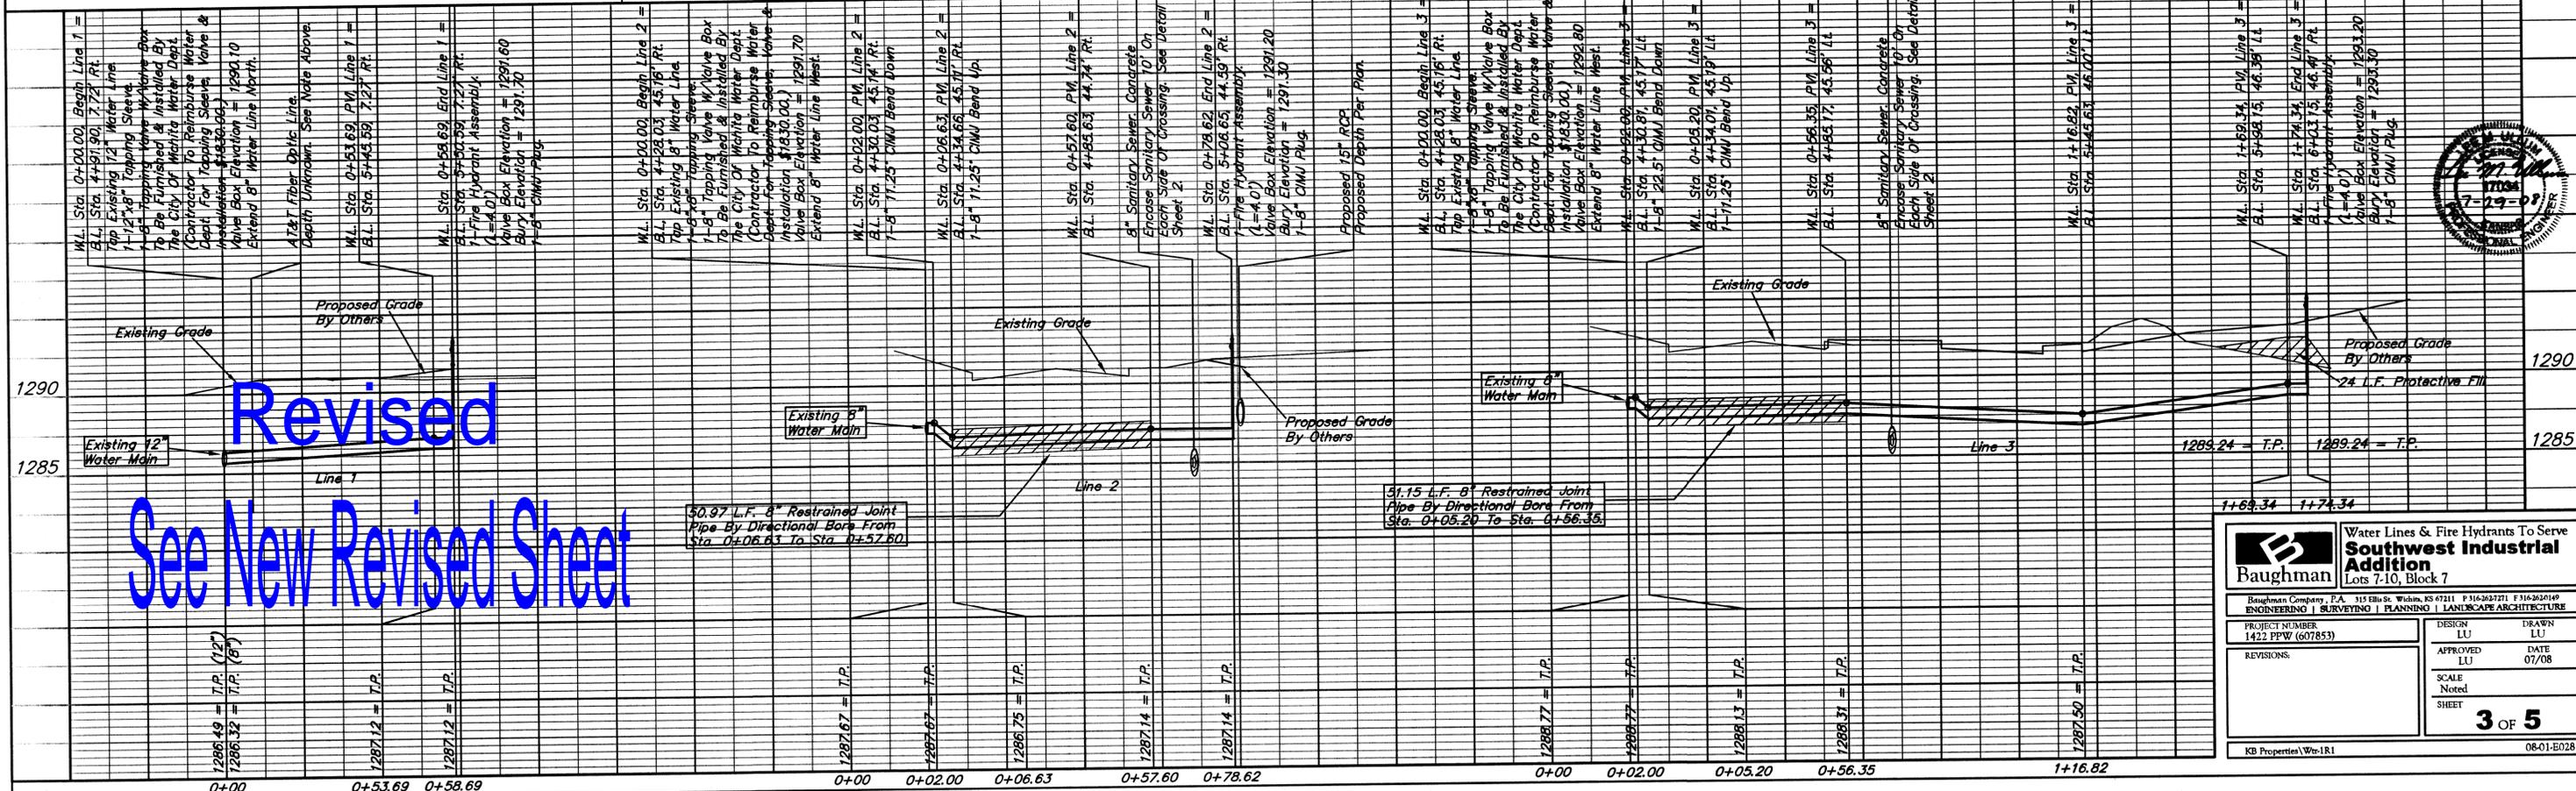

Revised
See New Revised Sheet

Baughman Water Lines & Fire Hydrants To Serve Southwest Industrial Addition Lots 7-10, Block 7

Baughman Company, P.A. 115 E. 9th St., Wichita, KS 67201 P: 316-262-2271 F: 316-262-1419
ENGINEERING | SURVEYING | PLANNING | LANDSCAPE ARCHITECTURE

PROJECT NUMBER: 1422.PPW (607853) DESIGN: LU DRAWN: LU
APPROVED: LU DATE: 07/08
SCALE: Noted
SHEET: 3 OF 5

KB Properties | W-1-R1 08-01-E028