


**SPECIAL NOTES:**

1. The Contractor shall use Best Management Practices to control erosion and sediment discharge in all disturbed areas of construction. The Contractor shall provide all necessary materials, and maintain temporary erosion and sediment controls during and after construction.
2. Unless otherwise noted all dimensions are measured center of structure to center of structure.
3. The Contractor shall field verify horizontal and vertical locations of existing buried utility lines prior to construction and report any discrepancies to the Engineer.

**SWS LINE NO. 2**

**SWS LINE NO. 3**

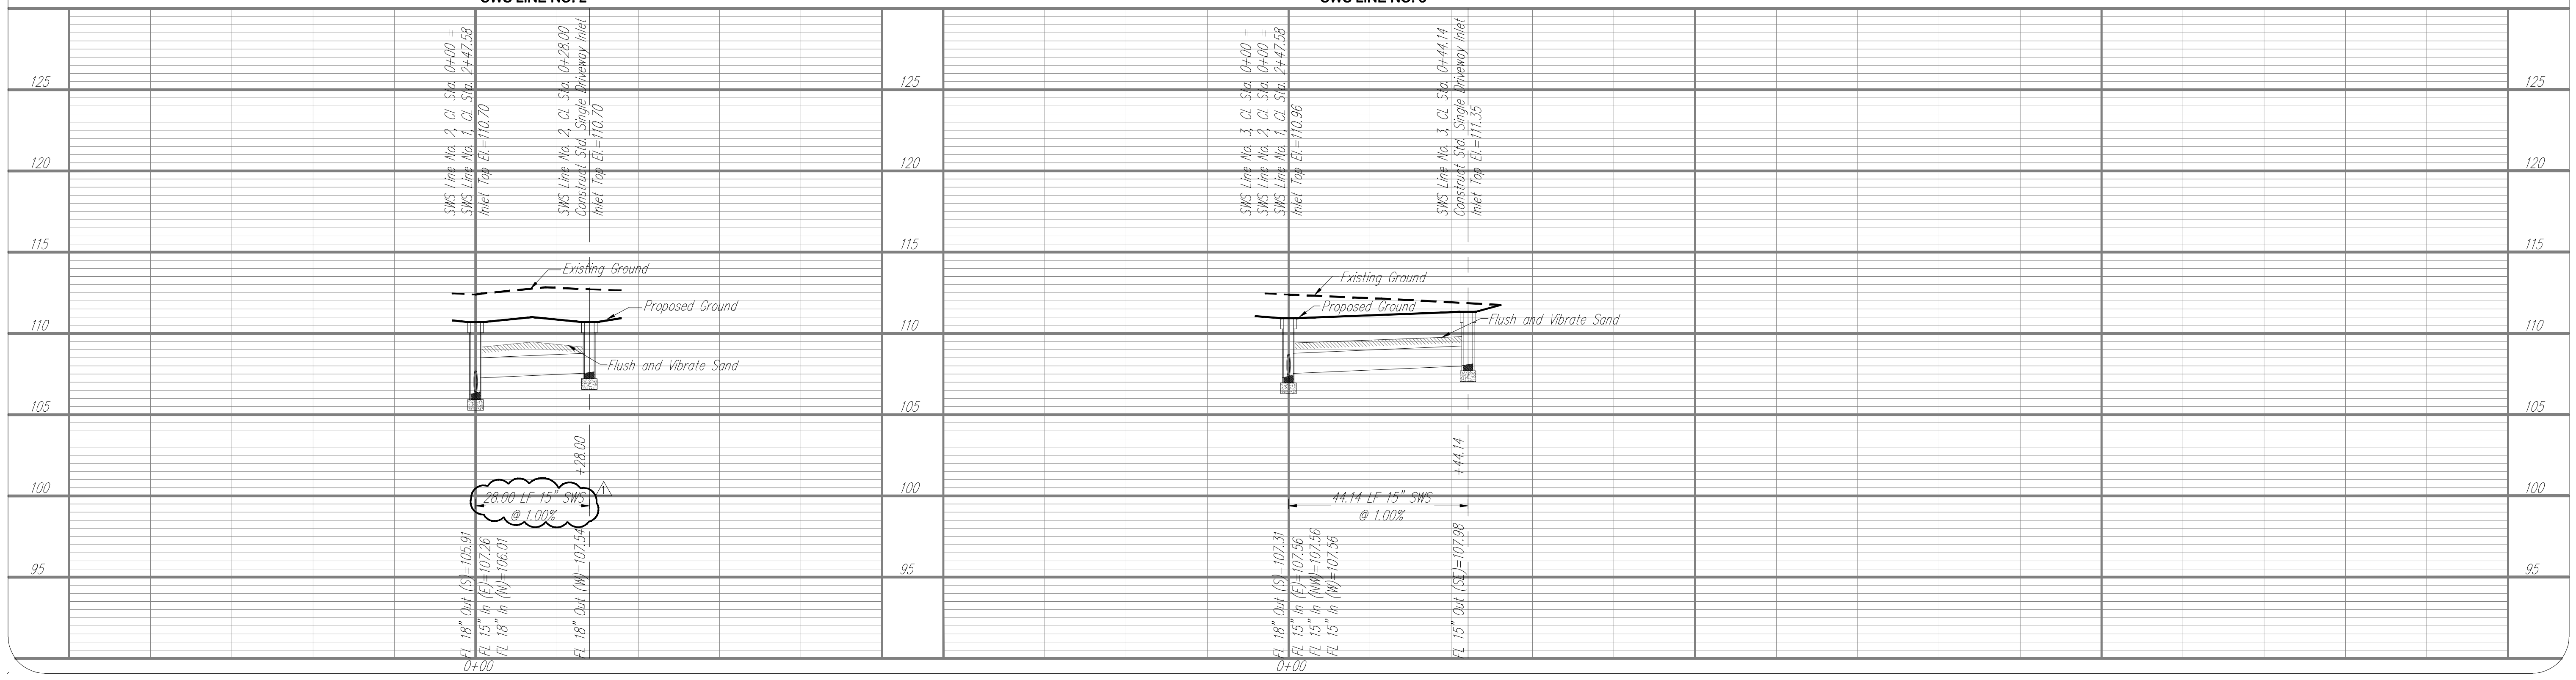

**YOUNG & ASSOCIATES, P.A.**  
 Civil Engineering • Surveying • Land Development  
 100 S. Georgia, Derby, KS 67037  
 Tele: (316)788-2552, Fax: (316)788-4408, email: engineering@yngpa.com

Copyright 2009, by Young & Associates, P.A., all rights reserved. Prepared in the United States of America. This document, or parts thereof, or design concepts contained herein, are deemed confidential and proprietary information of Young & Associates, P.A., and may not be reproduced, stored in a retrieval system, or transmitted in any form or by any means, electronic, mechanical, photocopying, recording, or otherwise, without the prior written permission of Young & Associates, P.A. The delivery of the original or copies thereof does not constitute professional service.

**SWS LINE NO. 2 & NO. 3 - PLAN & PROFILE**

Street and Storm Sewer Improvements  
 Mead Street, from Central to 3rd Street  
 City of Wichita  
 Sedgewick County, Kansas

scale: as noted  
 drawn by: CAC  
 checked by: CRY  
 date: 9/9/08  
 P/N: 07-246  
 revisions:  
 1/6/09