


SCALE 1" = 40' HORIZ.
1" = 5' VERT.
IRON = ●

Ruggles & Polina P.A.
Engineering, Surveying, Land Planning
524 North Main, Suite 204-006
Wichita, Kansas 67203
www.ruggles.com
E-mail: ruggles@ruggles.com

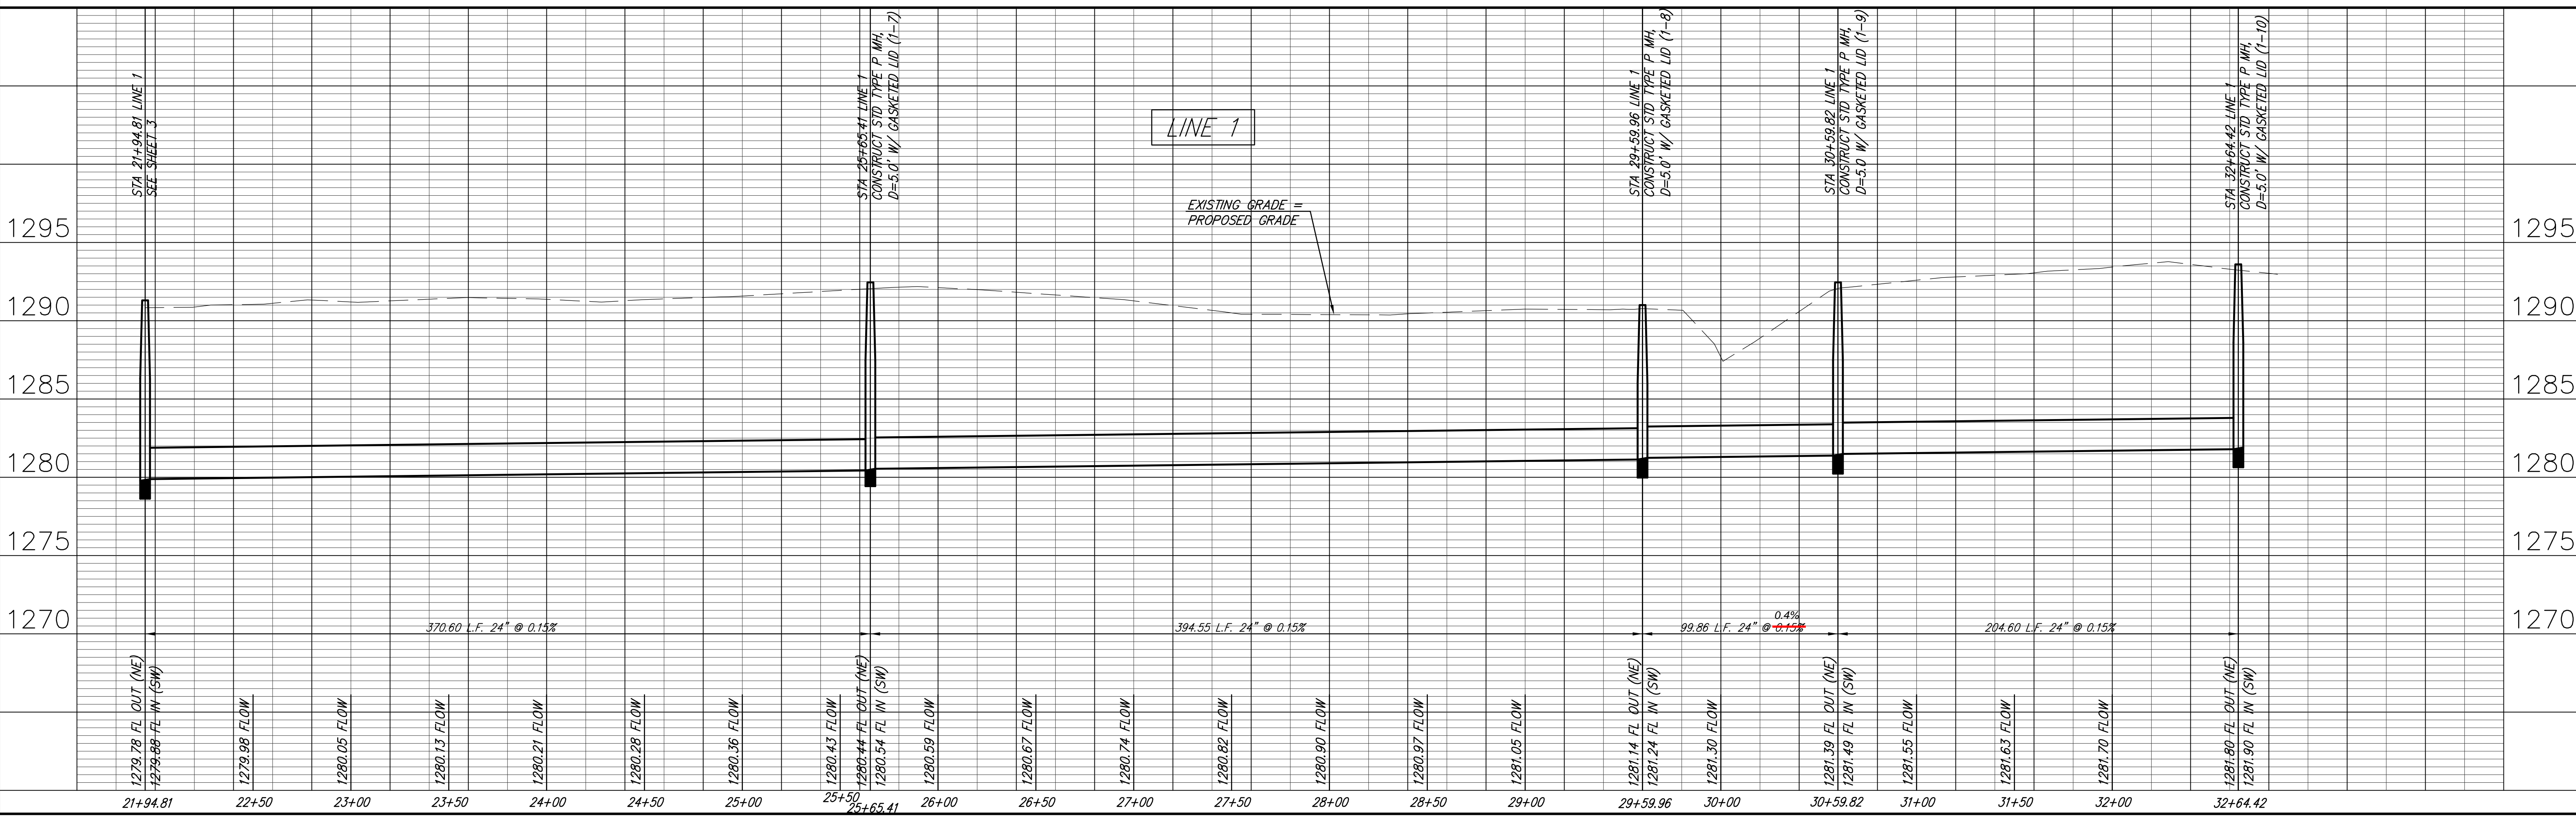

**SOUTHEAST INTERCEPTOR
Sanitary Sewer
WICHITA, KANSAS**

PROJECT NUMBER 468-84240	DESIGN EG	DATE May 10, 2007	REVISION MLP	REVIEW DATE
DRAWING FILE ENG BASE 1B1	UTILITY			

RB JOB NO. 2973X
SHEET 4 OF 20