



Ernest & Barbara  
McClellan Living Trust

ALL TREES ON THE MCCLELLAN PROPERTY SHALL BE PROTECTED FROM ANY DAMAGE. IF, IN THE OPINION OF THE CONTRACTOR, THE ALIGNMENT SHALL ENCROACH ON THE TREES, HE SHALL IMMEDIATELY CONTACT THE ENGINEER TO CONSIDER POSSIBLE ALIGNMENT CHANGES. THE CONTRACTOR SHALL KEEP ALL EQUIPMENT AND PERSONNEL CLEAR OF THE DRIPLINE OF THE TREES.

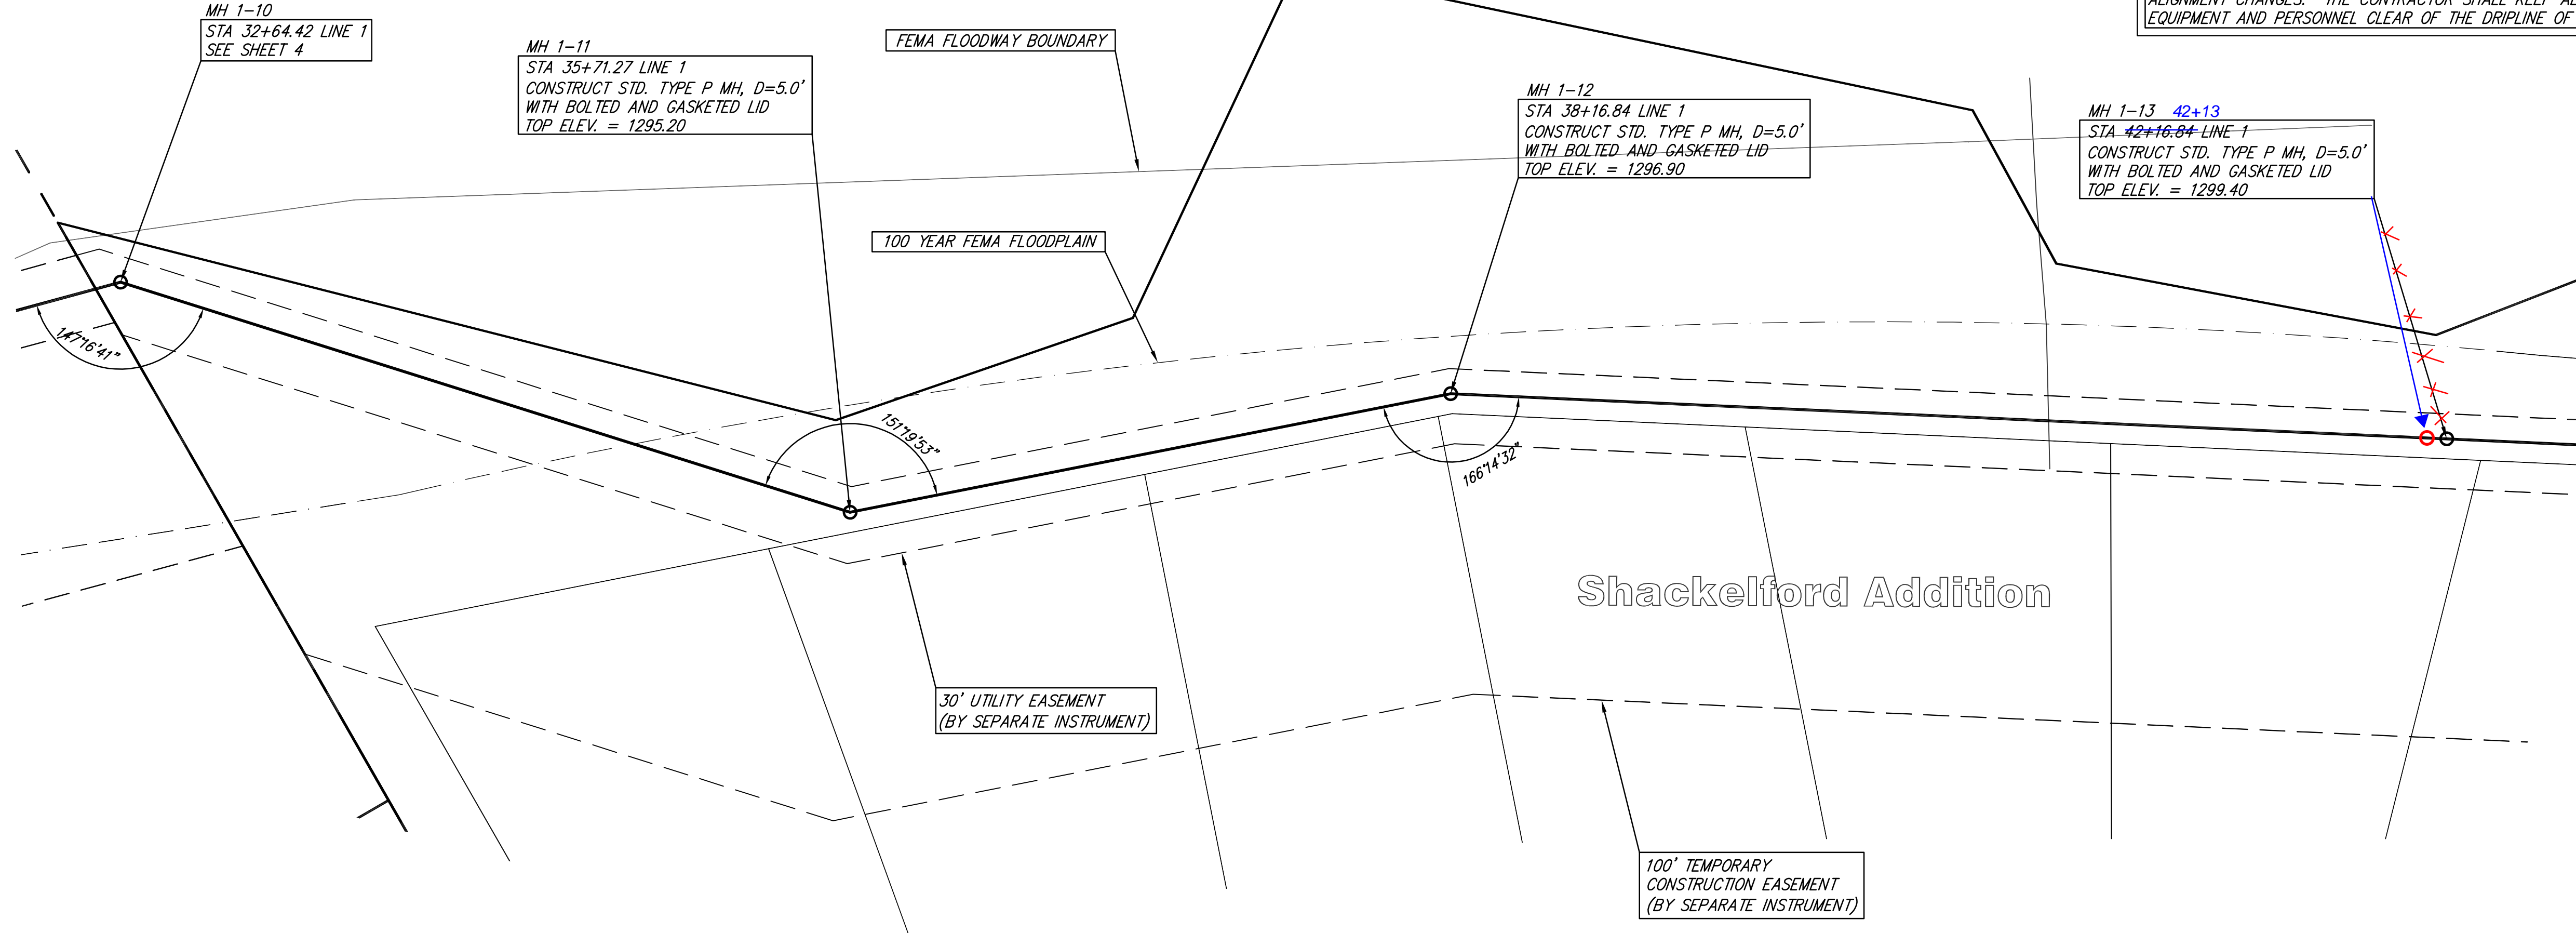

SCALE 1" = 40' HORIZ.  
1" = 5' VERT.  
IRON = ●

Ruggles & Polina, P.A.  
Engineering, Surveying, Land Planning  
502 North Main, Suite 204-206  
Wichita, Kansas 67203  
www.ruggles.com

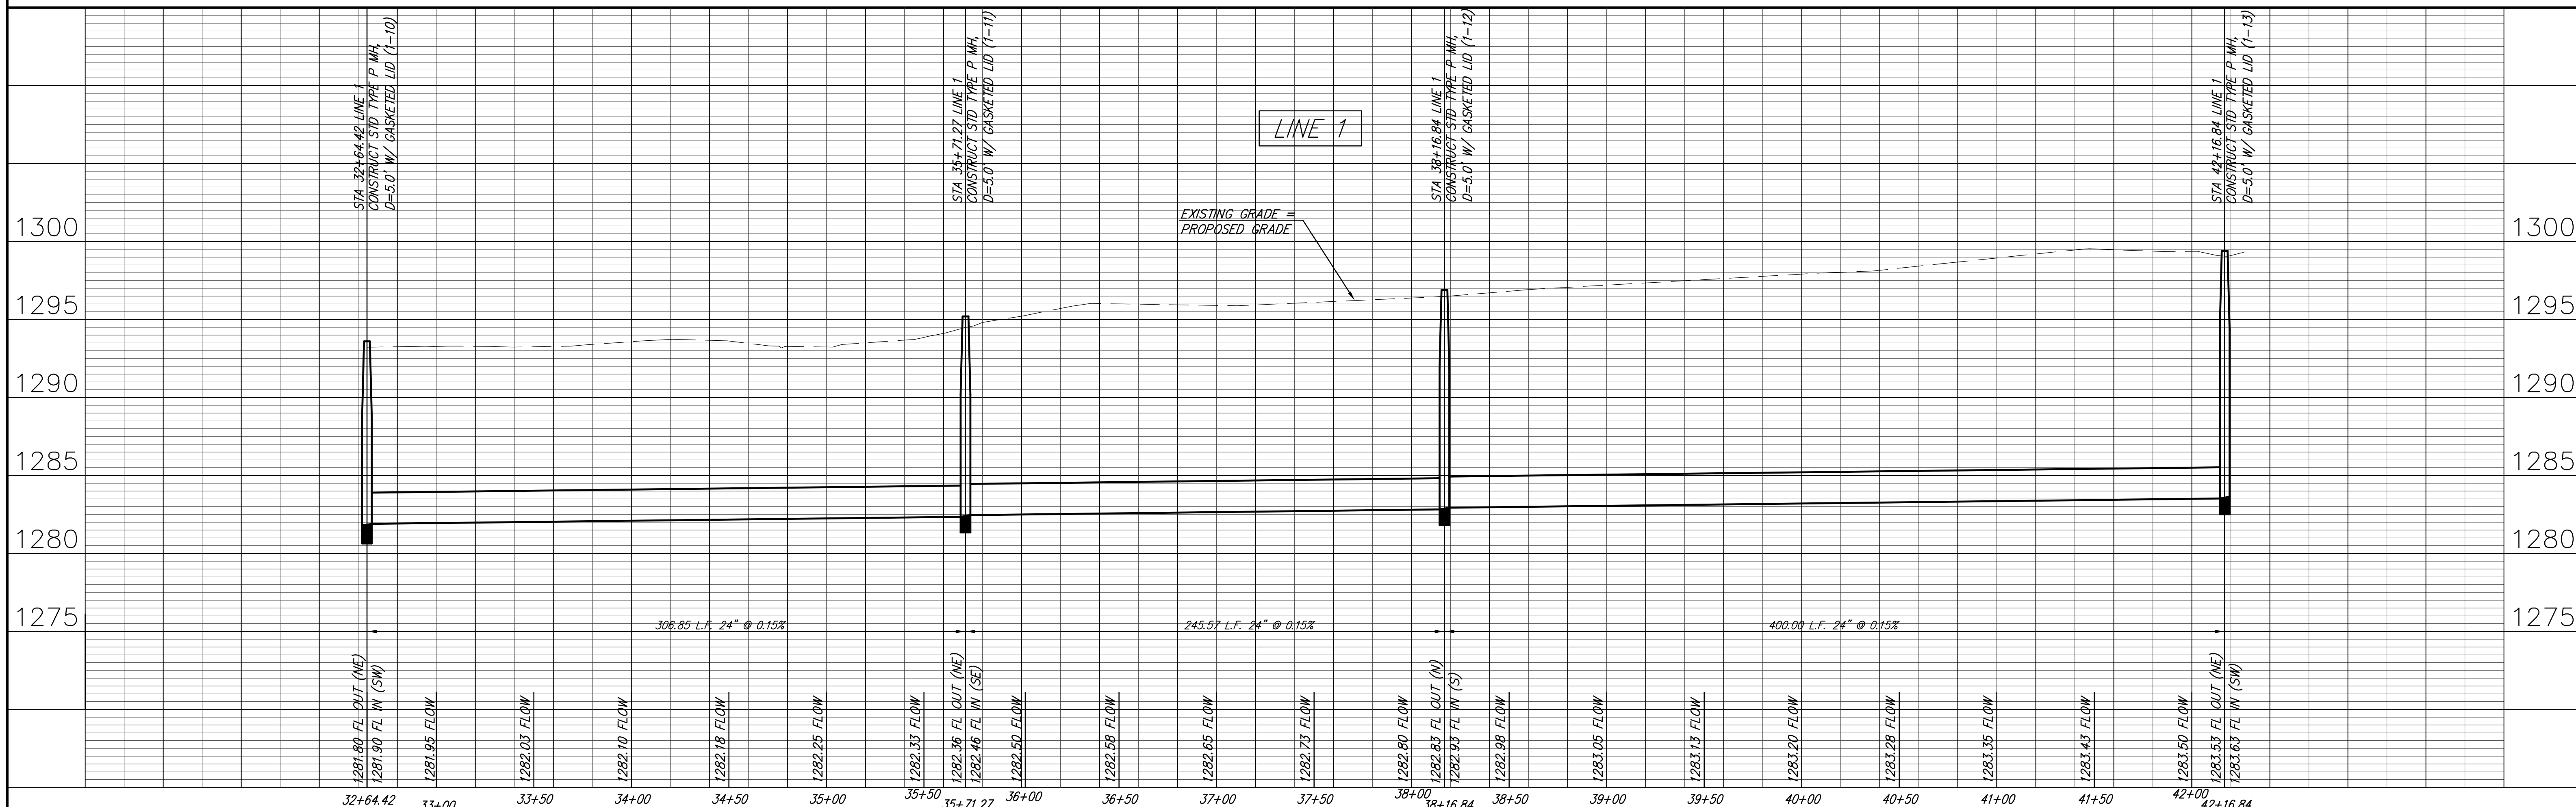

PROJECT NUMBER: 468-84240  
DESIGN: EUG  
DRAWING FILE: [blank]  
ENG BASE: 1CJ

DESIGN: EUG  
MAY 10, 2007  
REVIEW: [blank]

SOUTHEAST INTERCEPTOR  
Sanitary Sewer  
WICHITA, KANSAS

20