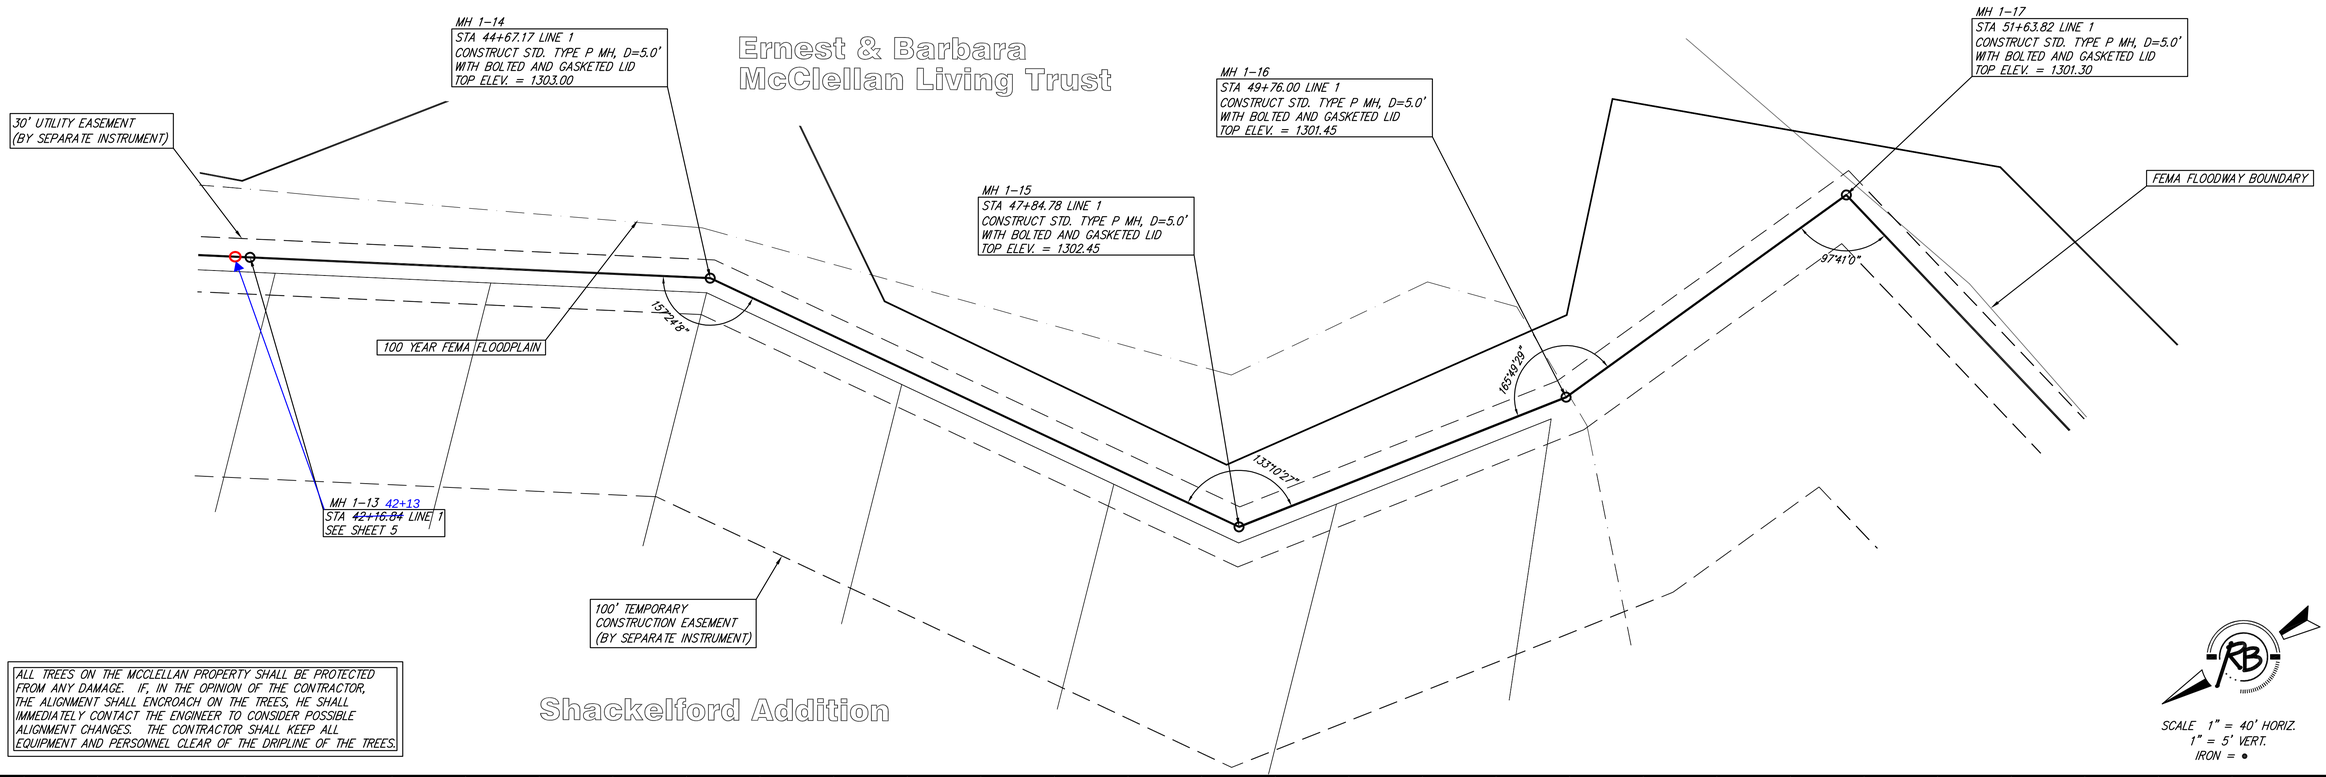

Ruggles & Bohm, P.A.
Engineering, Surveying, Land Planning
(316) 264-6005
(316) 264-6006
806 North Main
Wichita, Kansas 67203
www.rbkansas.com
E-mail: info@rbkansas.com

REVISED	
REVIEW	
DESIGN	EJG
DRAWN	MLP
UTILITY	
DATE	May. 10, 2007
PROJECT NUMBER	468–84240
DRAWING FILE	ENG BASE {1D}

SOUTHEAST INTERCEPTOR
Sanitary Sewer
WICHITA, KANSAS

RB JOB 2973X

SHEET 6 OF 20