





SCALE 1" = 40' HORIZ.  
1" = 5' VERT.  
IRON = ●

USD 259

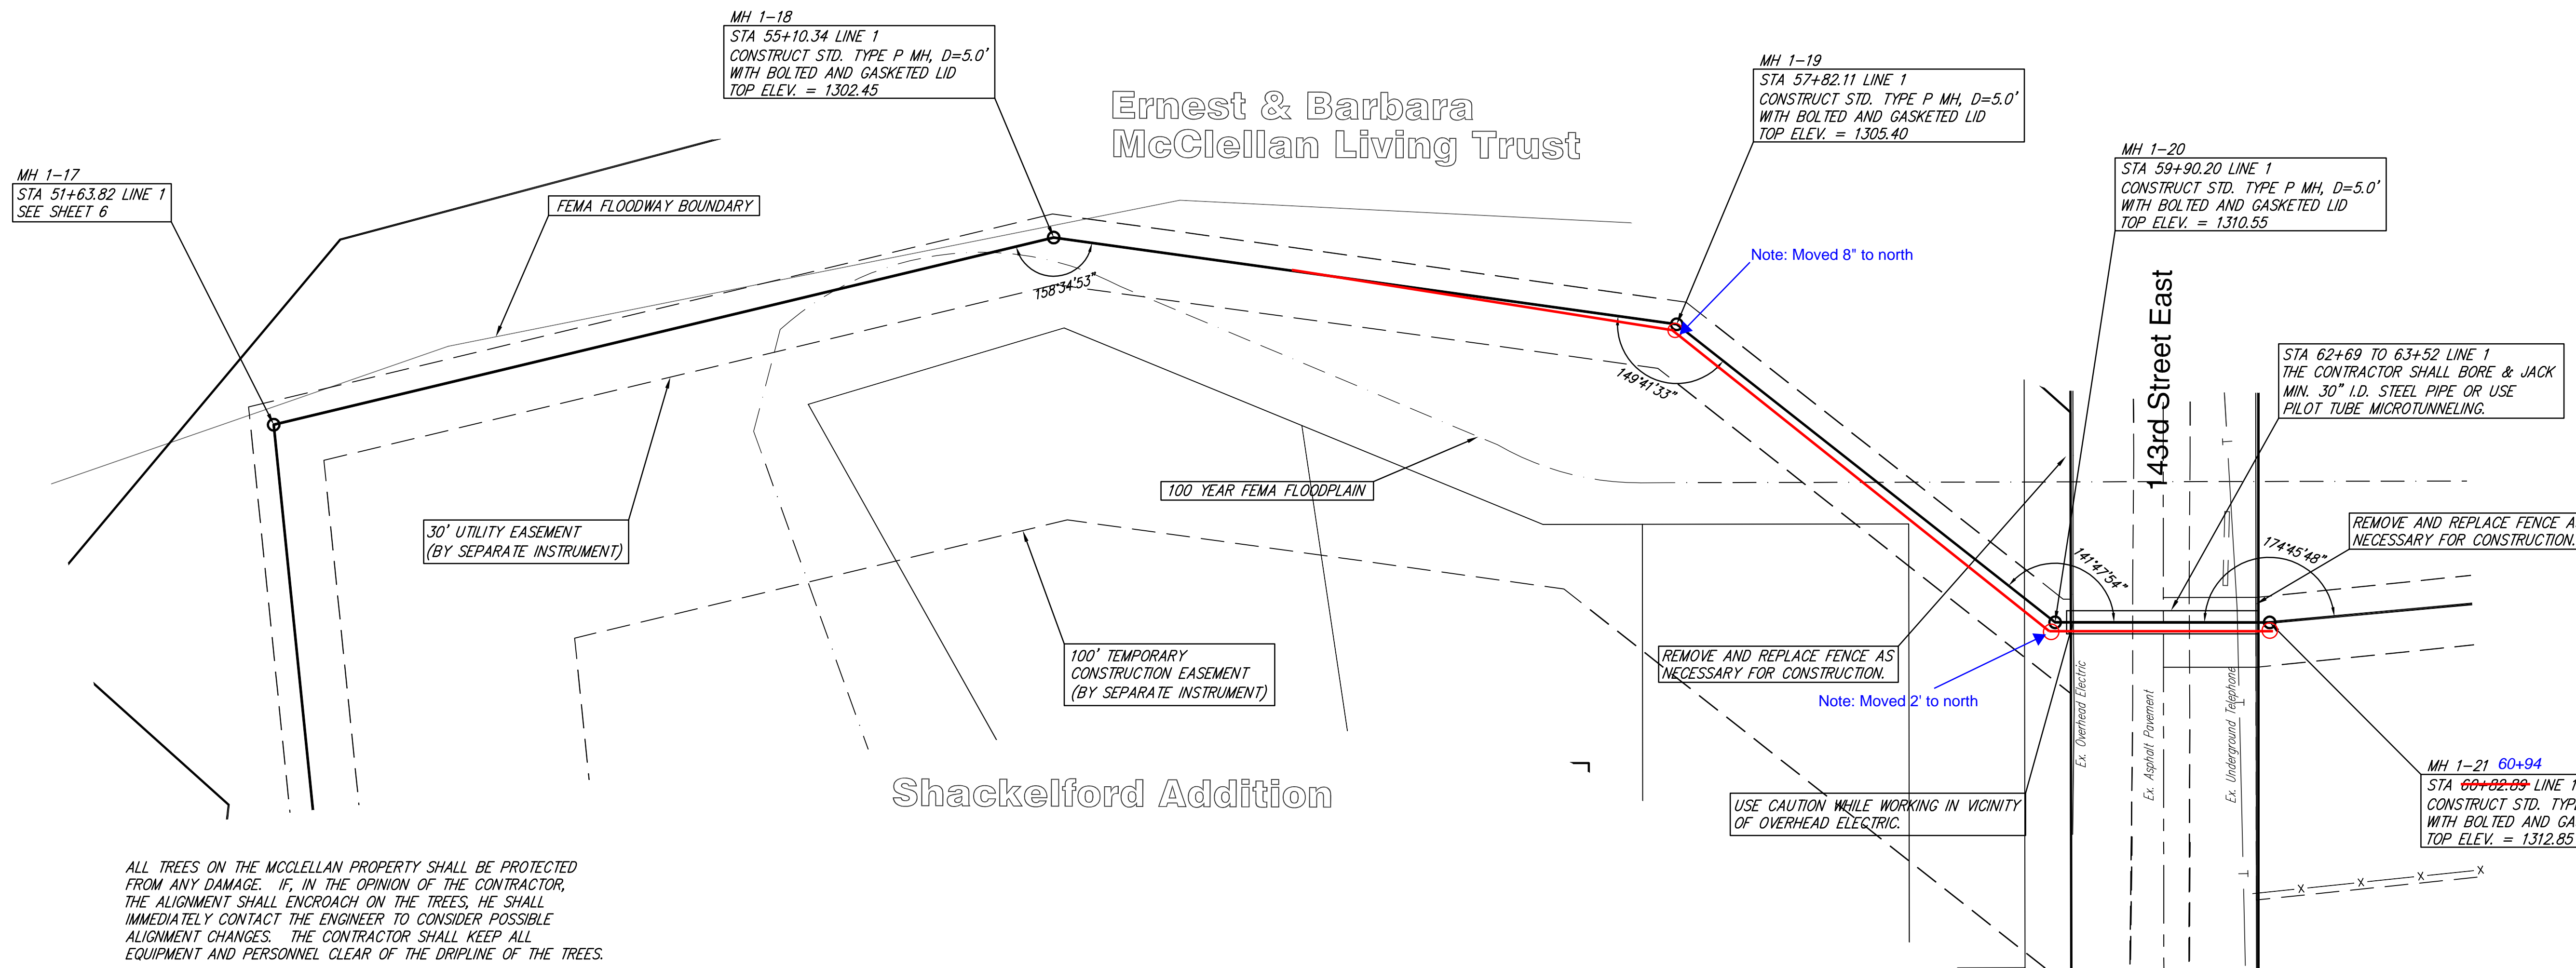

ALL TREES ON THE MCCLELLAN PROPERTY SHALL BE PROTECTED FROM ANY DAMAGE. IF, IN THE OPINION OF THE CONTRACTOR, THE ALIGNMENT SHALL ENCR OACH ON THE TREES, HE SHALL IMMEDIATELY CONTACT THE ENGINEER TO CONSIDER POSSIBLE ALIGNMENT CHANGES. THE CONTRACTOR SHALL KEEP ALL EQUIPMENT AND PERSONNEL CLEAR OF THE DRIPLINE OF THE TREES.

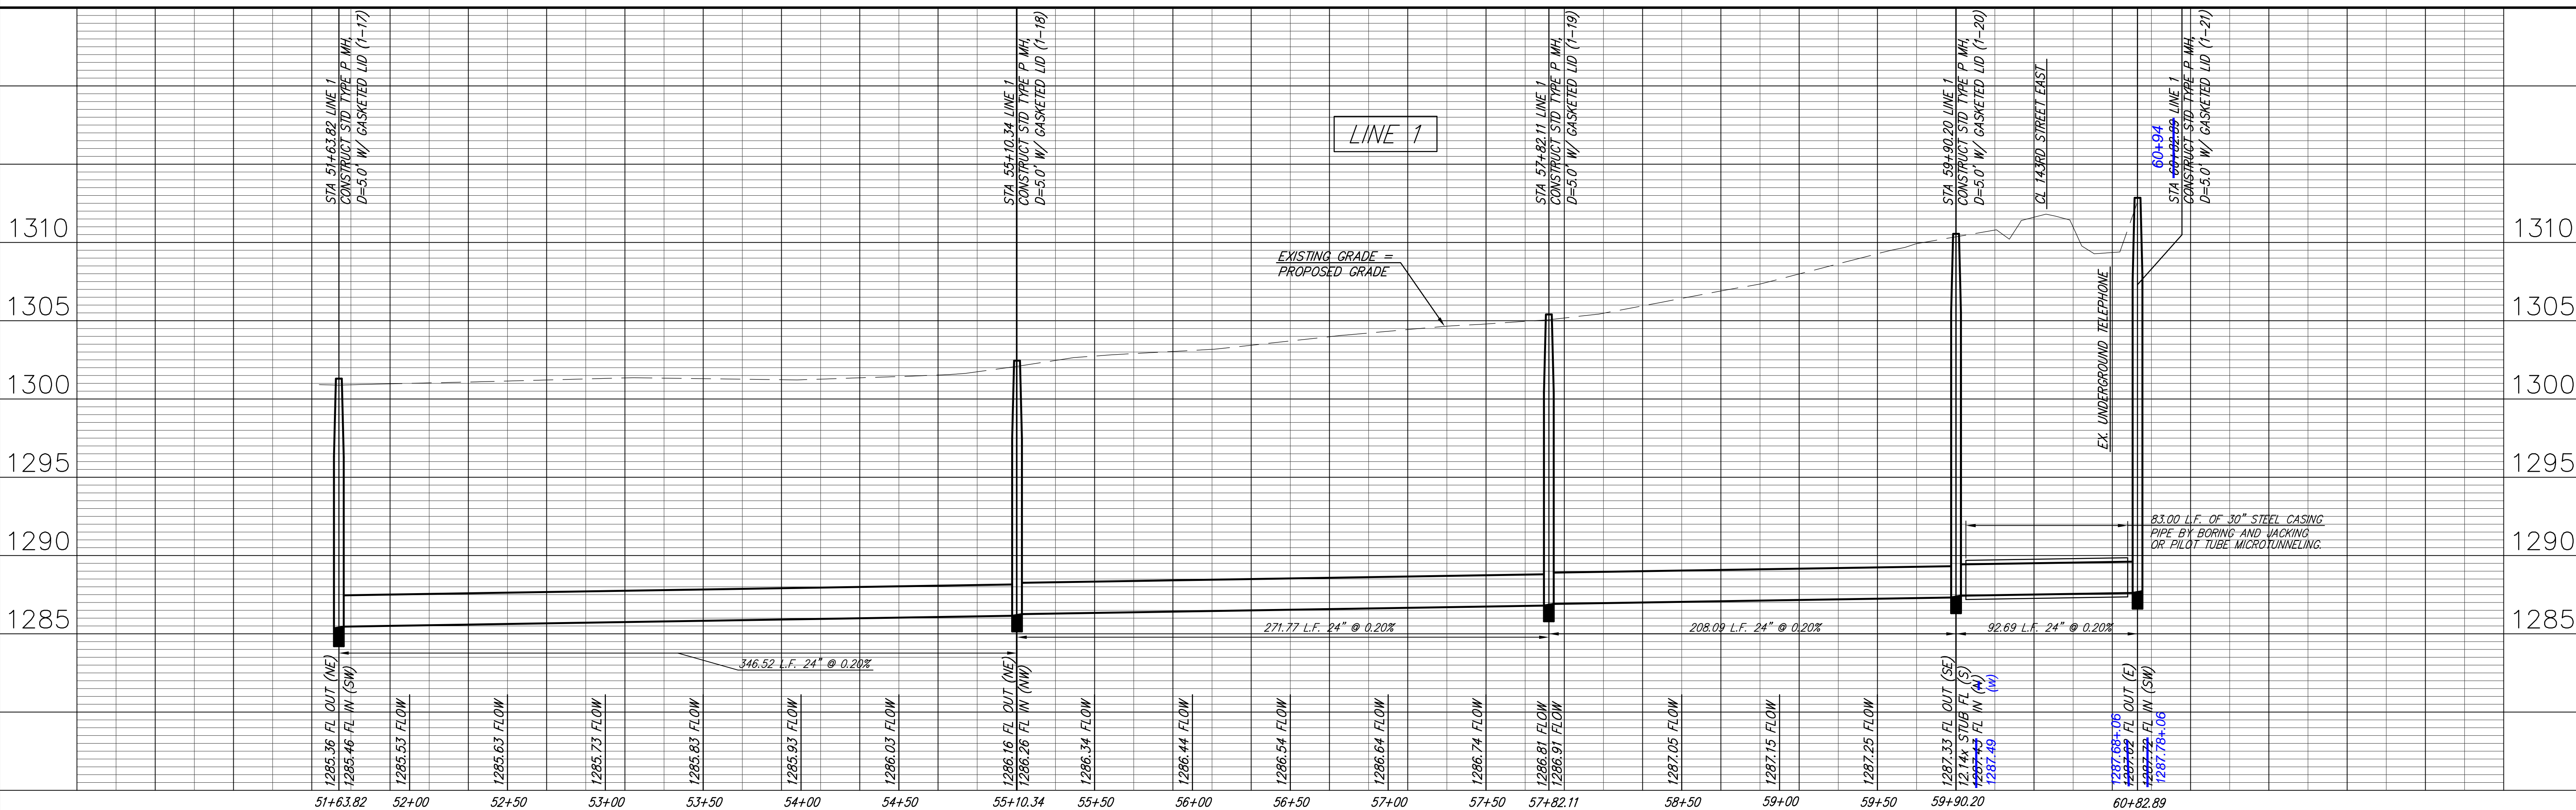

REVISIONS  
 1. DATE: May 10, 2007  



DESIGN: EJC  
 DRAWN: MLP  
 CHECKED: [Signature]  
 DATE: May 10, 2007

PROJECT NUMBER: 468-84240  

SOUTHEAST INTERCEPTOR  
 Sanitary Sewer  
 WICHITA, KANSAS

RB JOB: 2973X  
 SHEET: 7 OF 20