Scale 1" = 40' (Horiz.)
1" = 5' (Vert.)

VINCE GARCIA ADDITION

HERITAGE BAPTIST CHURCH ADDITION

COPPERGATE ADDITION

Vincent & Jane Garcia
1522 N. 135th St. W.

Heritage Baptist Church
13500 W. 13th St. N.

Kelsey Investments, Inc.
716 N. 119th St. W #112

existing pond

40' Drainage Reserve

100' Drainage Easement

20' Utility Easement

70' Construction Easement

10' Utility Easement

135th Street West

A.C. Pavement

13th Street North

A.C. Pavement

Existing 12" Force Main

6" RWD Water Main

6" Aquila Gas Main

BL Sta. 57+50.23, 50' Lt.

BL Sta. 59+11.23, 50' Lt.

BL Sta. 60+11.48, 75' Lt.

BL Sta. 61+86.57, 75' Lt.

BL Sta. 62+62.22

County Disk

Water Line Sign

FORCE MAIN CONNECTION.
SEE SHEETS 11 & 13
FOR DETAILS

WESTAR MH

MH-17
STA. 44+27.41 LINE 1
BL STA. 52+78.89, 50.0' RT.
CONSTRUCT 5' DIA. LINED MH TYPE P
TOP = 1355.0

MH-18
STA. 47+52.41 LINE 1
BL STA. 56+03.89, 50.0' RT.
CONSTRUCT 5' DIA. LINED MH TYPE P
TOP = 1353.5

MH-19
STA. 51+52.42 LINE 1
BL STA. 60+03.89, 50.0' RT.
CONSTRUCT 5' DIA. LINED MH TYPE P
TOP = 1353.8

MH-20
STA. 52+87.25 LINE 1
BL STA. 61+37.22, 70.0' RT.
CONSTRUCT 5' DIA. LINED MH TYPE 'P' OUTSIDE DROP
CONNECT TO LINE EAST. SEE DETAIL SH 11
TOP = 1354.4

MH-21
STA. 55+12.60 LINE 1
BL STA. 63+62.57, 70.0' RT.
CONSTRUCT 5' DIA. LINED MH TYPE P
TOP = 1355.8

Note: 36" casing moved 5 ft. north to keep WL from hanging in air.

STA. 53+20 TO 55+00, Line 1

~~STA. 53+25 to 55+05 LINE 1~~
INSTALL 180 L.F. STEEL CASING
PIPE BY BORING AND JACKING

NOTE : SS MAIN NORTH OF STA. 55+12.60
SHALL BE PLACED IN SERVICE PRIOR TO
CONSTRUCTION CONTINUING SOUTH.

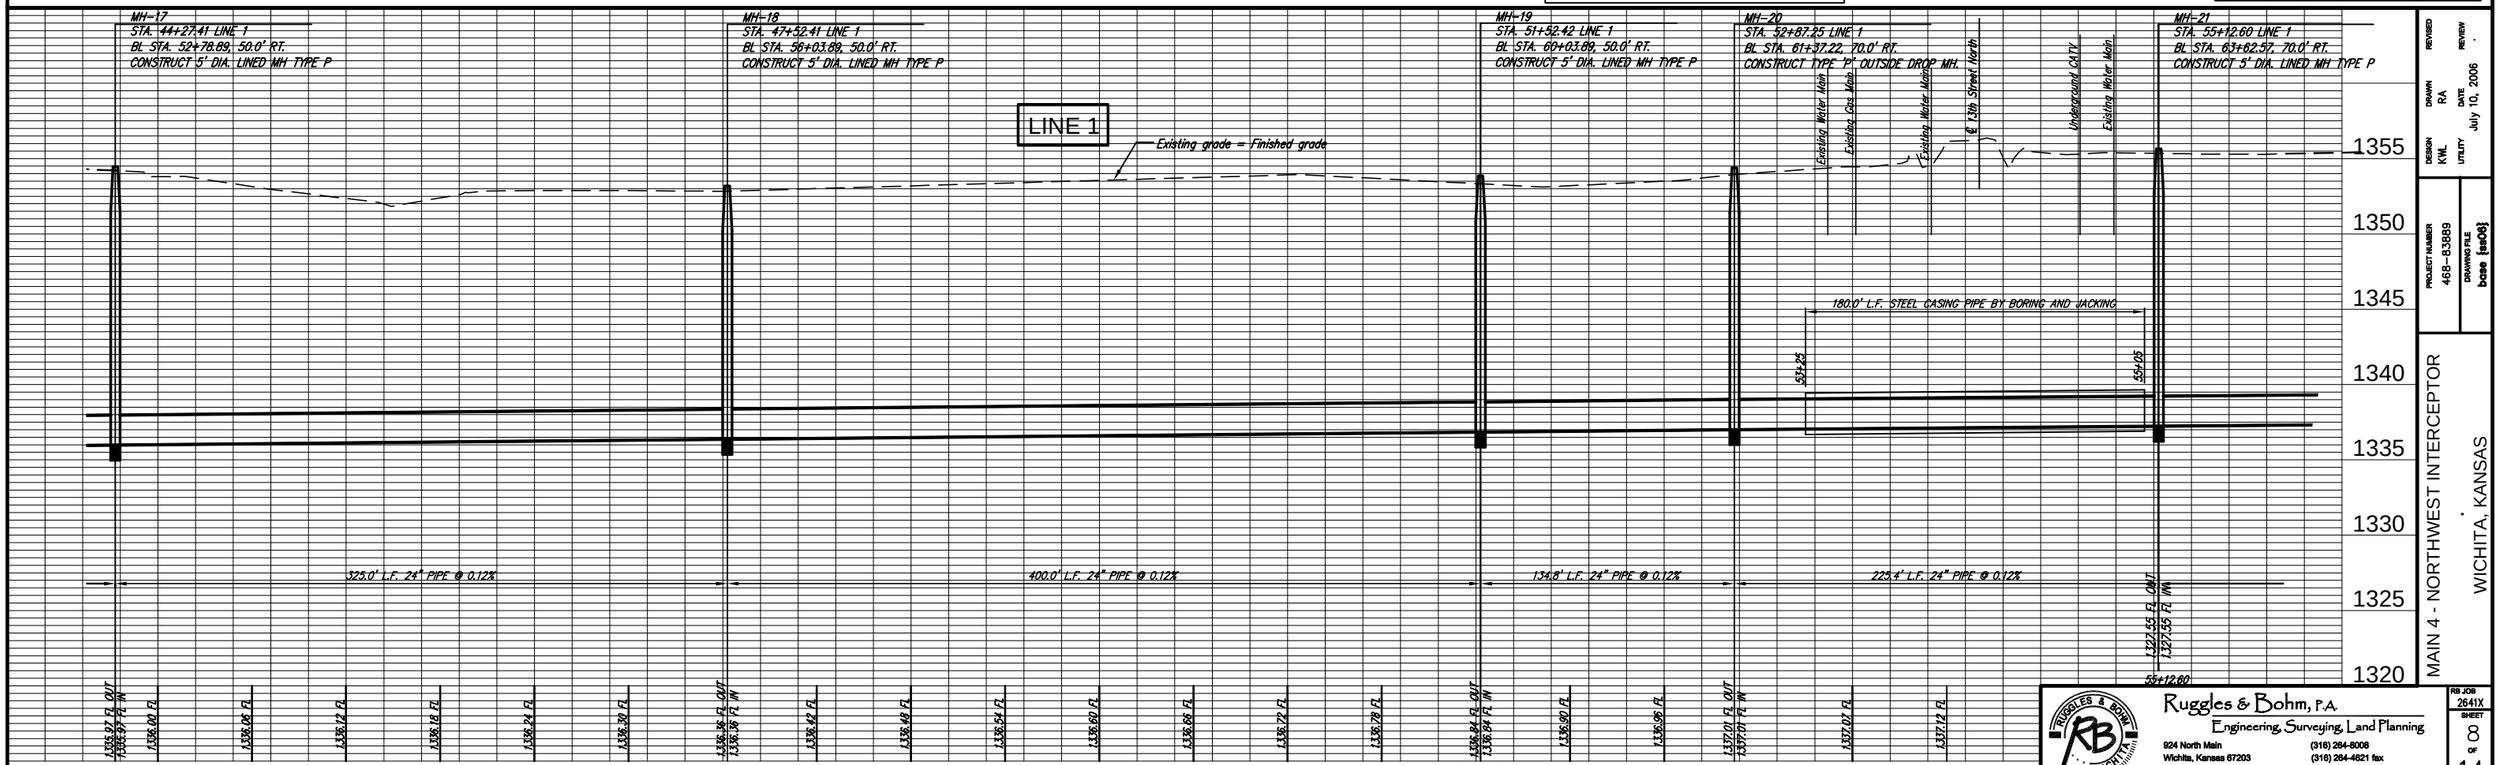

Ruggles & Bohm, P.A.
Engineering, Surveying, Land Planning
924 North Main
Wichita, Kansas 67203
www.rbkansas.com
(316) 264-8008
(316) 264-4621 fax
E-mail: info@rbkansas.com

REVISED	
REVIEW	
DRAWN	RA
DATE	July 10, 2006
DESIGN	KML
UTILITY	
PROJECT NUMBER	468-83889
DRAWING FILE	bcase [sst06]
RB JOB	2641X
SHEET	8 of 14

MAIN 4 - NORTHWEST INTERCEPTOR
WICHITA, KANSAS