STORM WATER SEWER & POND TO SERVE

Killarney Plaza First Addition

Part of Lot 1, Block 1

Private Project Number: 1894 PPS (607861)

CITY OF WICHITA, KANSAS

James Armour, P.E. City Engineer

September 2008

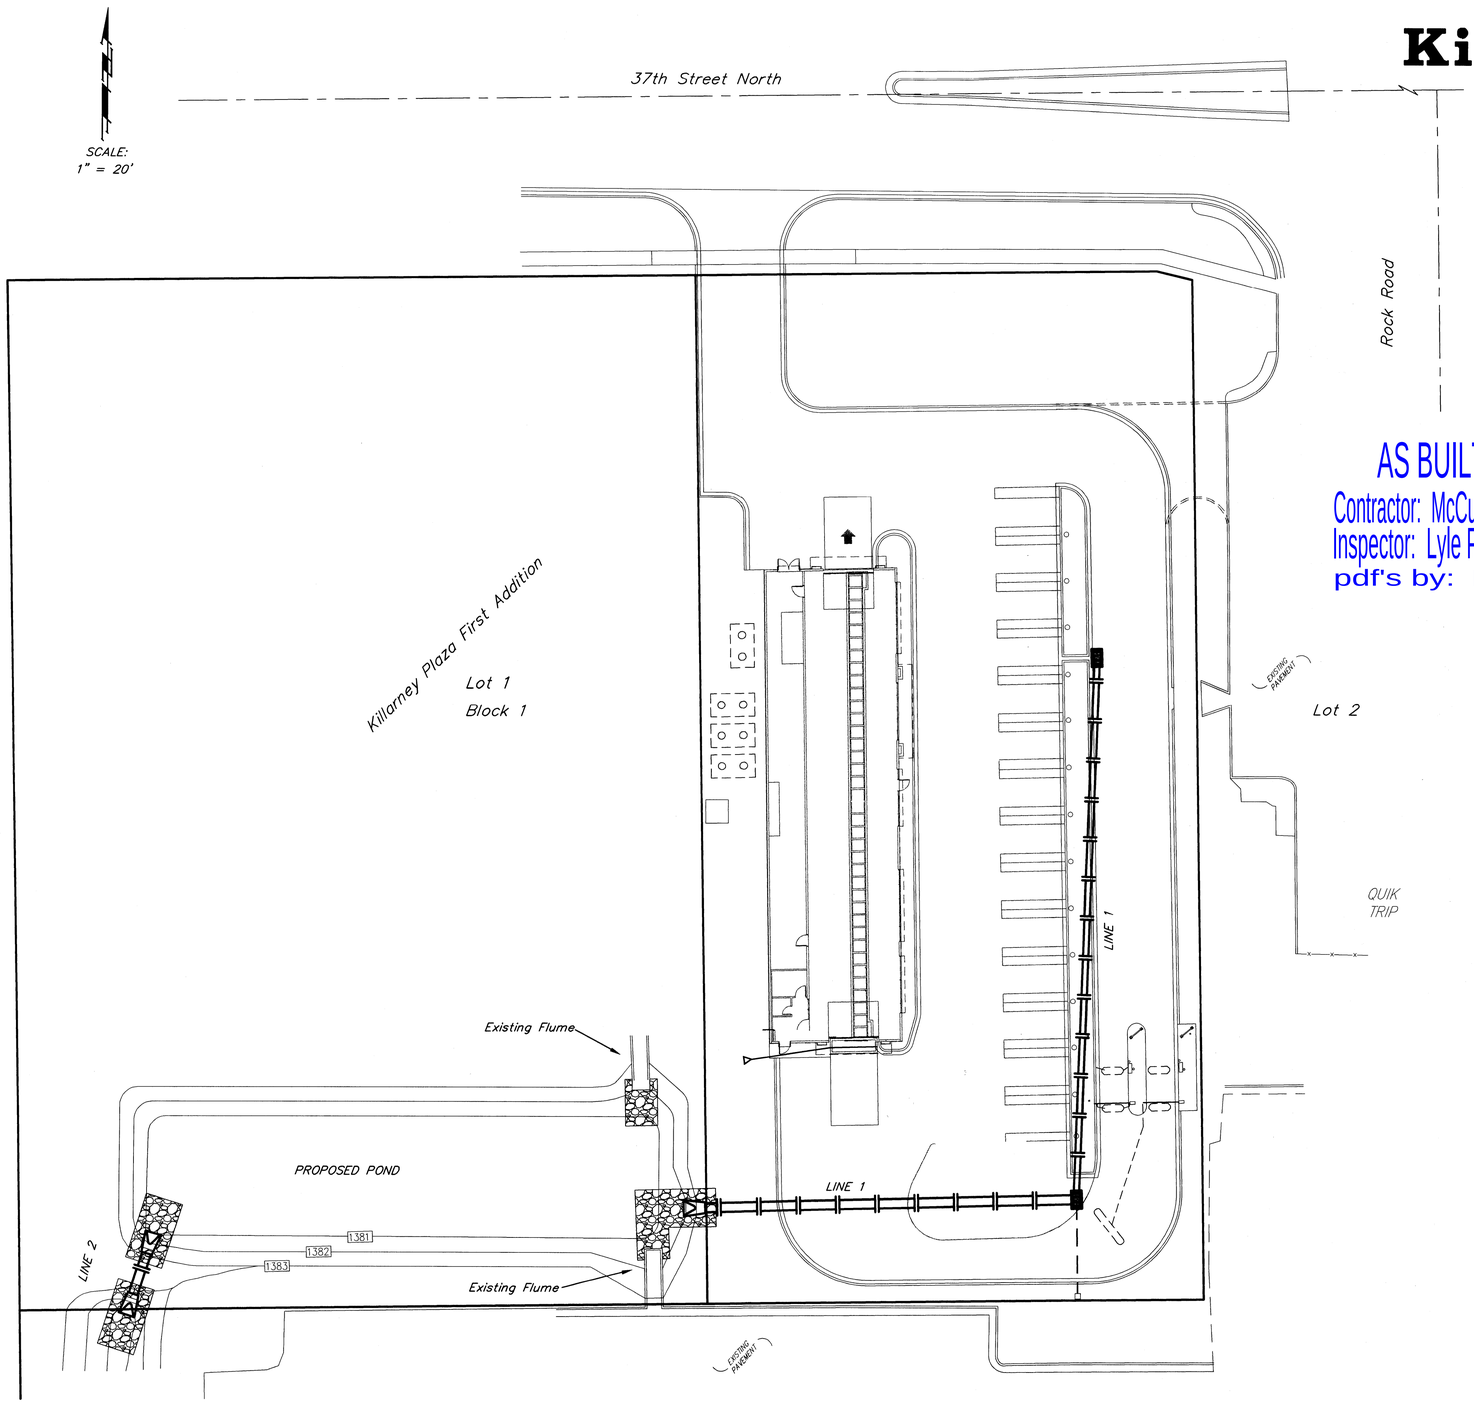

Bench Mark:

"□" Chiseled on Top of Curb Approx. 21' North of NE Property Corner of Lot 1, Block 1 Killarney Plaza First Addition to Wichita, Sedgwick Country, Kansas.

Elev. = 1389.58 NGVD 29

AS BUILT PLANS

Contractor: McCullough Excavating

Inspector: Lyle Powers, Baughman Co.

pdf's by: Ken Klag

Index

Title Sheet	1
Plan/Profile Sheet– Line 1	2
Plan/Profile Sheet– Line 2	3
Pond Plan	4
Copy Of Plat	5
Drop Inlet Detail	Available On Request
BMP Erosion Details	Available On Request

Legal Description

A portion of Lot 1, Block 1 Killarney Plaza First Addition to Wichita, Sedgwick County, Kansas

APPROVED AS NOTED
BY CITY ENGINEER OF WICHITA

Storm Sewers Juliann Kellman 9-23-08

NOTE TO CONTRACTORS

Installation, inspection and testing for this project is to be provided by a Licensed Consulting Engineering Firm under contract with the Owner/Developer. Said Inspection to be in accordance with the City of Wichita standard construction engineering practices and certified by a Licensed Professional Engineer. No work shall be performed in dedicated easements or public right-of-way by the Contractor without such inspection nor shall any work be commenced without written authorization by the City Engineer. All Construction and Materials shall comply with the City of Wichita Specifications and Standards (on file and available in the City Engineer's Office).

Location Map

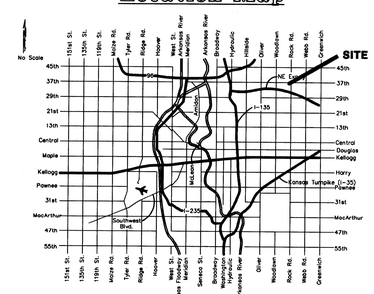

Baughman

Baughman Company, P.A. 315 Ellis St. Wichita, KS 67211 P 316-262-7271 F 316-262-0149
ENGINEERING | SURVEYING | PLANNING | LANDSCAPE ARCHITECTURE