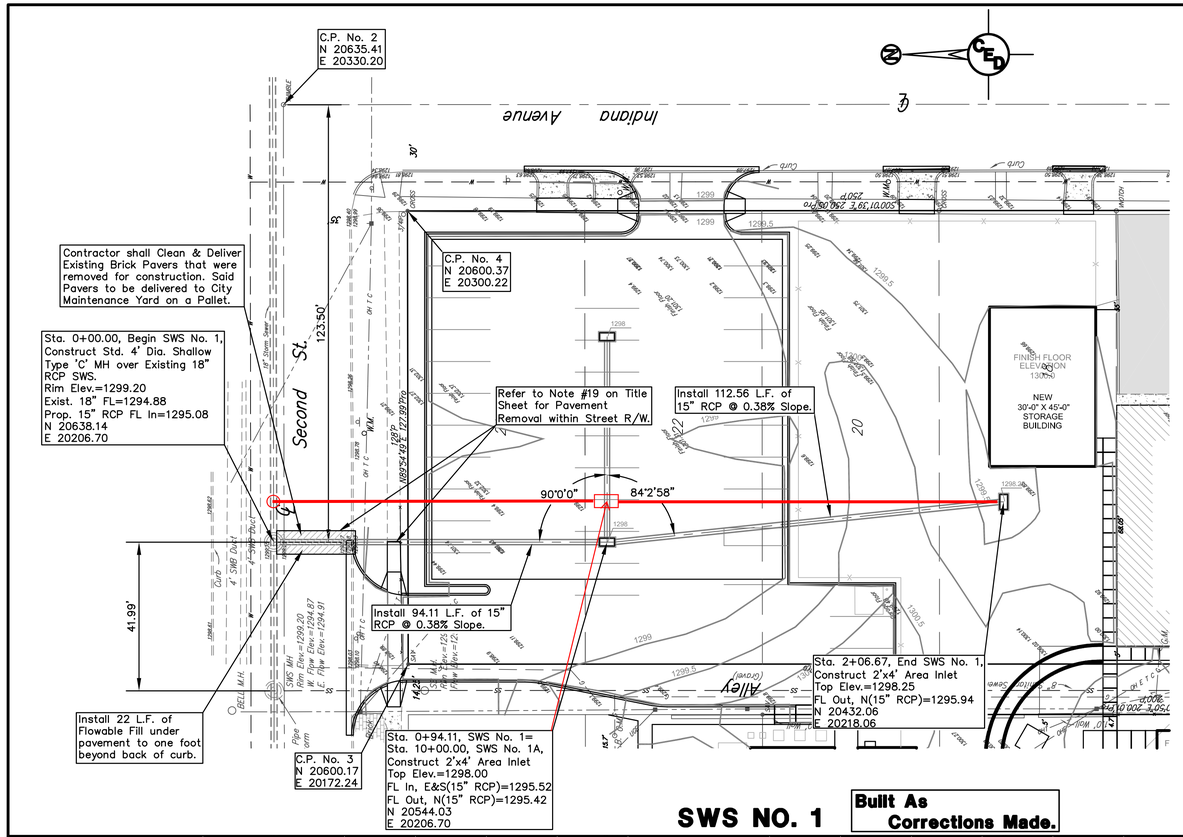

SWS NO. 1

Built As Corrections Made.

UTILITIES SHOWN REPRESENT THE BEST INFORMATION AVAILABLE FOR DESIGN. ADDITIONAL UTILITIES MAY BE PRESENT ON THIS PROJECT. THE CONTRACTOR SHALL BE RESPONSIBLE FOR DETERMINING THE EXACT LOCATION, DEPTH AND SIZE OF ALL UNDERGROUND UTILITIES PRIOR TO CONSTRUCTION. THE CONTRACTOR SHALL BE LIABLE FOR ANY DAMAGE CAUSED BY THE FAILURE TO DO SO.

GRAPHIC SCALE

20 0 10 20 40

(IN FEET)
1 inch = 20 ft.

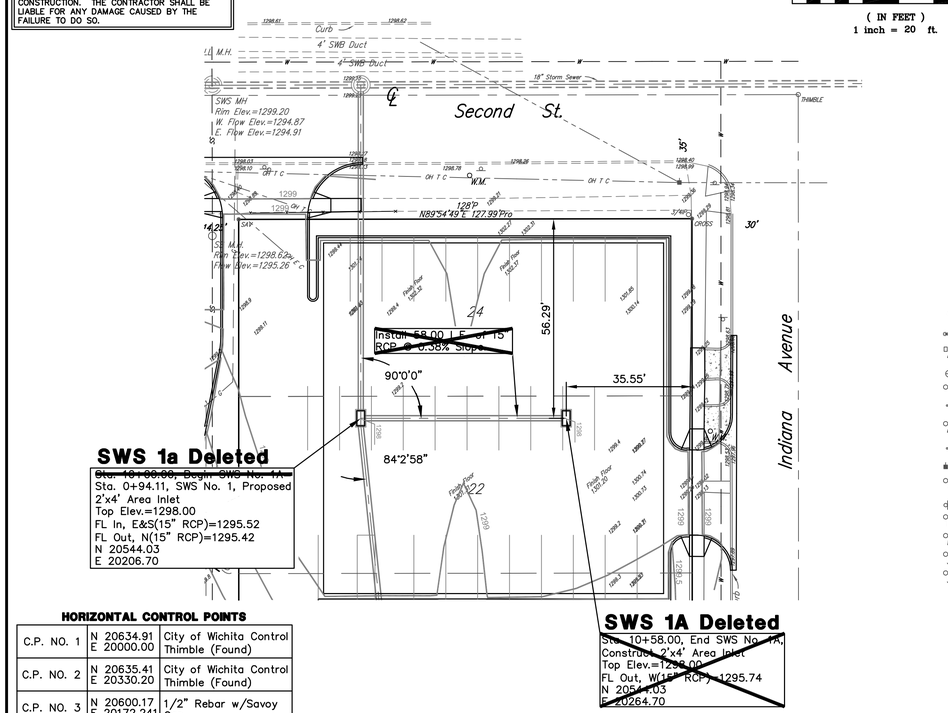

Reference B.M.; City of Wichita Std Disc. N.E. Cor. 1st St. & Washington Elevation = 1298.39 NGVD

On Site B.M.; Chiseled Cross @ S.W. Cor. Lot 15, on Ohio St., Mathewsons 3rd Addition Elevation = 1299.36 NGVD

LEGEND

G = GAS MAIN
W = WATER MAIN
SS = SANITARY SEWER
SWS = STORM WATER SEWER
UGE = UNDER GROUND ELECTRIC
UGT = UNDER GROUND TELEPHONE
OHE = OVERHEAD ELECTRIC
OHT = OVERHEAD TELEPHONE
OHC = OVERHEAD CABLE TELEVISION

BASKETBALL GOAL
E.B. . . . . ELECTRIC BOX
GUY ANCHOR
G.M. . . . . GAS METER
G.P. . . . . GUARD POST
L.P. . . . . LIGHT POLE
POST
POWER POLE
RD . . . . . ROOF DRAIN
SIGN
WELL . . . . . WATER WELL
W.M. . . . . WATER METER
SS M.H. . . . . SANITARY SEWER MANHOLE
SWS M.H. . . . . STORM WATER SEWER MANHOLE

SURVEY MARKER LEGEND

THIMBLE = CITY OF WICHITA CONTROL THIMBLE (FOUND)
3/4" = 3/4" IRON PIPE (FOUND)
CROSS = CHISELED CROSS IN CONCRETE (FOUND)
VNOTCH = CHISELED "V" NOTCH IN CONCRETE (FOUND)
SAV = 1/2" REBAR W/SAVOY CAP (SET)
CROSS = CHISELED CROSS IN CONCRETE (SET)
VNOTCH = CHISELED "V" NOTCH IN CONCRETE (SET)

HORIZONTAL CONTROL POINTS

C.P. NO. 1	N 20634.91 E 20000.00	City of Wichita Control Thimble (Found)
C.P. NO. 2	N 20635.41 E 20330.20	City of Wichita Control Thimble (Found)
C.P. NO. 3	N 20600.17 E 20172.241	1/2" Rebar w/Savoy Cap
C.P. NO. 4	N 20600.37 E 20300.22	Chiseled Cross in Concrete

SWS NO. 1A

SWS Line 1A deleted during construction.

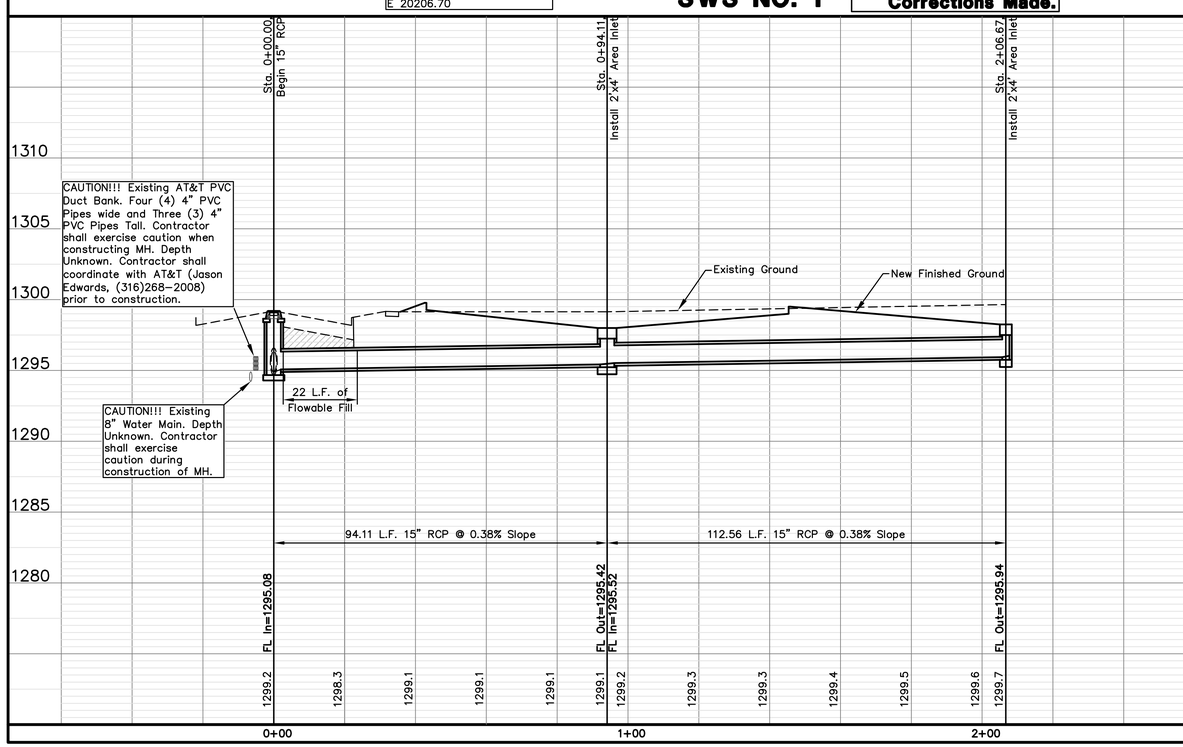

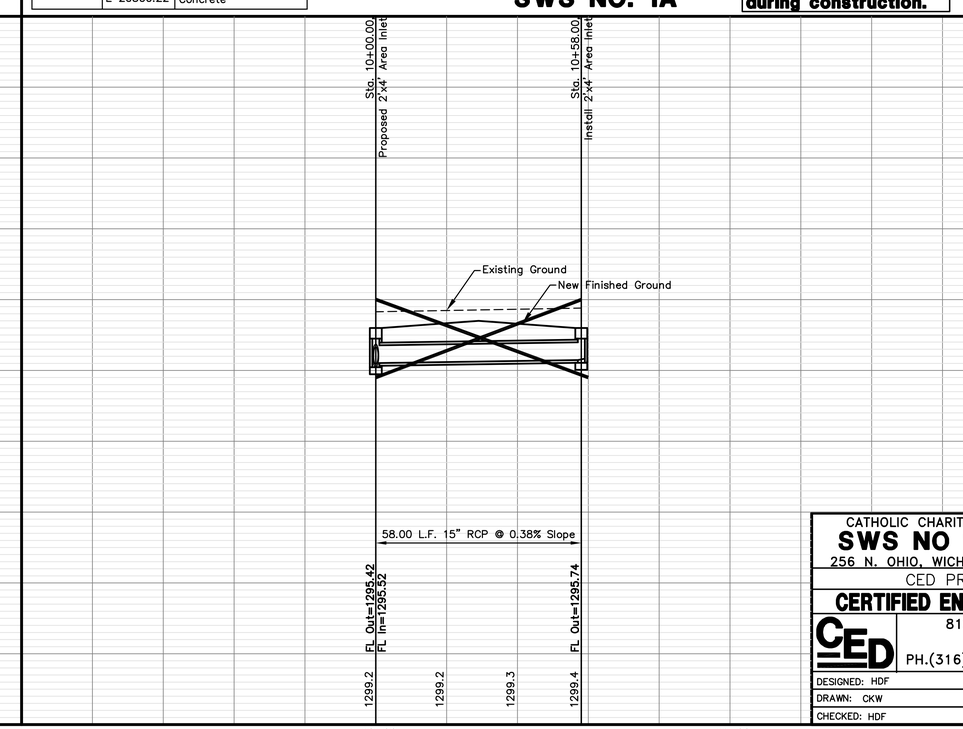

CATHOLIC CHARITIES–ANTHONY FAMILY SHELTER

SWS NO 1 & SWS NO. 1A

256 N. OHIO, WICHITA, SEDGWICK COUNTY, KANSAS

CED PROJ. NO.: 20061438

CERTIFIED ENGINEERING DESIGN, P.A.

810 WEST DOUGLAS, SUITE C
WICHITA, KANSAS 67203
PH.(316)262-8808 FAX.(316)262-1669

DESIGNED: HDF	SCALE: 1"=20'	SHEET 4
DRAWN: CKW	DATE: 7/06	
CHECKED: HDF	CED FILE:Catholic-SWS-Base	TOTAL 6