


PLAN	CHECKED	CHECKED
BY		
DATE		


PROFILE	CHECKED	CHECKED
BY		
DATE		

by AEE

Saved: 01-17-2008 2:47:28 PM by: AEE/CLM
 Plot Scale: 1"=20'
 01/17/2008 10:04:00 05028-004-CV2-3-SWSPP1

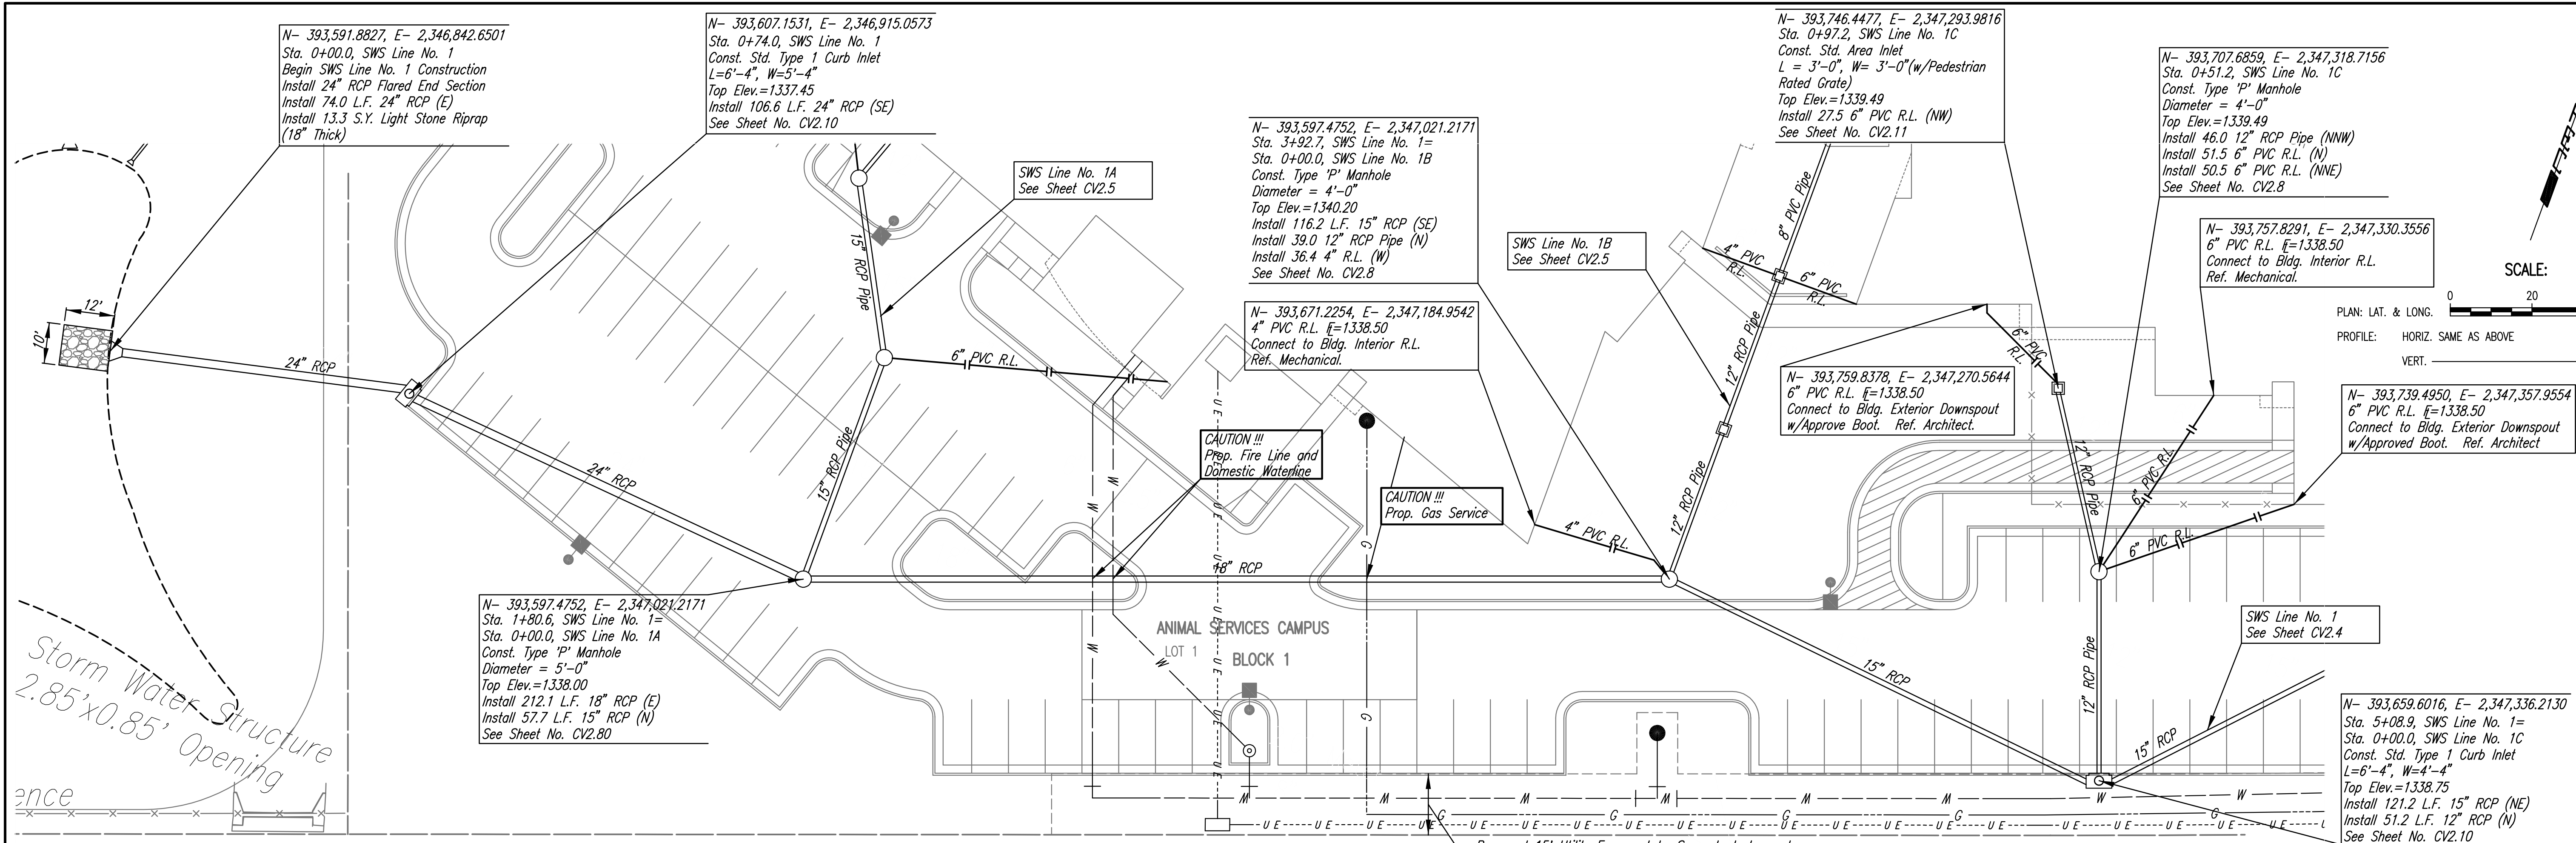

STORM WATER SEWER LINE NO. 1

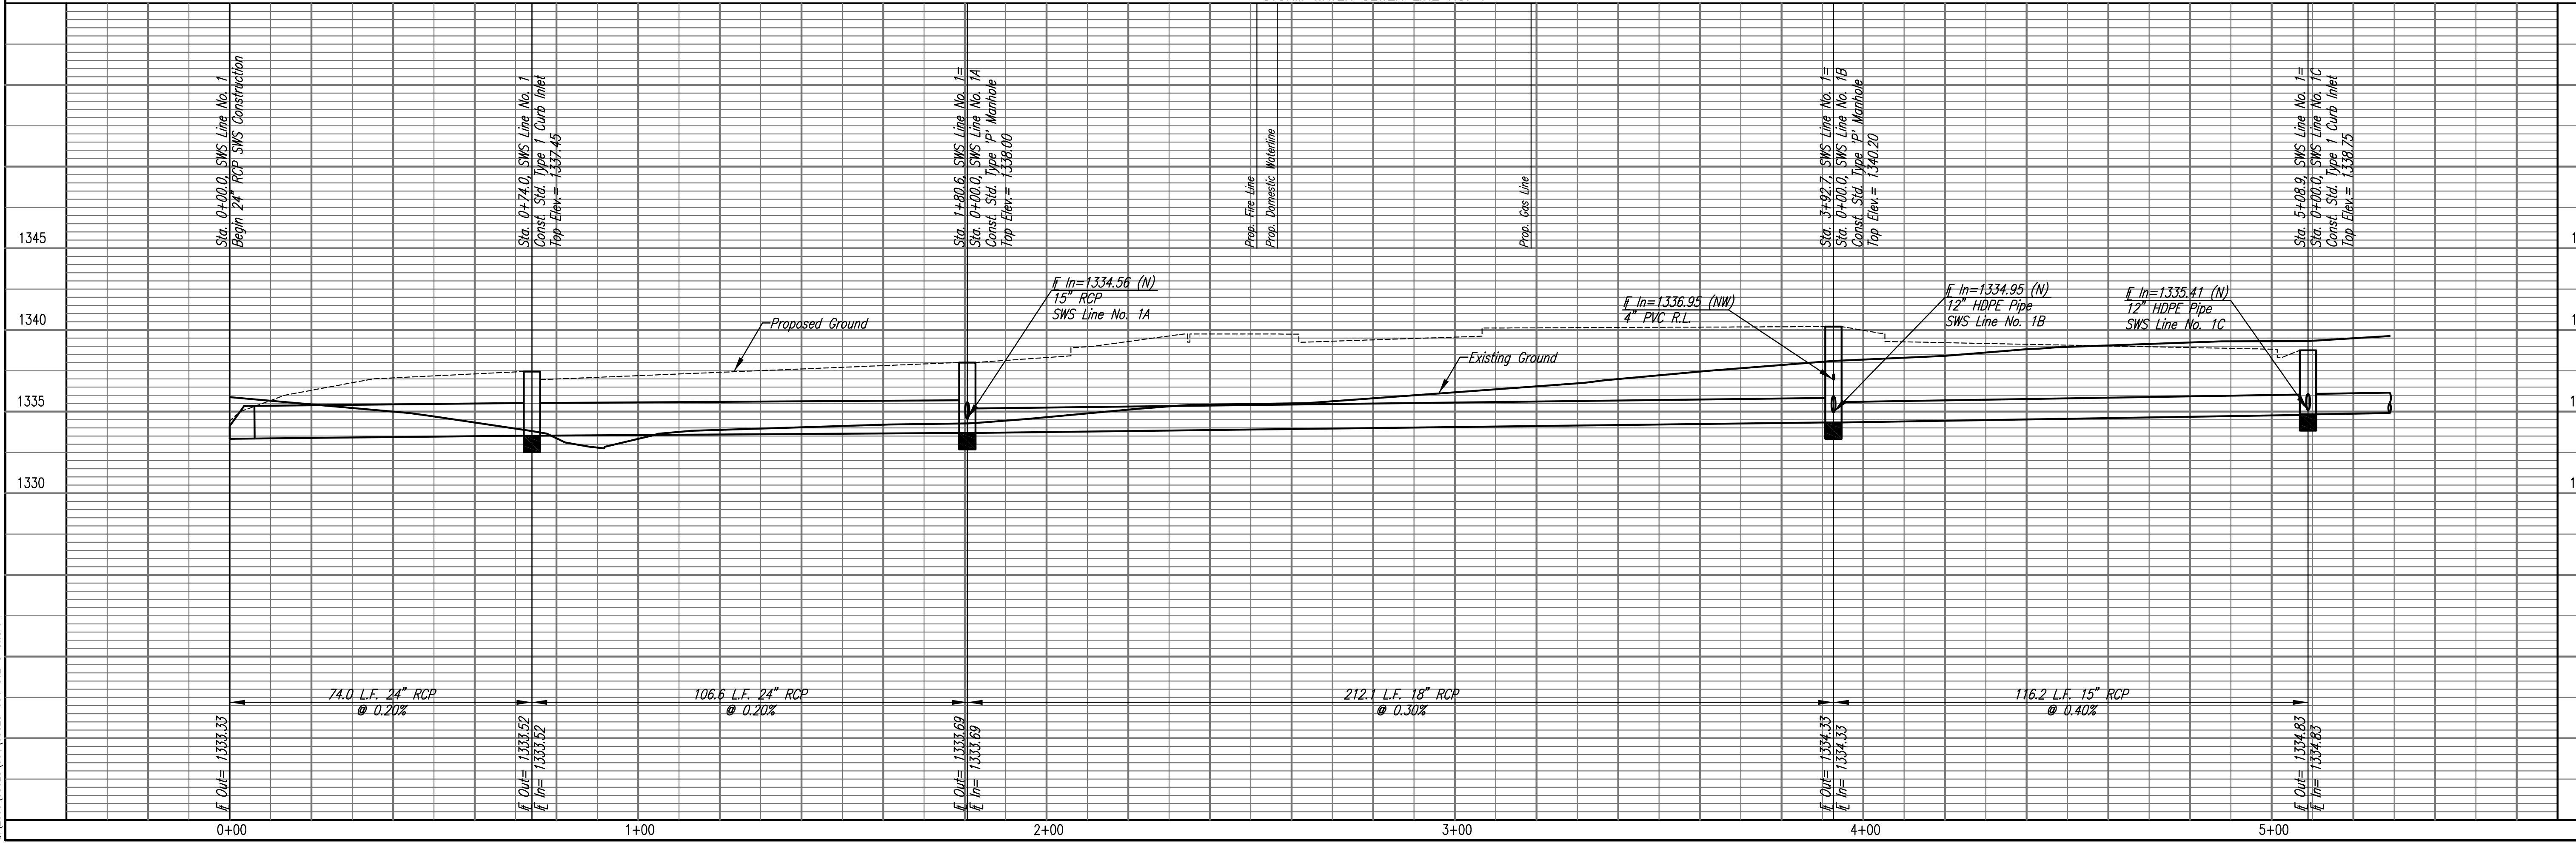

Built As Planned.
No Changes Made.

WICHITA ANIMAL CARE CAMPUS

SWS LINE NO. 1
 STA. 0+00.0 TO STA. 5+08.9

JAMES L. ARMOUR, P.E. - CITY ENGINEER
 CITY OF WICHITA, PRIVATE PROJECT NO. 1837 PPS (607861)

Professional Engineering Consultants, P.A.
 303 S. TORRENS, WICHITA, KANSAS 67202
 316-262-2291 • FAX 316-262-3003

Designed By: DWH
 Drawn By: SAW

Job No.: 35-05028-004
 Date: November 2007

Sheet CV2.3