
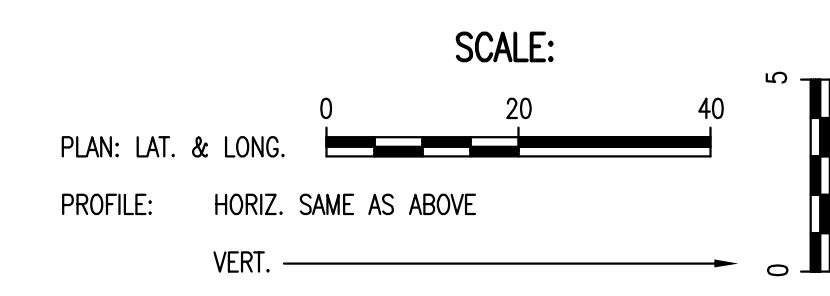


PLAN	CHECKED	CHECKED
BY	DATE	

PROFILE	CHECKED	CHECKED
BY	DATE	

by ABE

Saved: 01-17-2008 02:28:28 PM by GRET53 AM  
 Plot Scale  
 01/2005/05028/004/05028-004-CV2-4-SWSPPP2

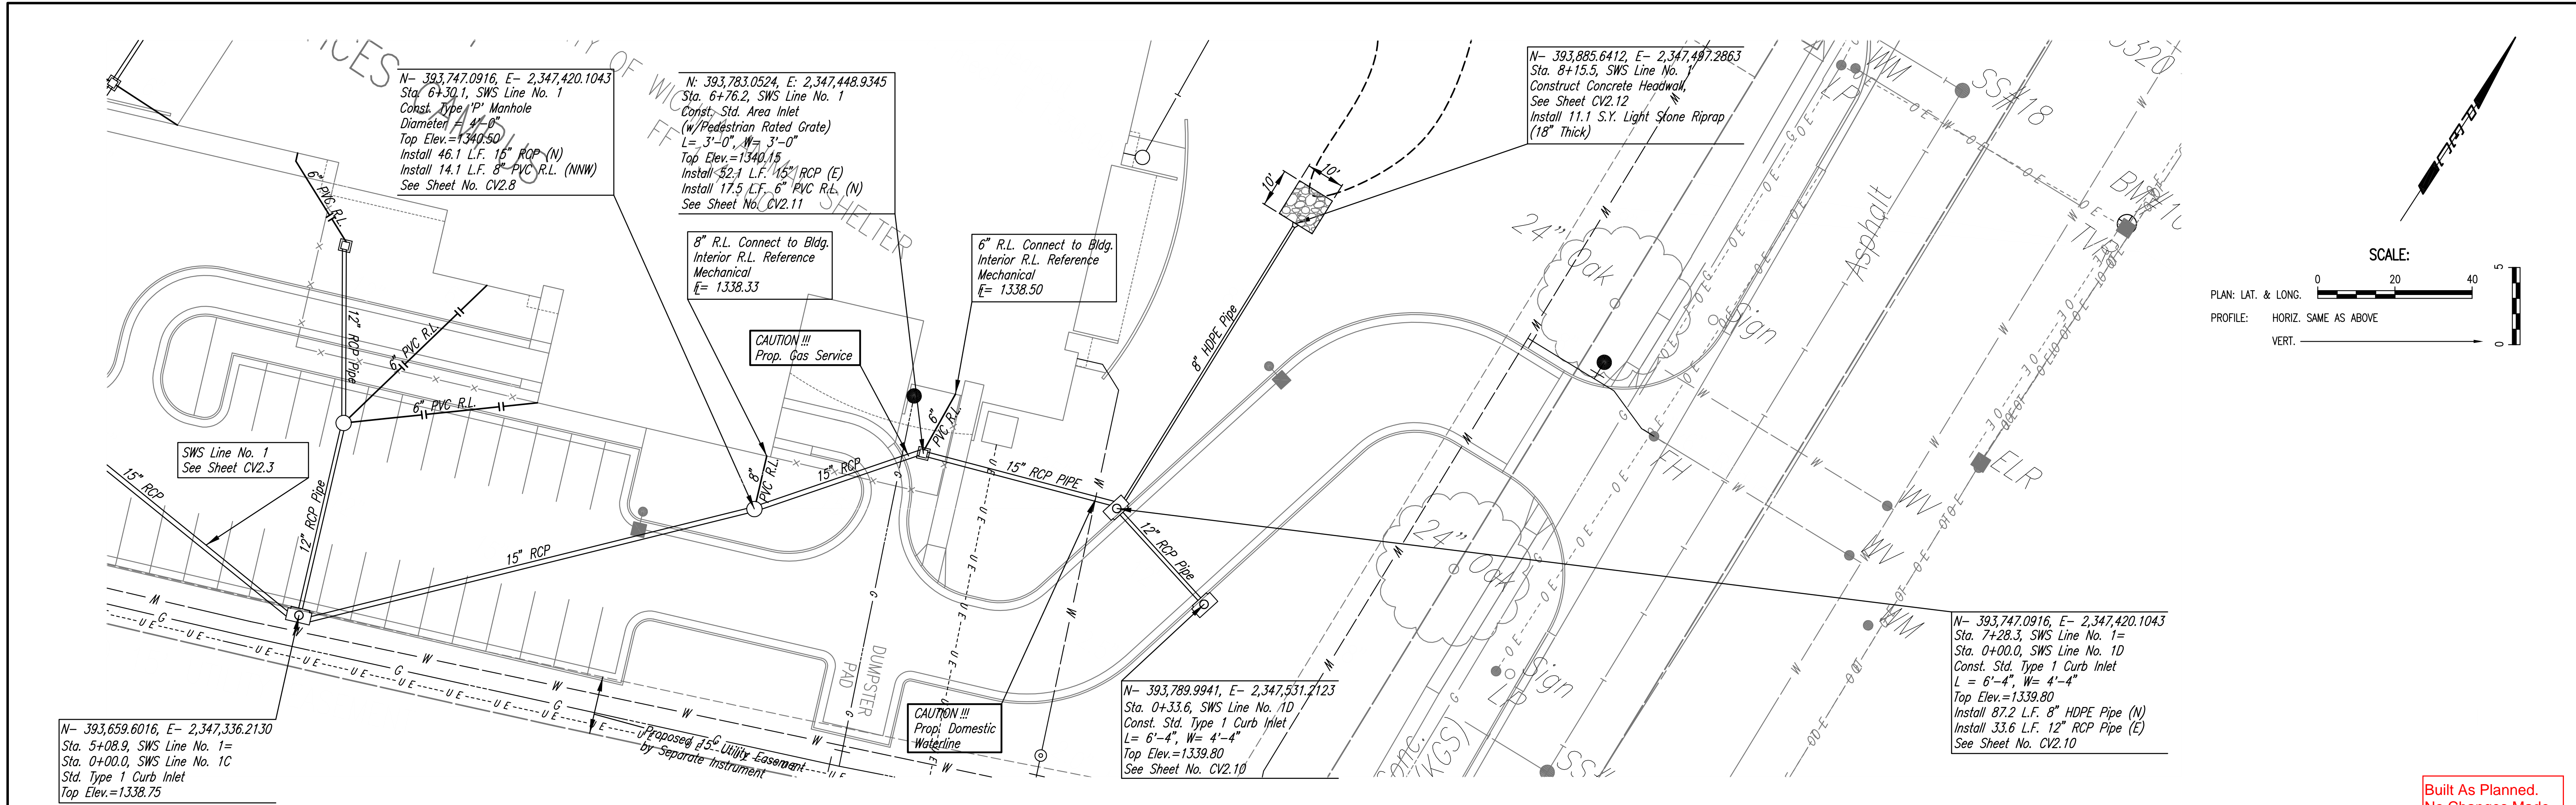


Built As Planned.  
No Changes Made.

STORM WATER SEWER LINE NO. 1

STORM WATER SEWER LINE NO. 1C

STORM WATER SEWER LINE NO. 1D

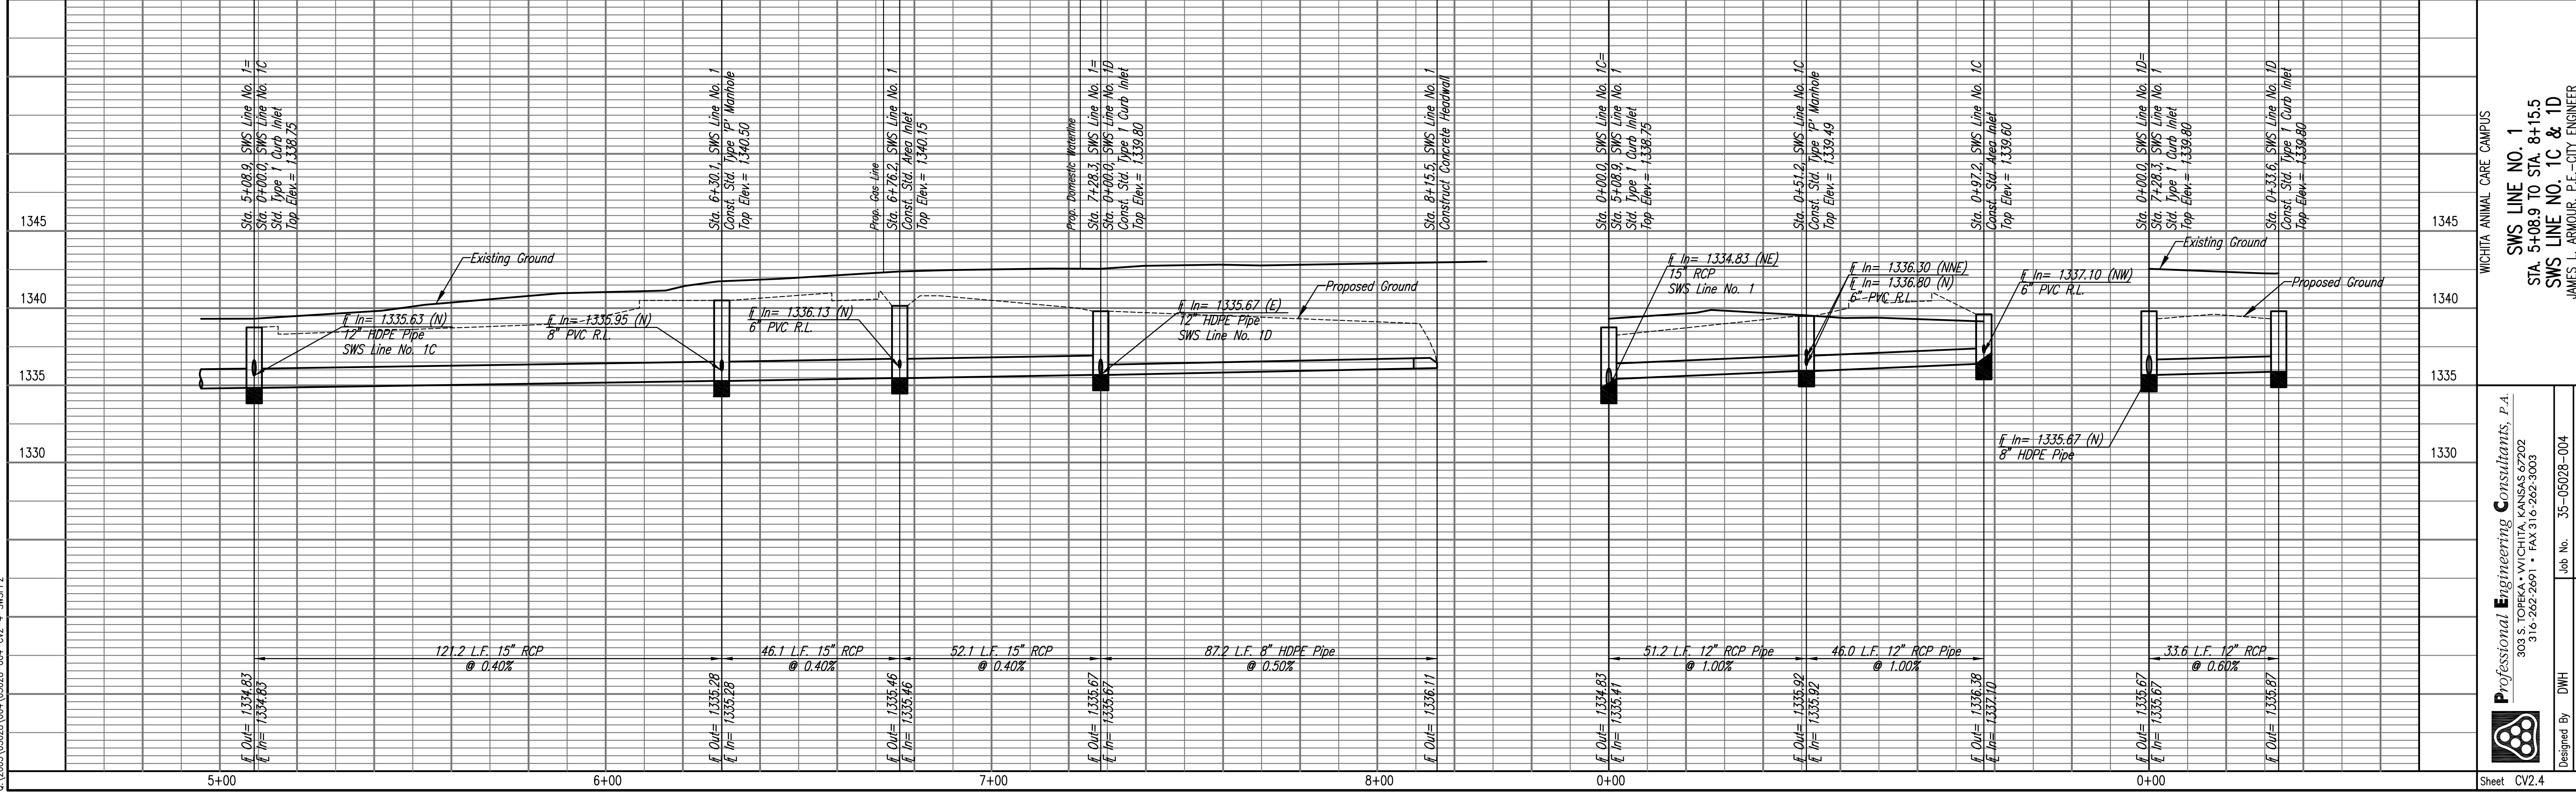

WICHITA ANIMAL CARE CAMPUS  
**SWS LINE NO. 1**  
 STA. 5+08.9 TO STA. 8+15.5  
**SWS LINE NO. 1C & 1D**  
 JAMES L. ARMOUR, P.E.-CITY ENGINEER  
 CITY OF WICHITA PRIVATE PROJECT NO. 1837 PPS (607861)  
 Professional Engineering Consultants, P.A.  
 303 S. TORRENS, WICHITA, KANSAS 67202  
 316-262-2091 • FAX 316-262-3003  
 Job No. 35-05028-004  
 Date November 2007  
 Designed by DWH  
 Drawn by SAW  
 Sheet CV2.4