
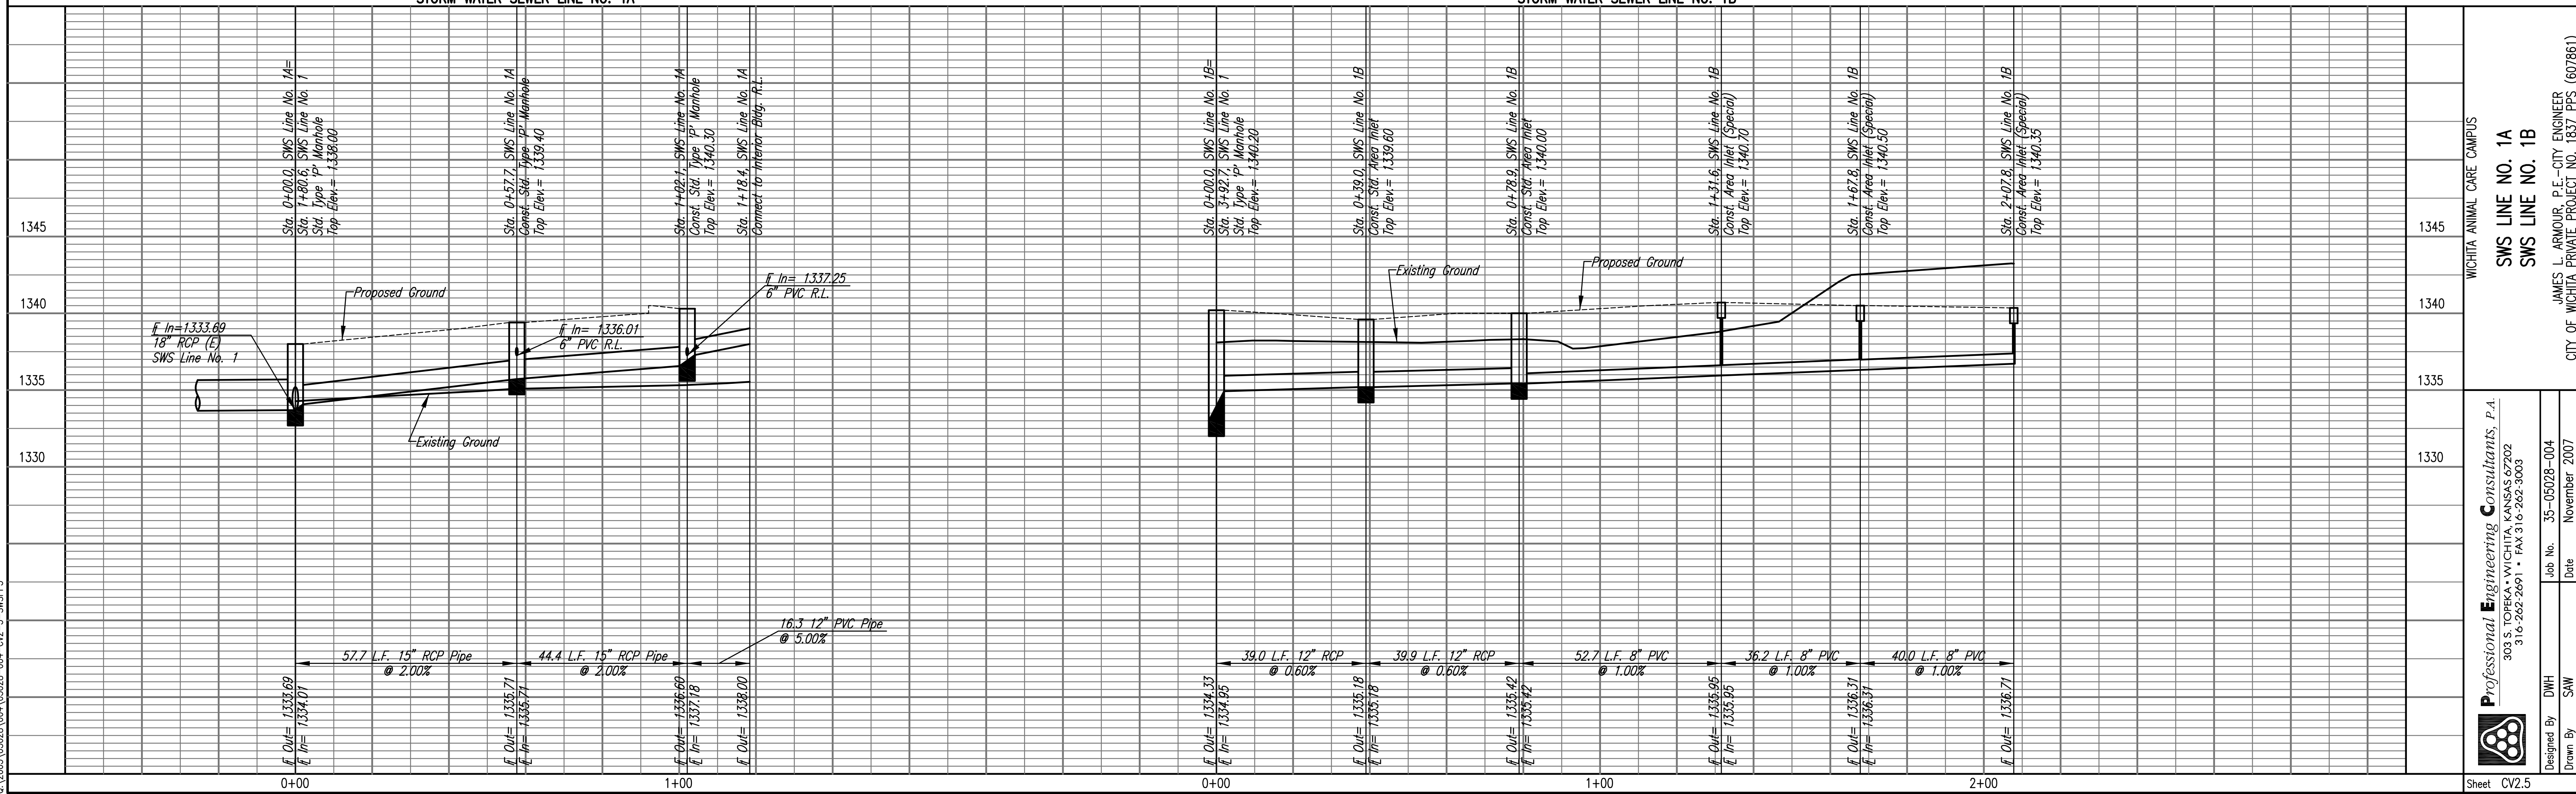


PLAN	CHECKED	CHECKED
BY		
DATE		

PROFILE	CHECKED	CHECKED
BY		
DATE		

by AEE

Saved: 01-17-2008 2:47:42 PM by: AEE/28 AM  
 Plot Scale: 1"=20'  
 0: 2005/09/08 10:41:05 05028-004-CV2-5-SWSPPS

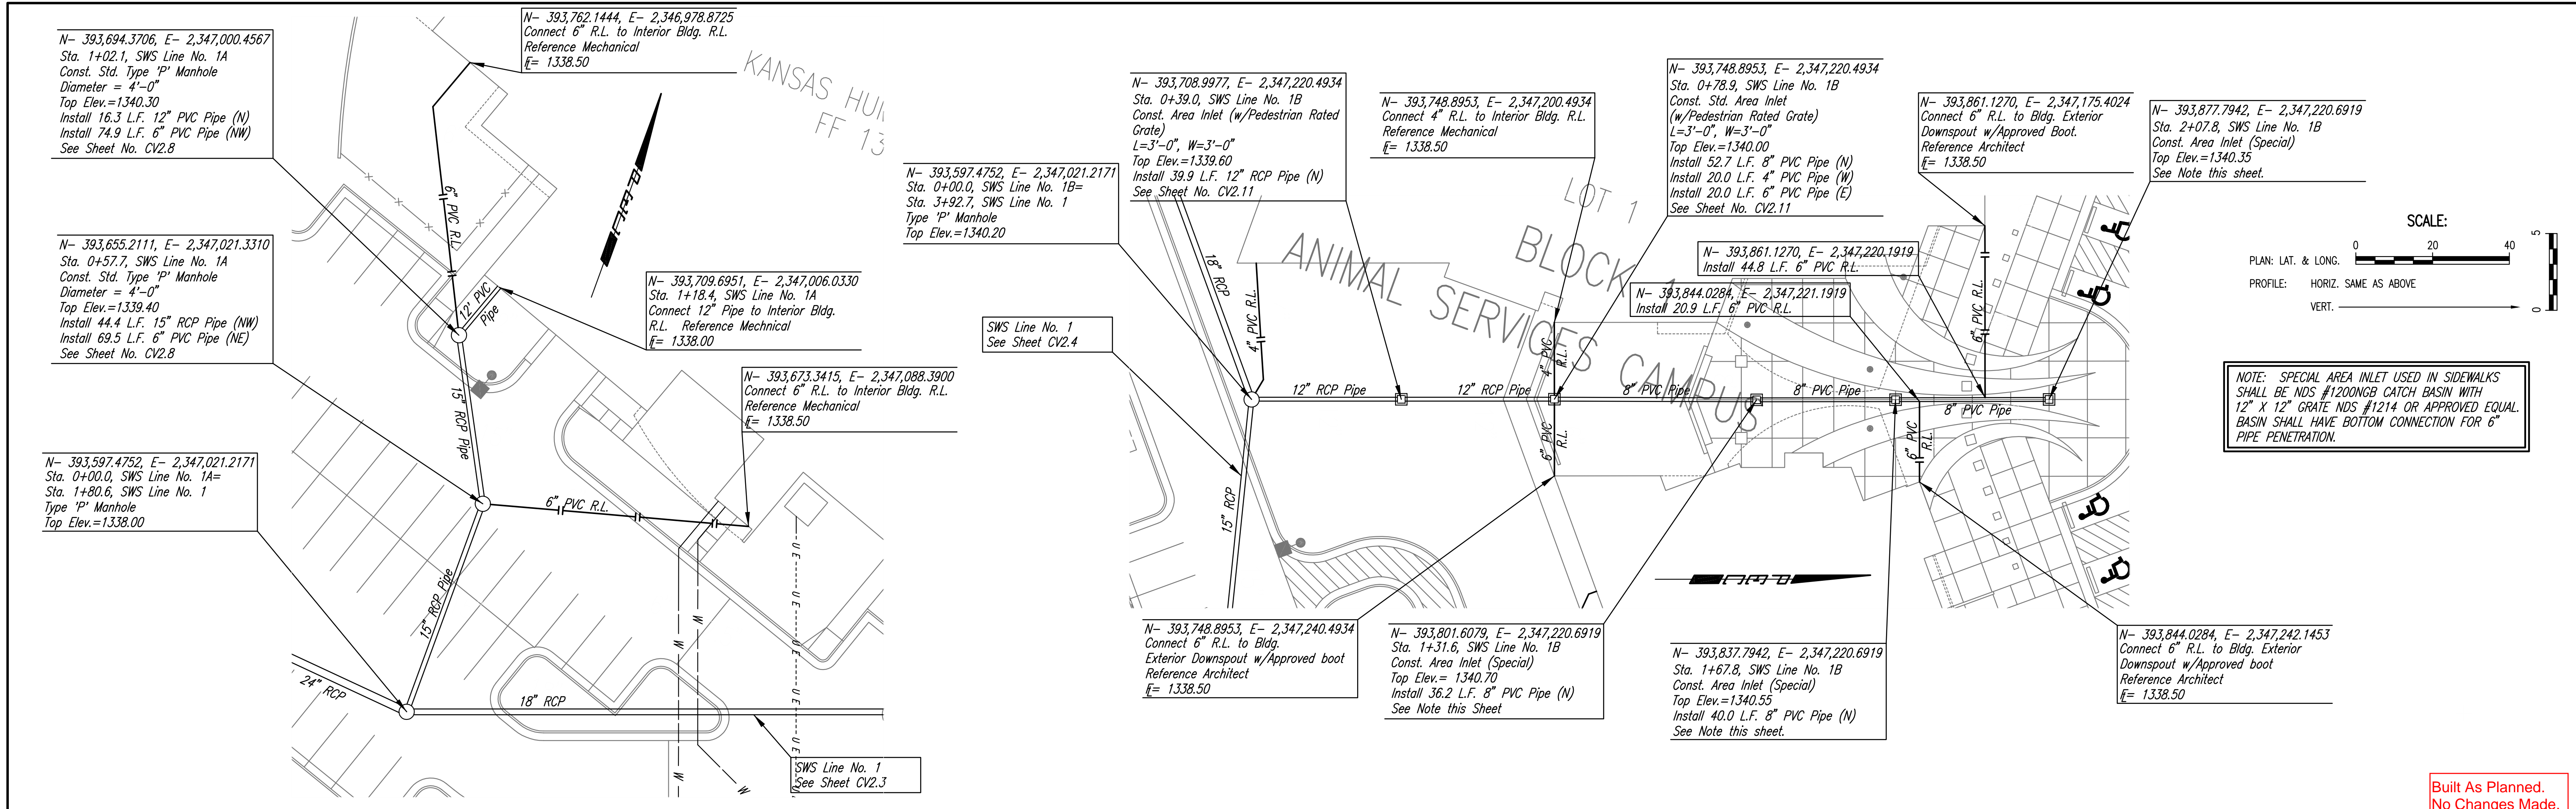

Professional Engineering Consultants, P.A.  
 316-262-2091 • FAX 316-262-3003

Job No. 35-05028-004  
 Date November 2007

Designed By DWH  
 Drawn By SAW

WICHITA ANIMAL CARE CAMPUS  
**SWS LINE NO. 1A**  
**SWS LINE NO. 1B**

JAMES L. ARMOUR, P.E.-CITY ENGINEER  
 CITY OF WICHITA, PRIVATE PROJECT NO. 1837 PPS (607861)

Sheet CV2.5