


DATE	
BY	
CHECKED	CHECKED
PLAN	

DATE	
BY	
CHECKED	CHECKED
PROFILE	


Served 01-17-2008 2:27:34 PM by AEE
 Plot Scale 1:20' 0" = 1" 0" 0" 0" AM by AEE
 01/20/08 10:04:04 05028-004-CV2-6-SWSPPP3

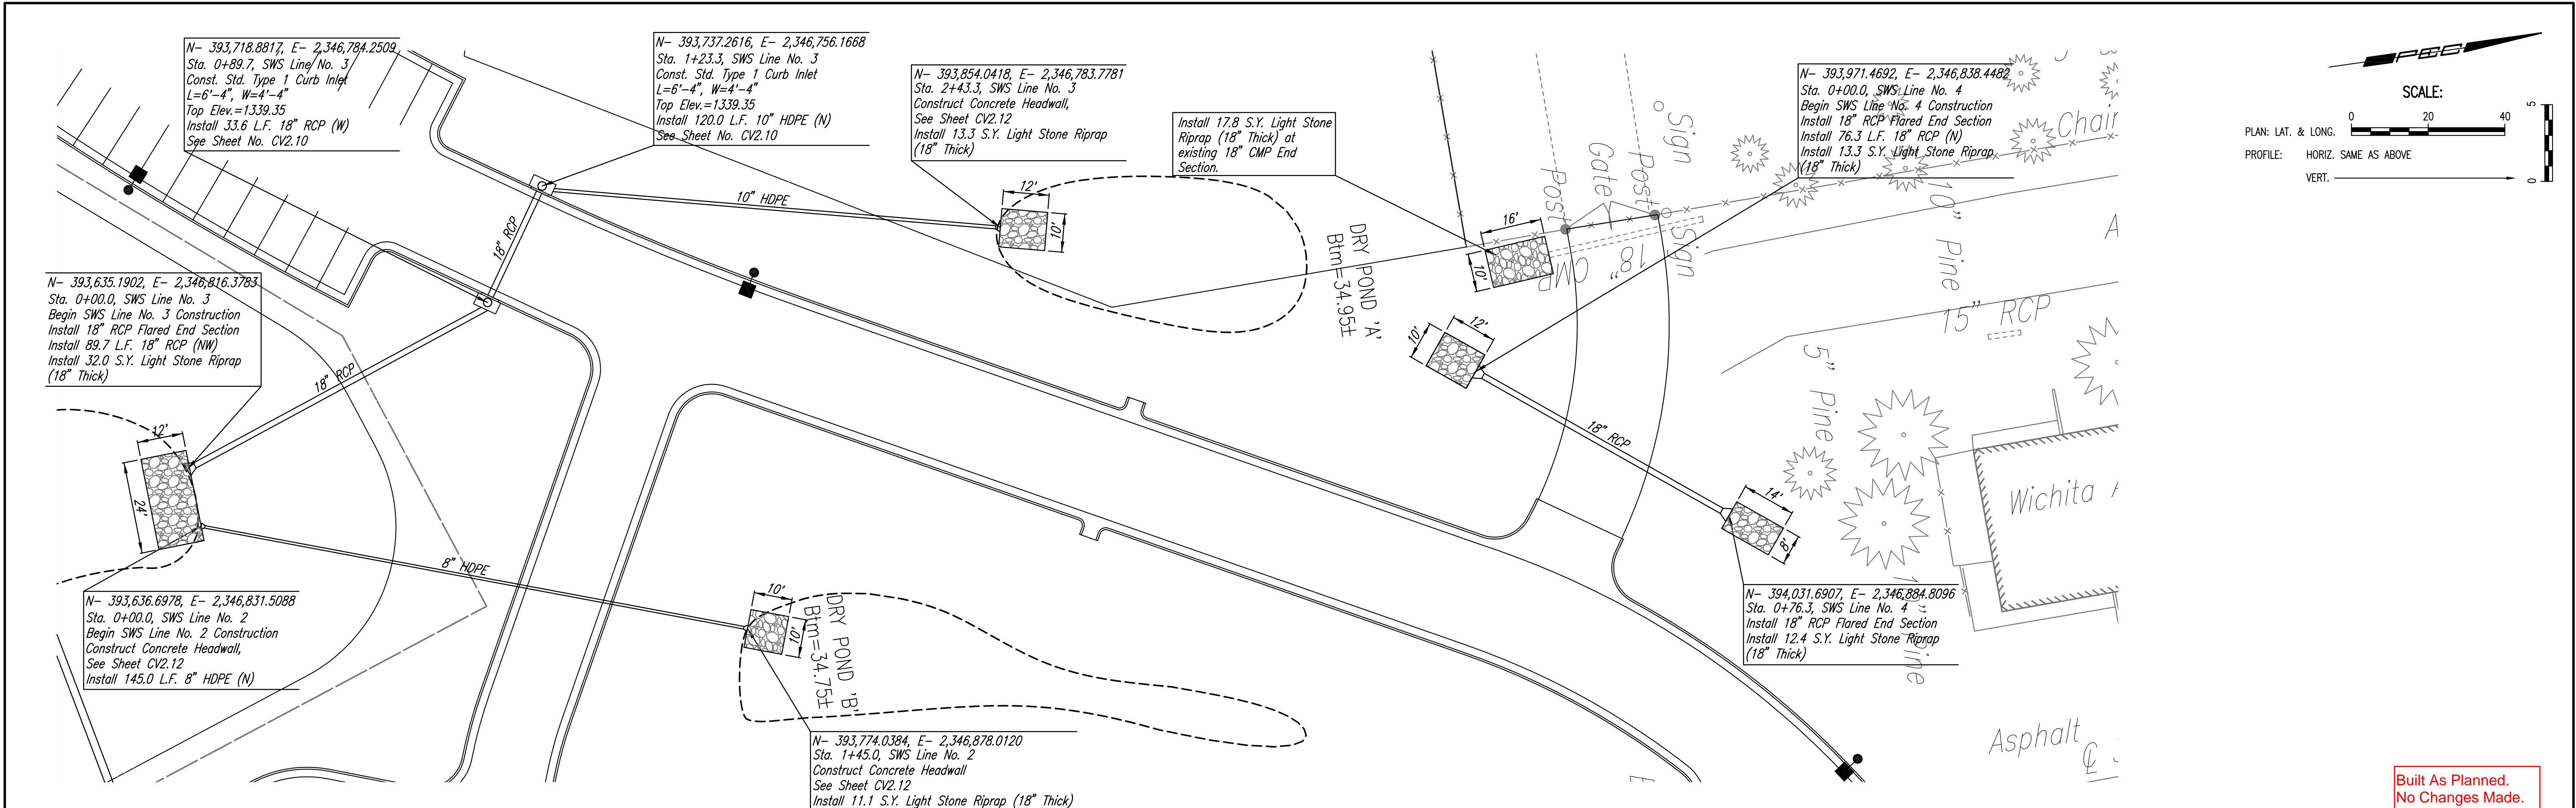

STORM WATER SEWER LINE NO. 2

STORM WATER SEWER LINE NO. 3

STORM WATER SEWER LINE NO. 4

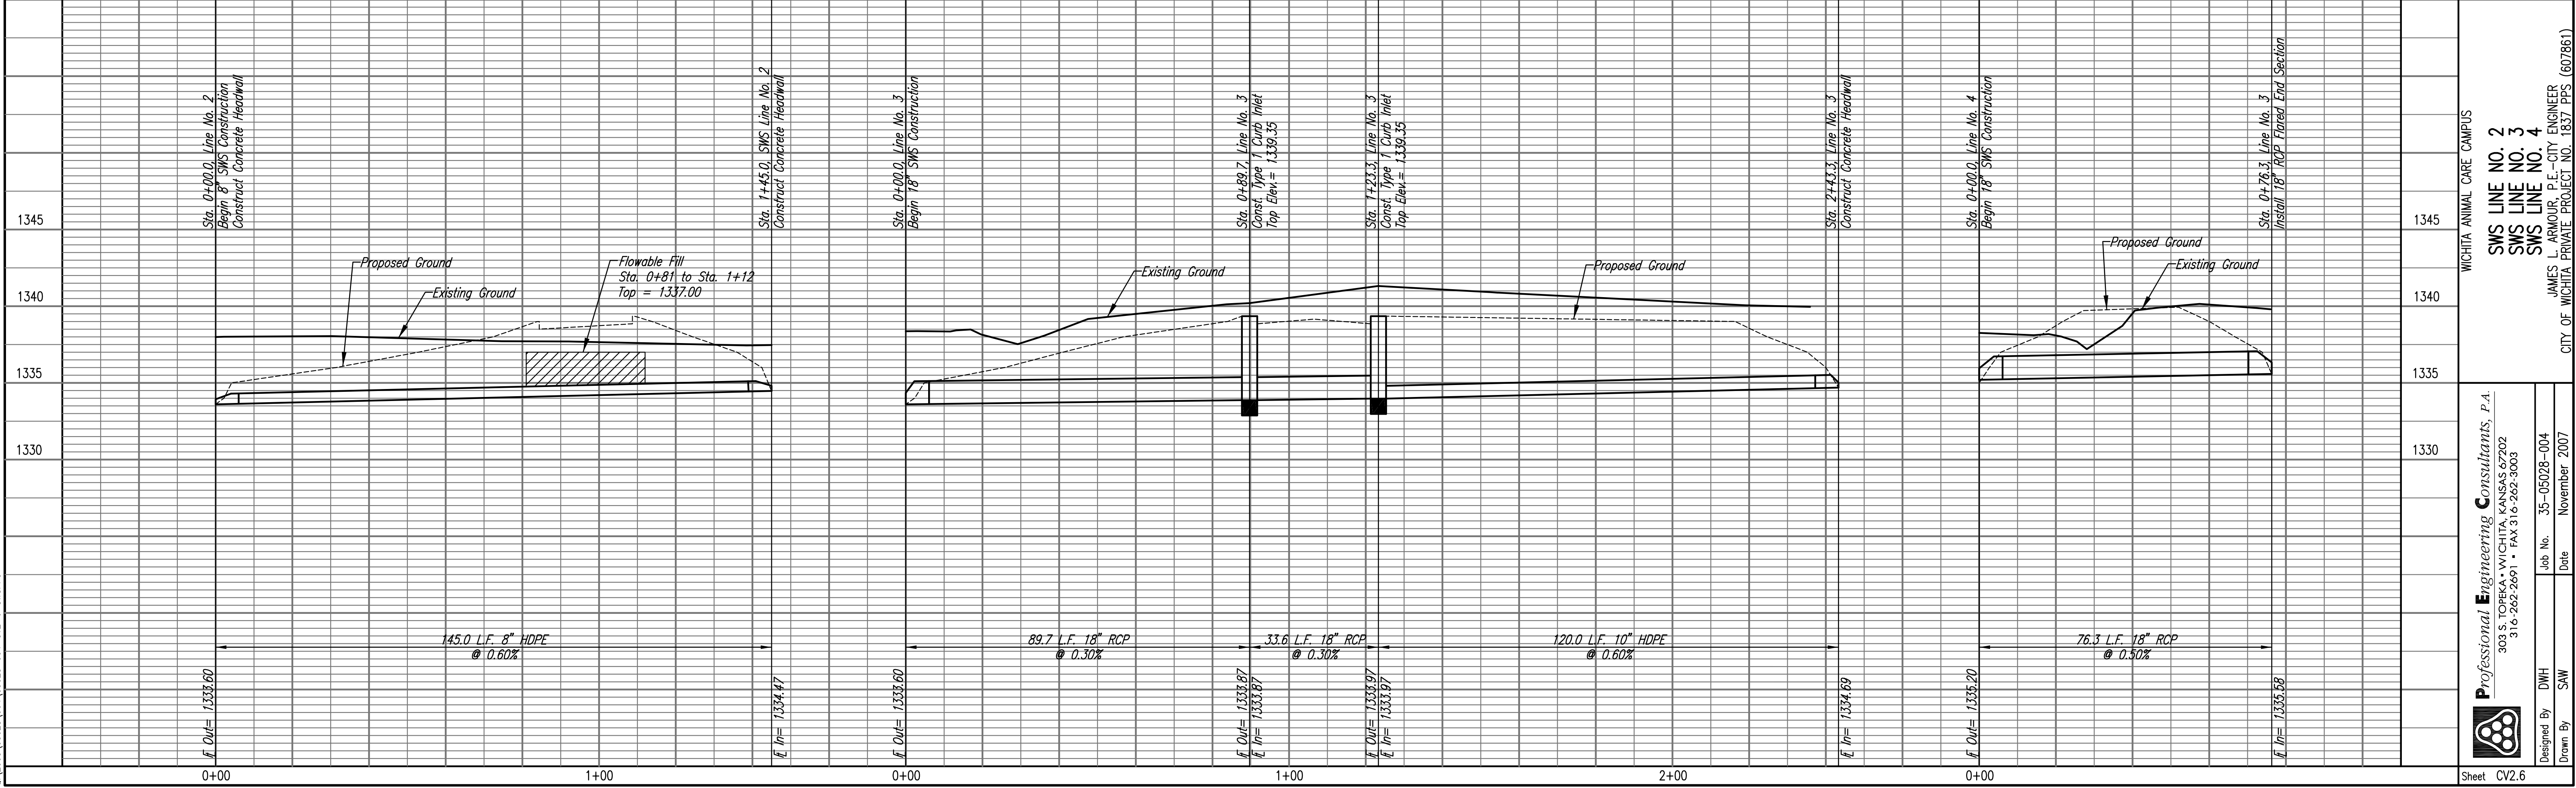

WICHITA ANIMAL CARE CAMPUS
SWS LINE NO. 2
SWS LINE NO. 3
SWS LINE NO. 4
 JAMES L. ARMOUR, P.E.-CITY ENGINEER
 CITY OF WICHITA PRIVATE PROJECT NO. 1837 PPS (607861)

Professional Engineering Consultants, P.A.
 303 S. TORRENS, WICHITA, KANSAS 67202
 316-262-2091 • FAX 316-262-3003

Job No. 35-05028-004
 Date November 2007
 Designed By DWH
 Drawn By SAW

Sheet CV2.6