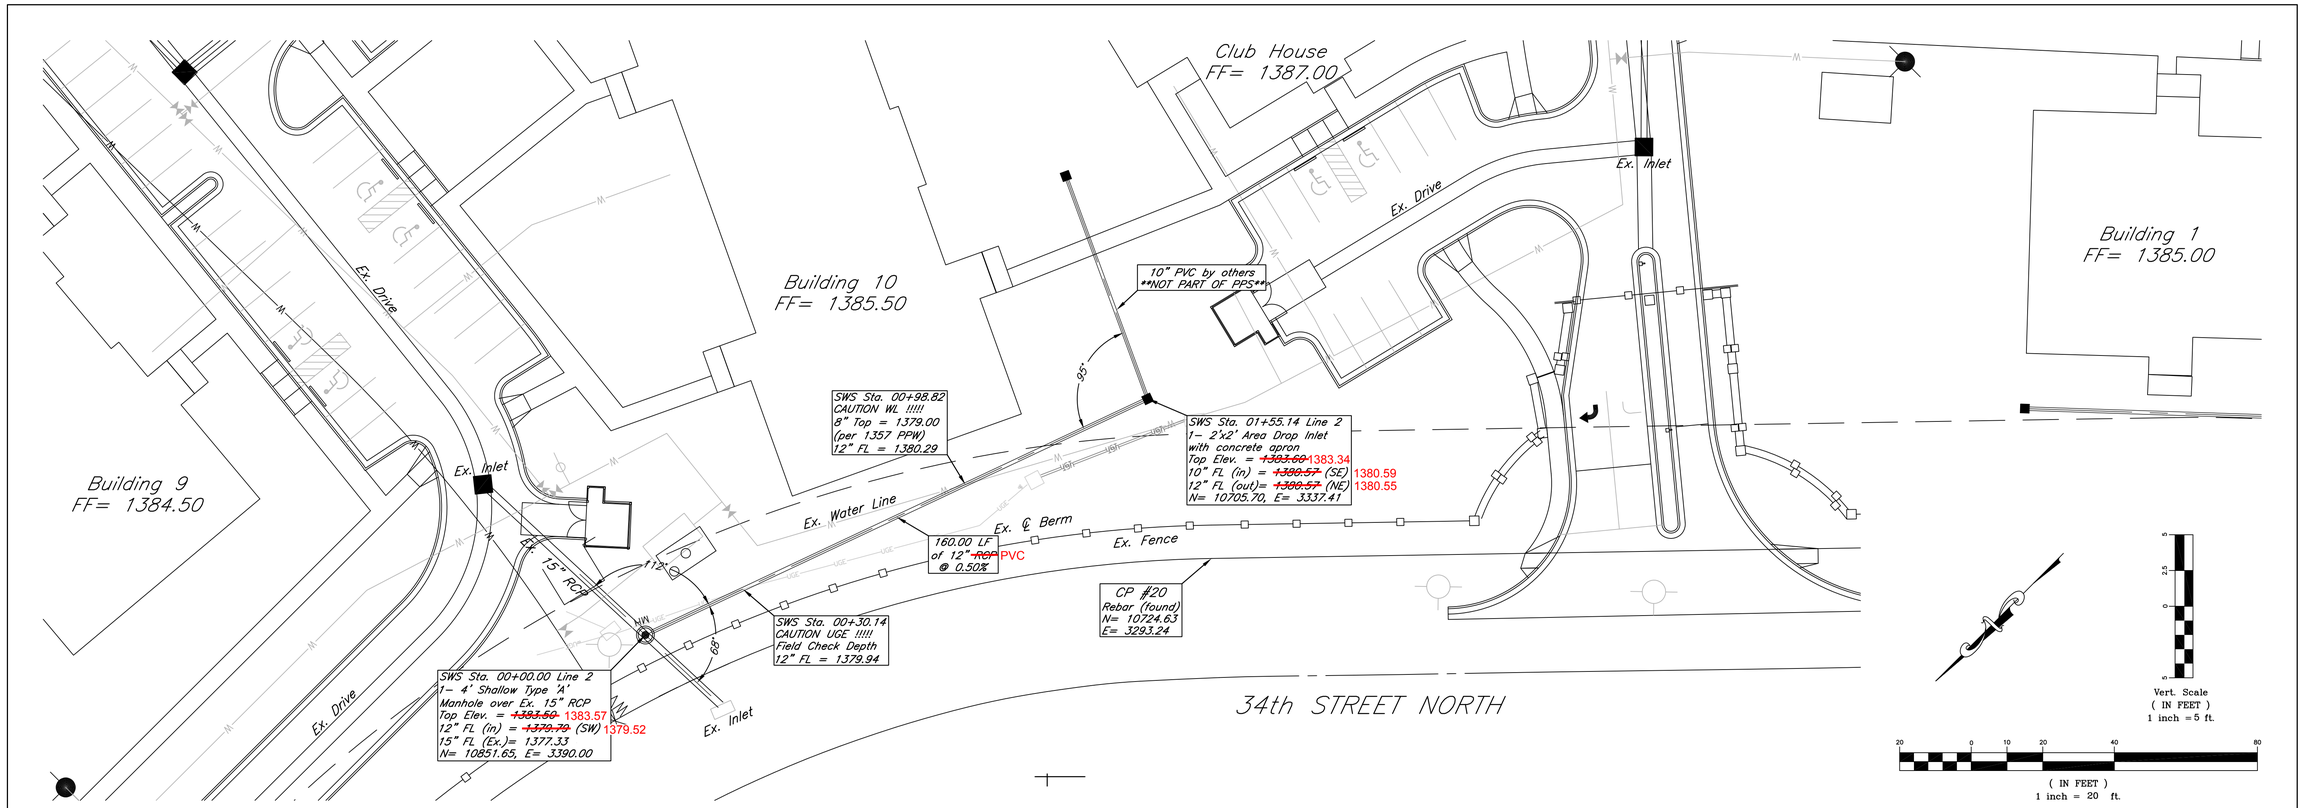

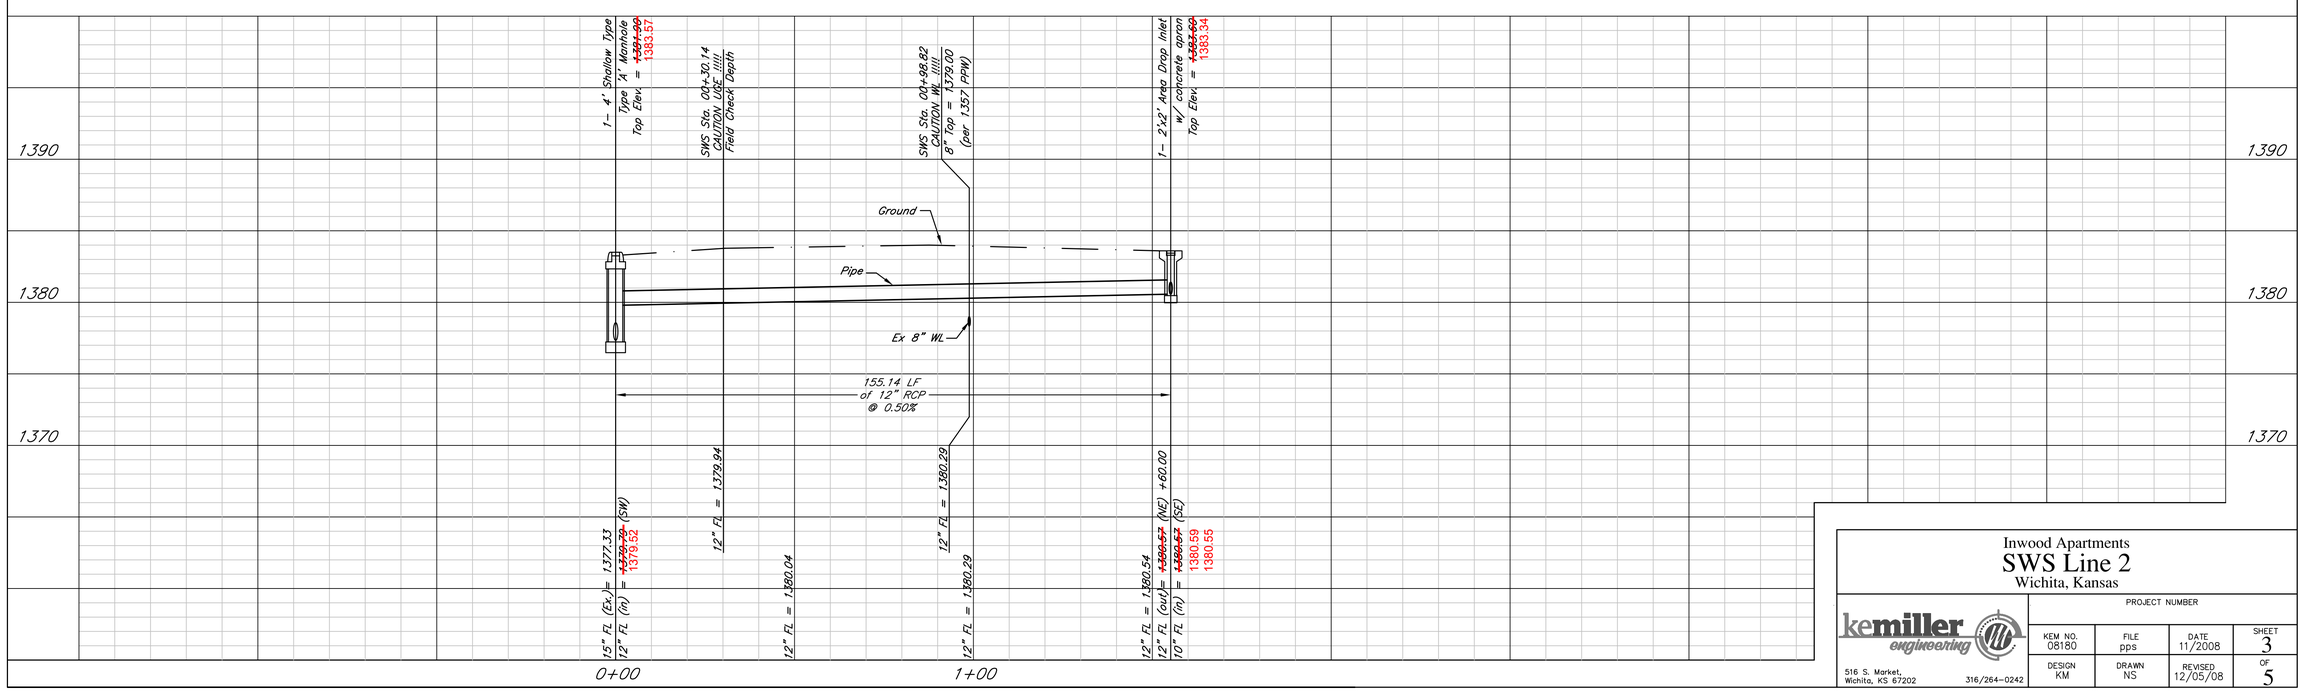

Inwood Apartments

SWS Line 2

Wichita, Kansas

kemiller engineering
516 S. Market,
Wichita, KS 67202
316/264-0242

PROJECT NUMBER			
KEM NO. 08180	FILE pps	DATE 11/2008	SHEET 3
DESIGN KM	DRAWN NS	REVISED 12/05/08	OF 5