

BENCHMARKS:



BM #1: "C" Cut on Top of Curb at West Line of Lot 7, Block A, Auburn Hills 5th Addition. Elev. = 207.73 (City Datum)

BM #2: Disc in Back of Curb, North of Front Corner Common to Lots 23 and 24, Block D, Auburn Hills 12th Addition. Elev. = 191.84 (City Datum)


BM #3: "C" Cut in Middle of Curb Inlet Top Adjacent to the South Corner of Lot 15, Block B. Elev. = 193.65 (City Datum)

AUBURN HILLS
14TH ADDITION

AUBURN HILLS
16TH ADDITION

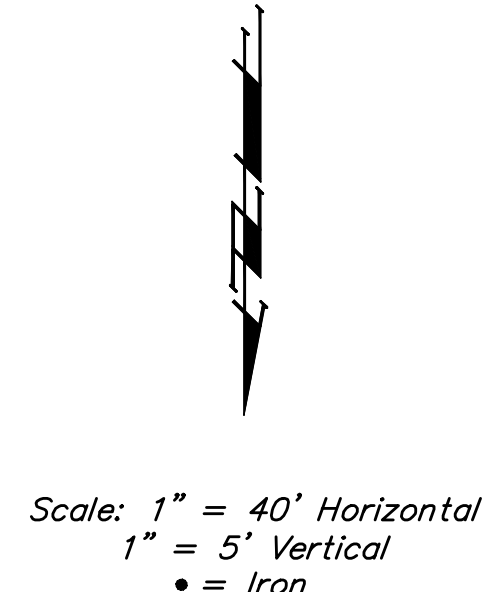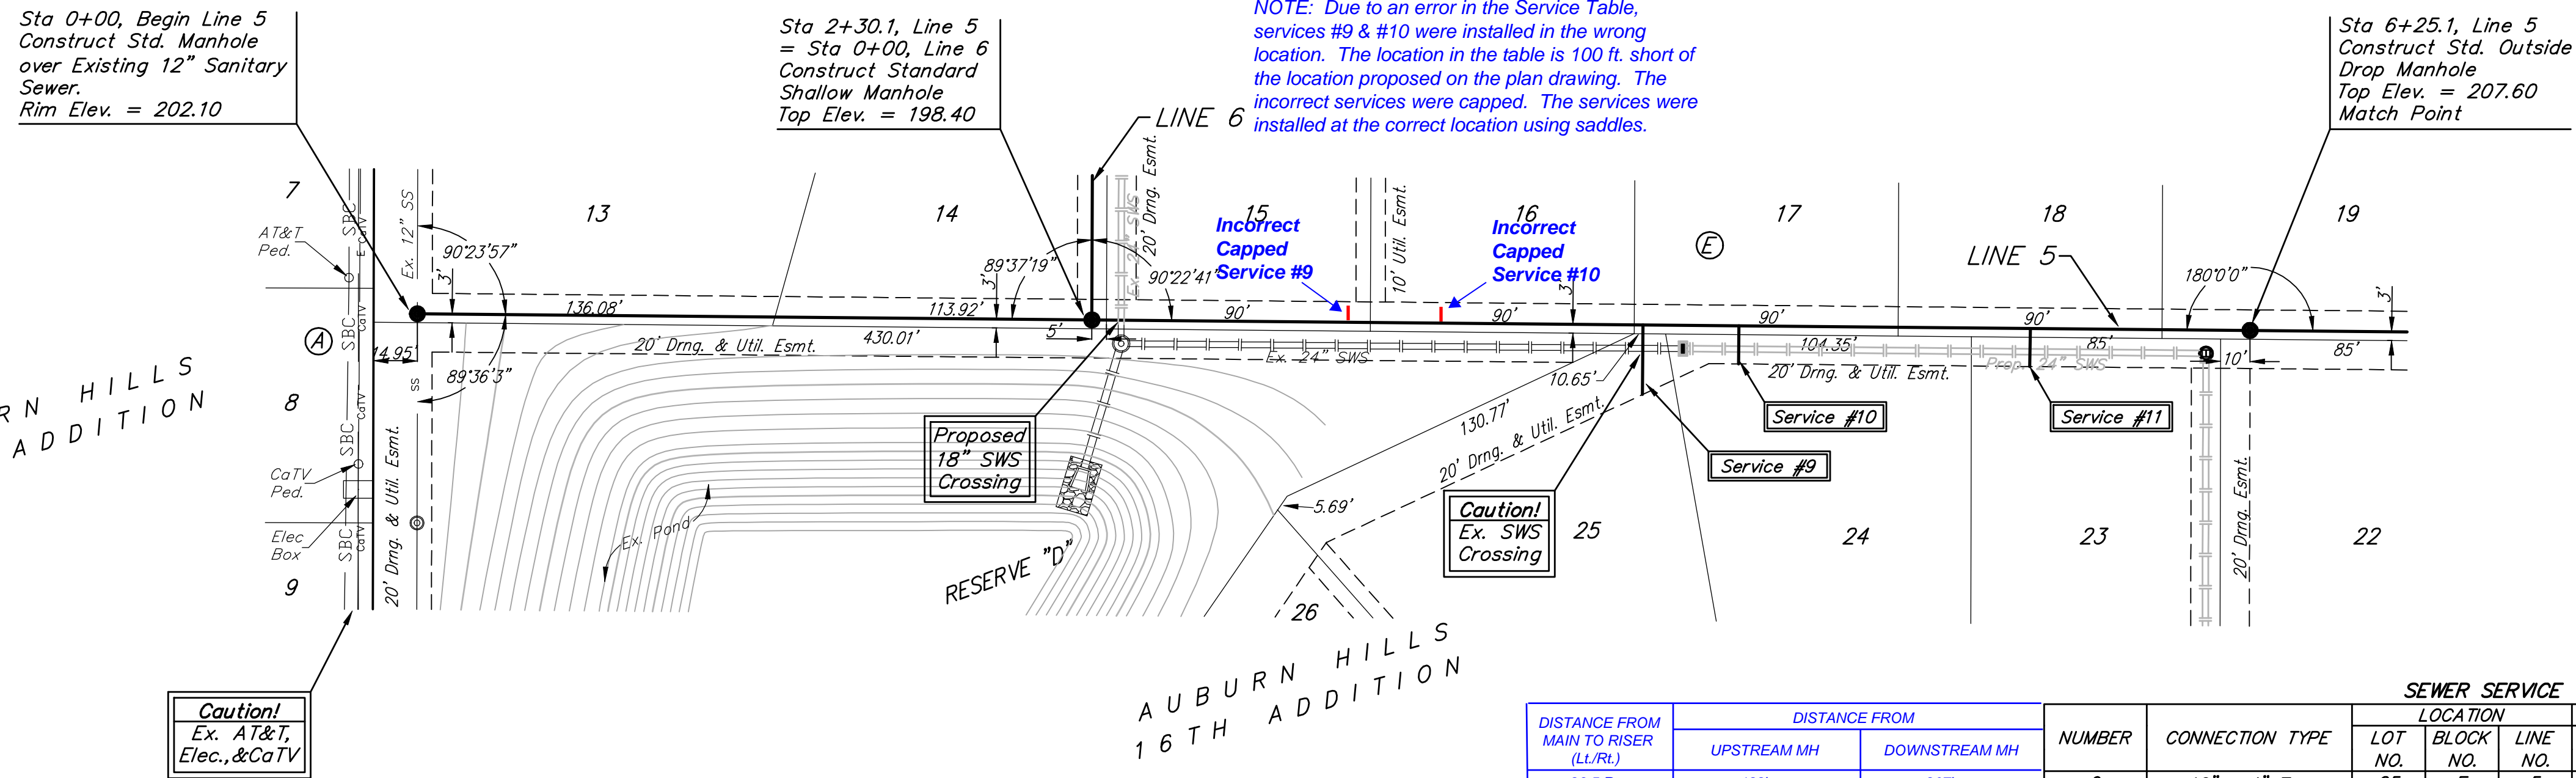

DISTANCE FROM MAIN TO RISER (L/R)	DISTANCE FROM		NUMBER	CONNECTION TYPE	LOCATION			FOR INFORMATION ONLY		
	UPSTREAM MH	DOWNSTREAM MH			LOT NO.	BLOCK NO.	LINE NO.	STATION/DIRECTION	APPROXIMATE LENGTH 4" PIPE	
23.5 Rt.	188'	207'	9	10" x 4" Tee	25	E	5	4+18.1/Rt.	5	-24-
12.2 Rt.	220.7'	174.3'	10	10" x 4" Tee	24	E	5	4+50.8/Rt.	6	-13-
128 Rt.	320.13'	75.2'	11	10" x 4" Tee	23	E	5	5+50.1/Rt.	8	-13-

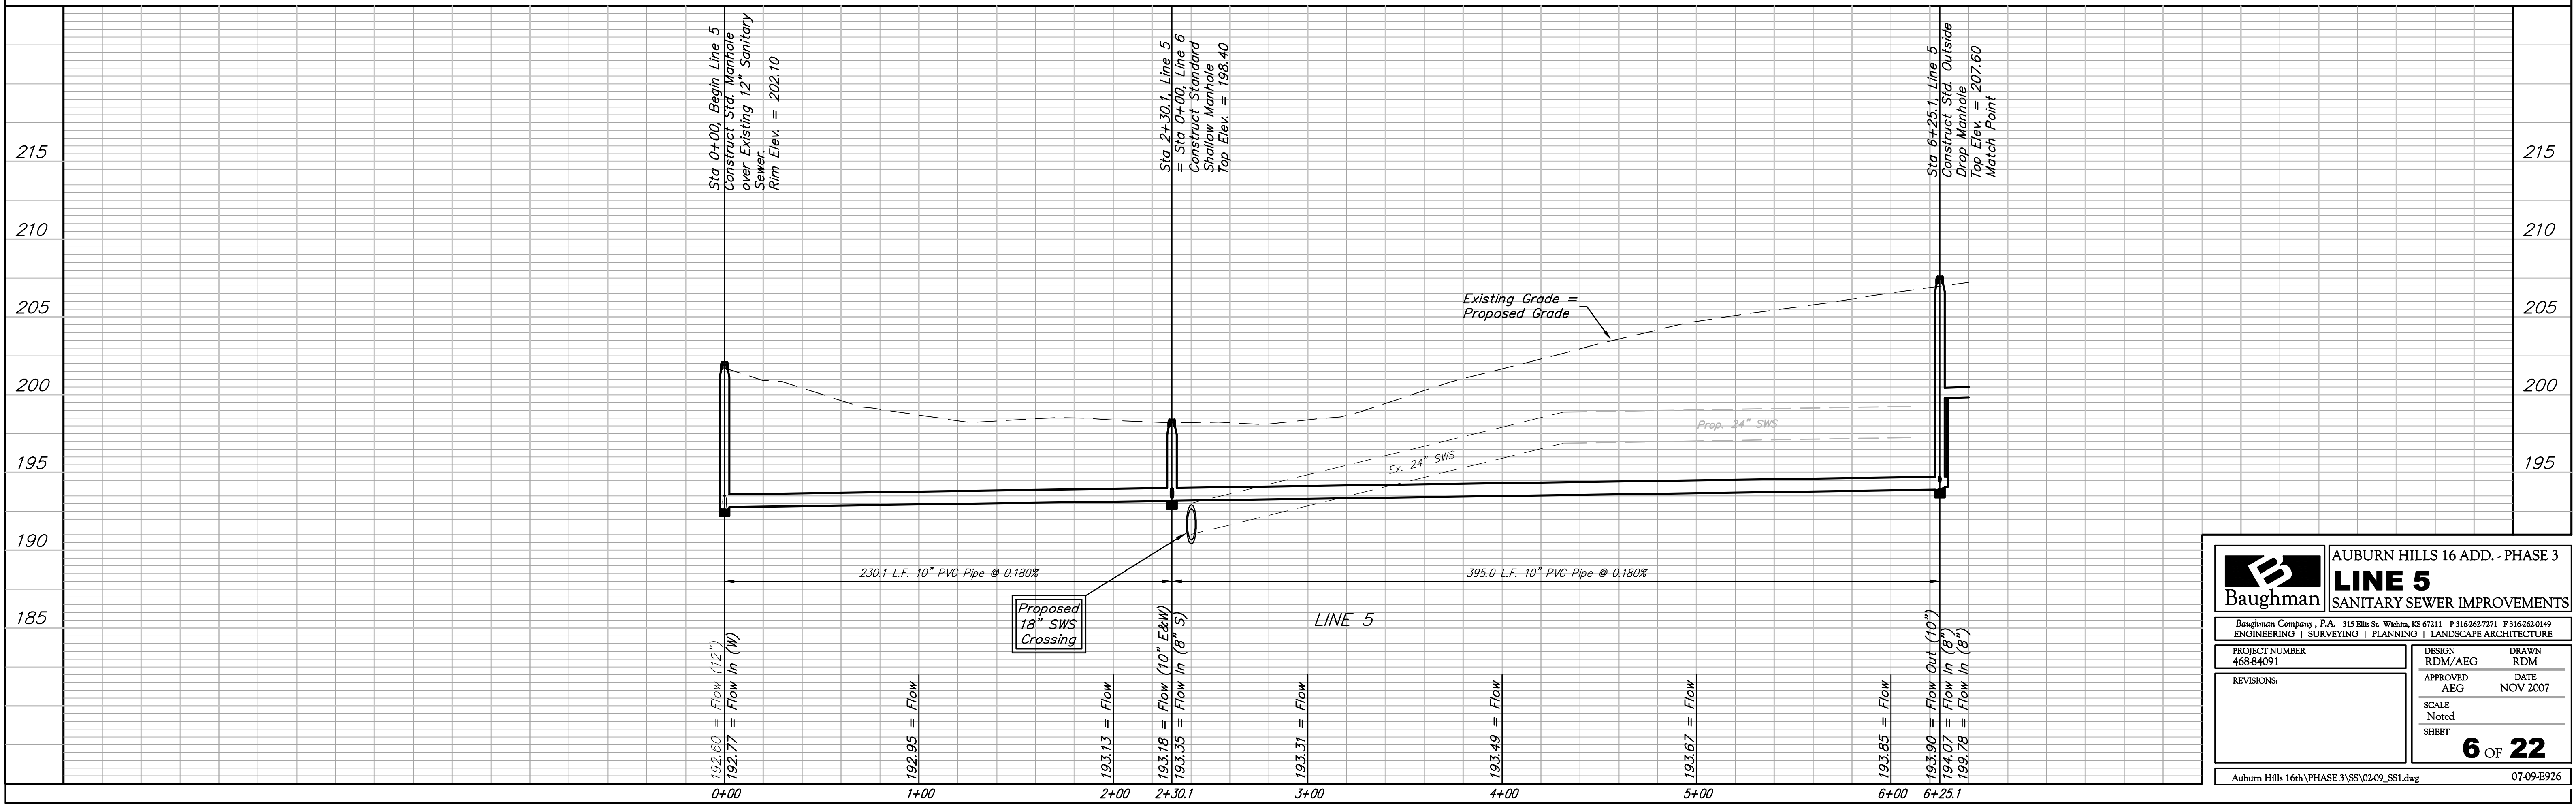

B Baughman

AUBURN HILLS 16 ADD. - PHASE 3
LINE 5
SANITARY SEWER IMPROVEMENTS

Baughman Company, P.A. 315 Ellis St. Wichita, KS 67211 P 316-262-7271 F 316-262-0149
ENGINEERING | SURVEYING | PLANNING | LANDSCAPE ARCHITECTURE

PROJECT NUMBER: 468-84091
DESIGN: RDM/AEG
DRAWN: RDM
APPROVED: AEG
DATE: NOV 2007

REVISIONS:

SCALE: Noted
SHEET: 6 OF 22

Auburn Hills 16th\PHASE 3\SS\0209_SSI.dwg 07-09-E926