



TRENCHES TO BE BACKFILLED WITH SAND AND FLUSHED WHEN SEWER LINE RUNS ALONG FRONT OF LOTS. (LINE 1, STA. 10+00.00 TO STA. 14+94.4)

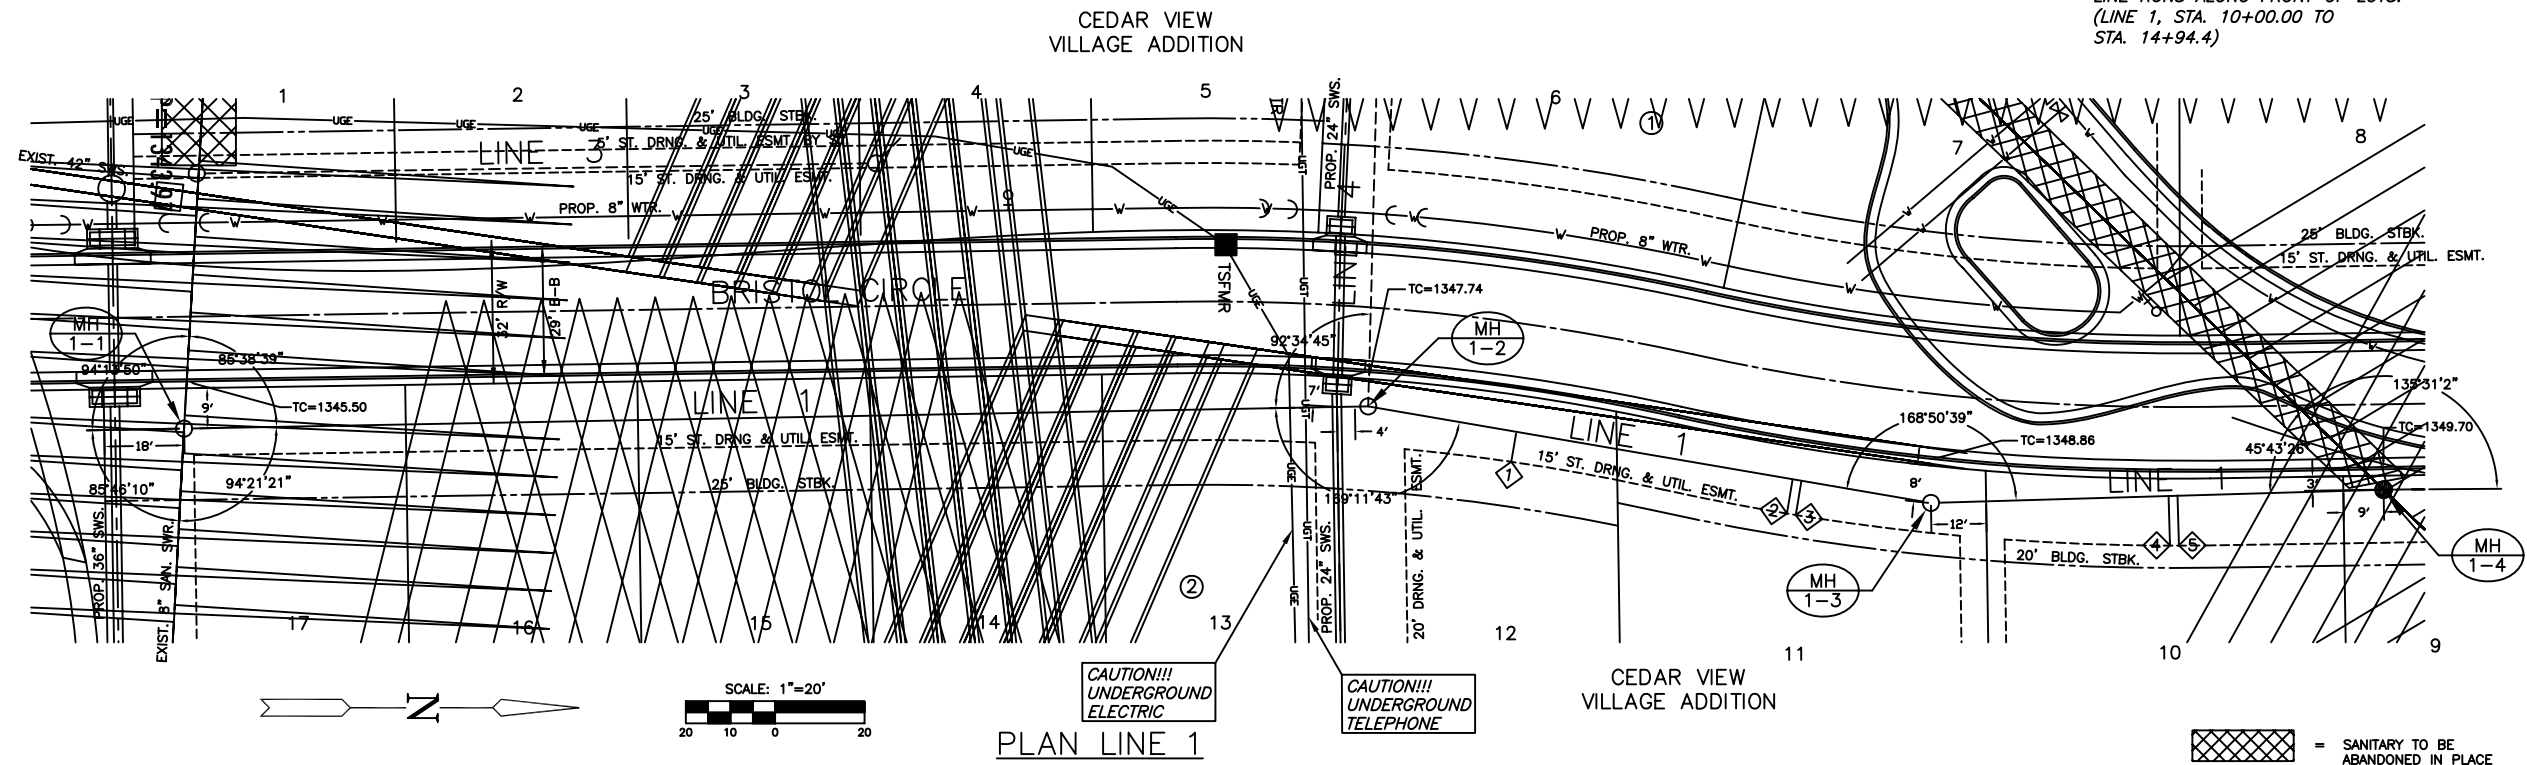

PLAN LINE 1

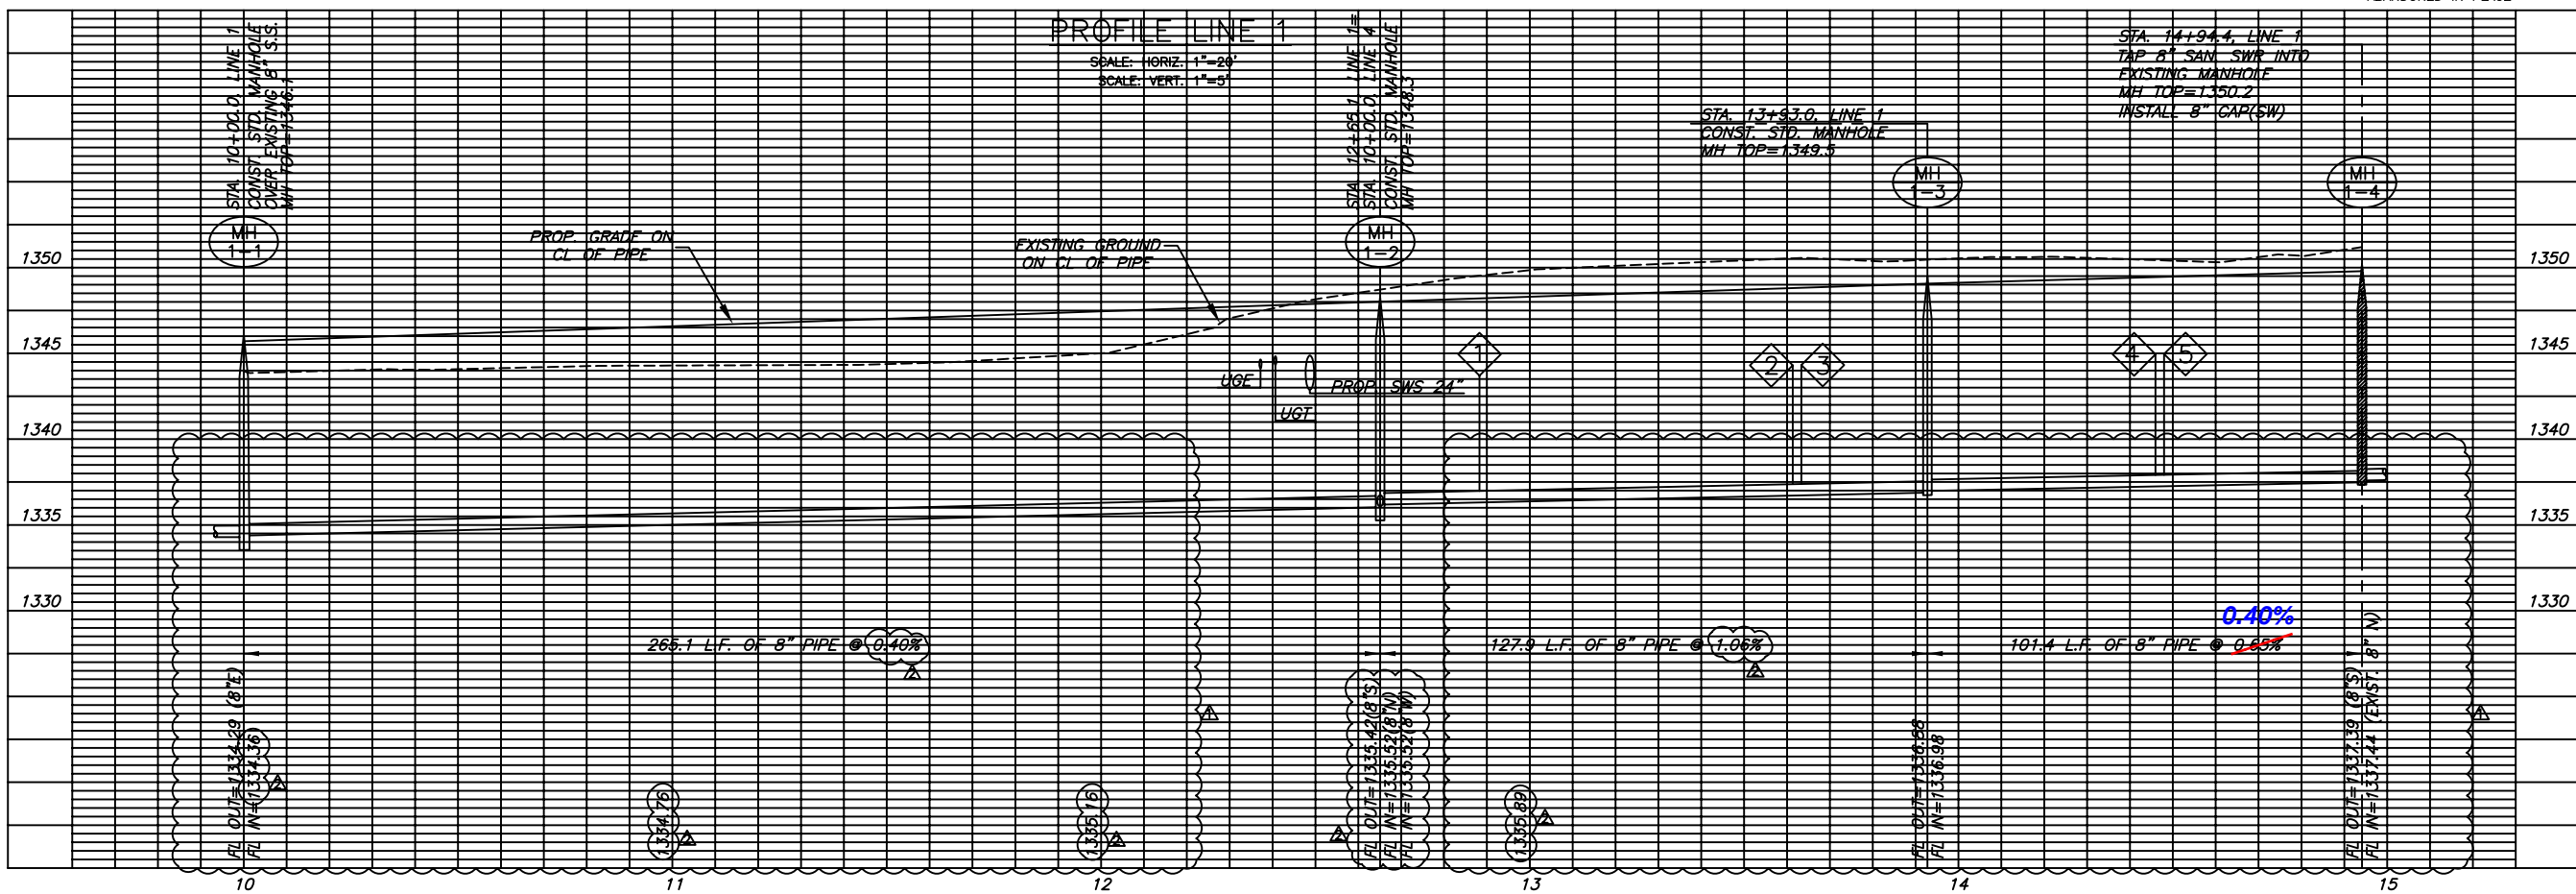

PROFILE LINE 1

LINE 1

SHEET TITLE

06189

PROJECT NUMBER

DESIGN BY

SRS

DRAWN BY

TKL

CHECKED BY

MAB

ISSUED

July 2008

REVISED

9-11-08

9-19-08

SHEET NO.

4 of 16

PLOTTED: Thursday, January 15, 2009 @ 03:51PM

\\AREA\DEPTA PUBLIC WORKS\ENGINEERING\3 CURRENT PROJECTS\468-94482 744281 LAT 408
FILE: 06189 SAN SEWER PLAN VILLAGE PHASE 1.DWG