


SANITARY SEWER PLANS
CEDAR VIEW VILLAGE
PHASE 1

TRENCHES TO BE BACKFILLED WITH SAND AND FLUSHED WHEN SEWER LINE RUNS ALONG FRONT OF LOTS. (LINE 1, STA. 10+00.00 TO STA. 14+94.4)

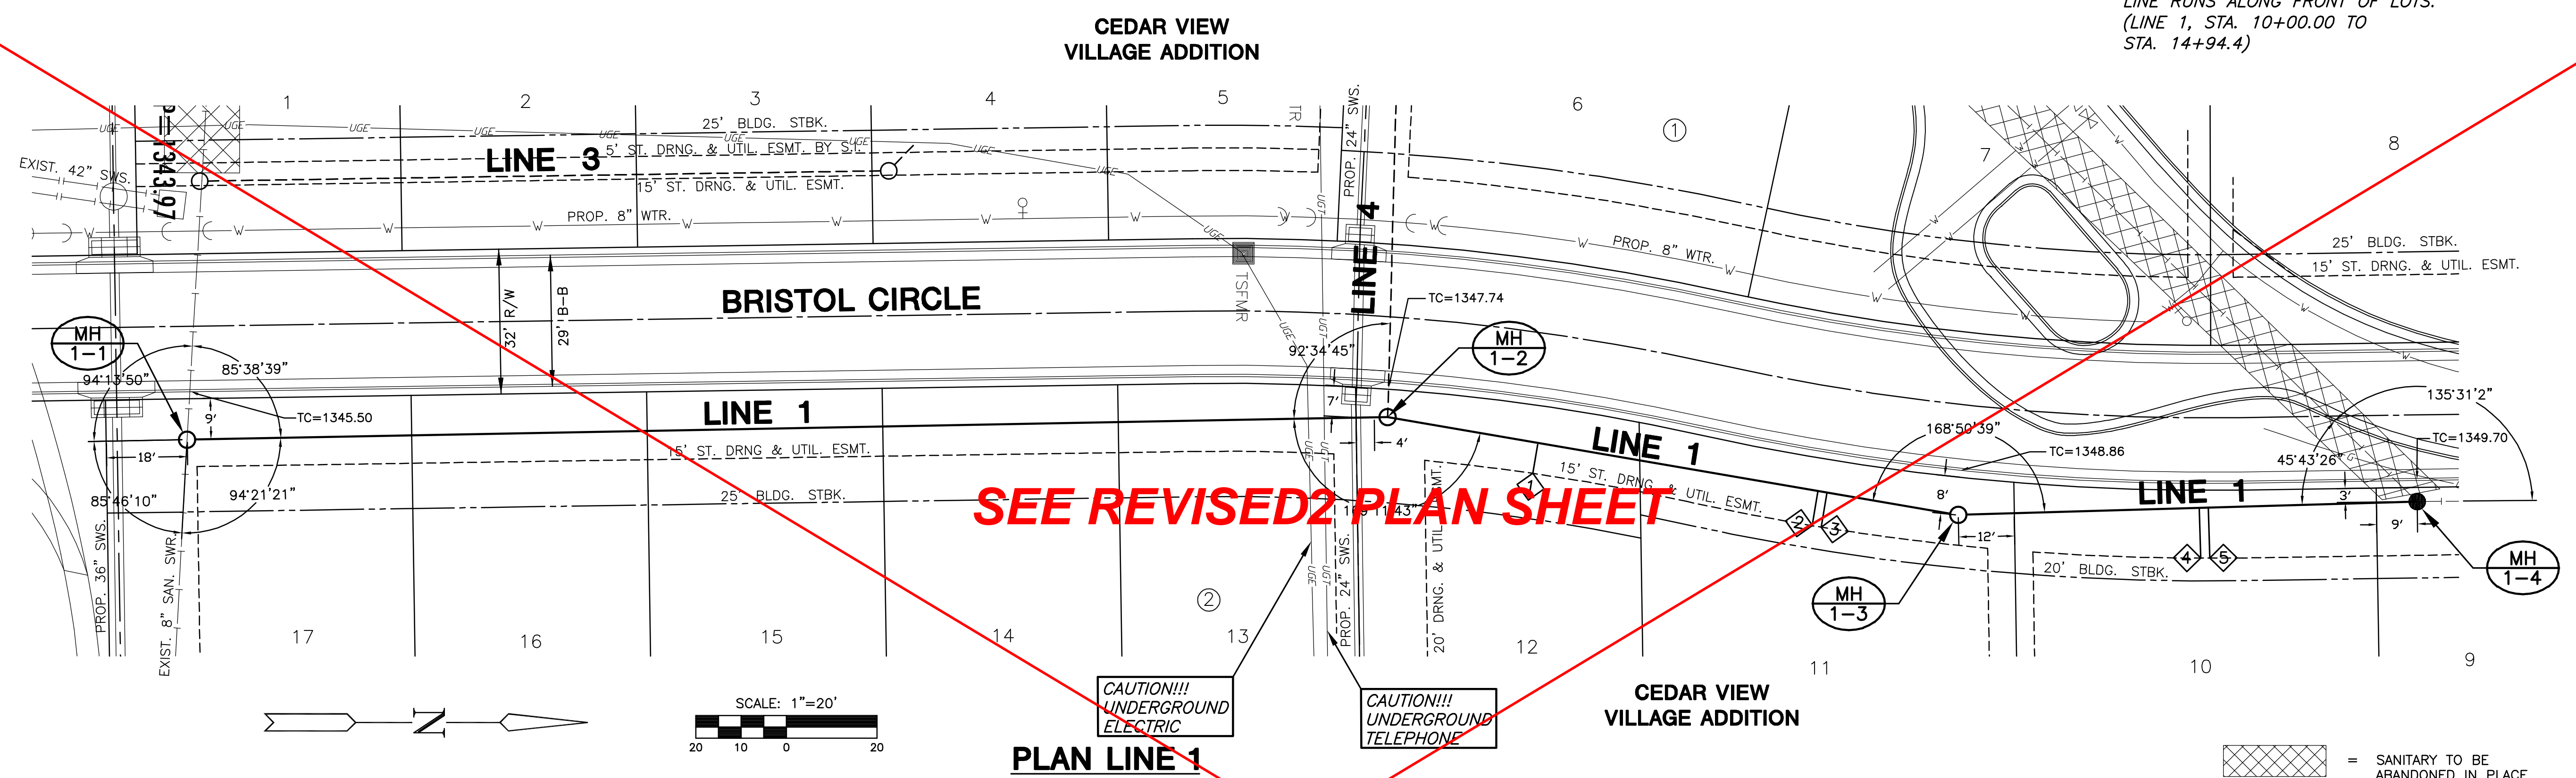


SEE REVISED 2 PLAN SHEET

CAUTION!!! UNDERGROUND ELECTRIC
CAUTION!!! UNDERGROUND TELEPHONE

PLAN LINE 1

[Cross-hatched symbol] = SANITARY TO BE ABANDONED IN PLACE

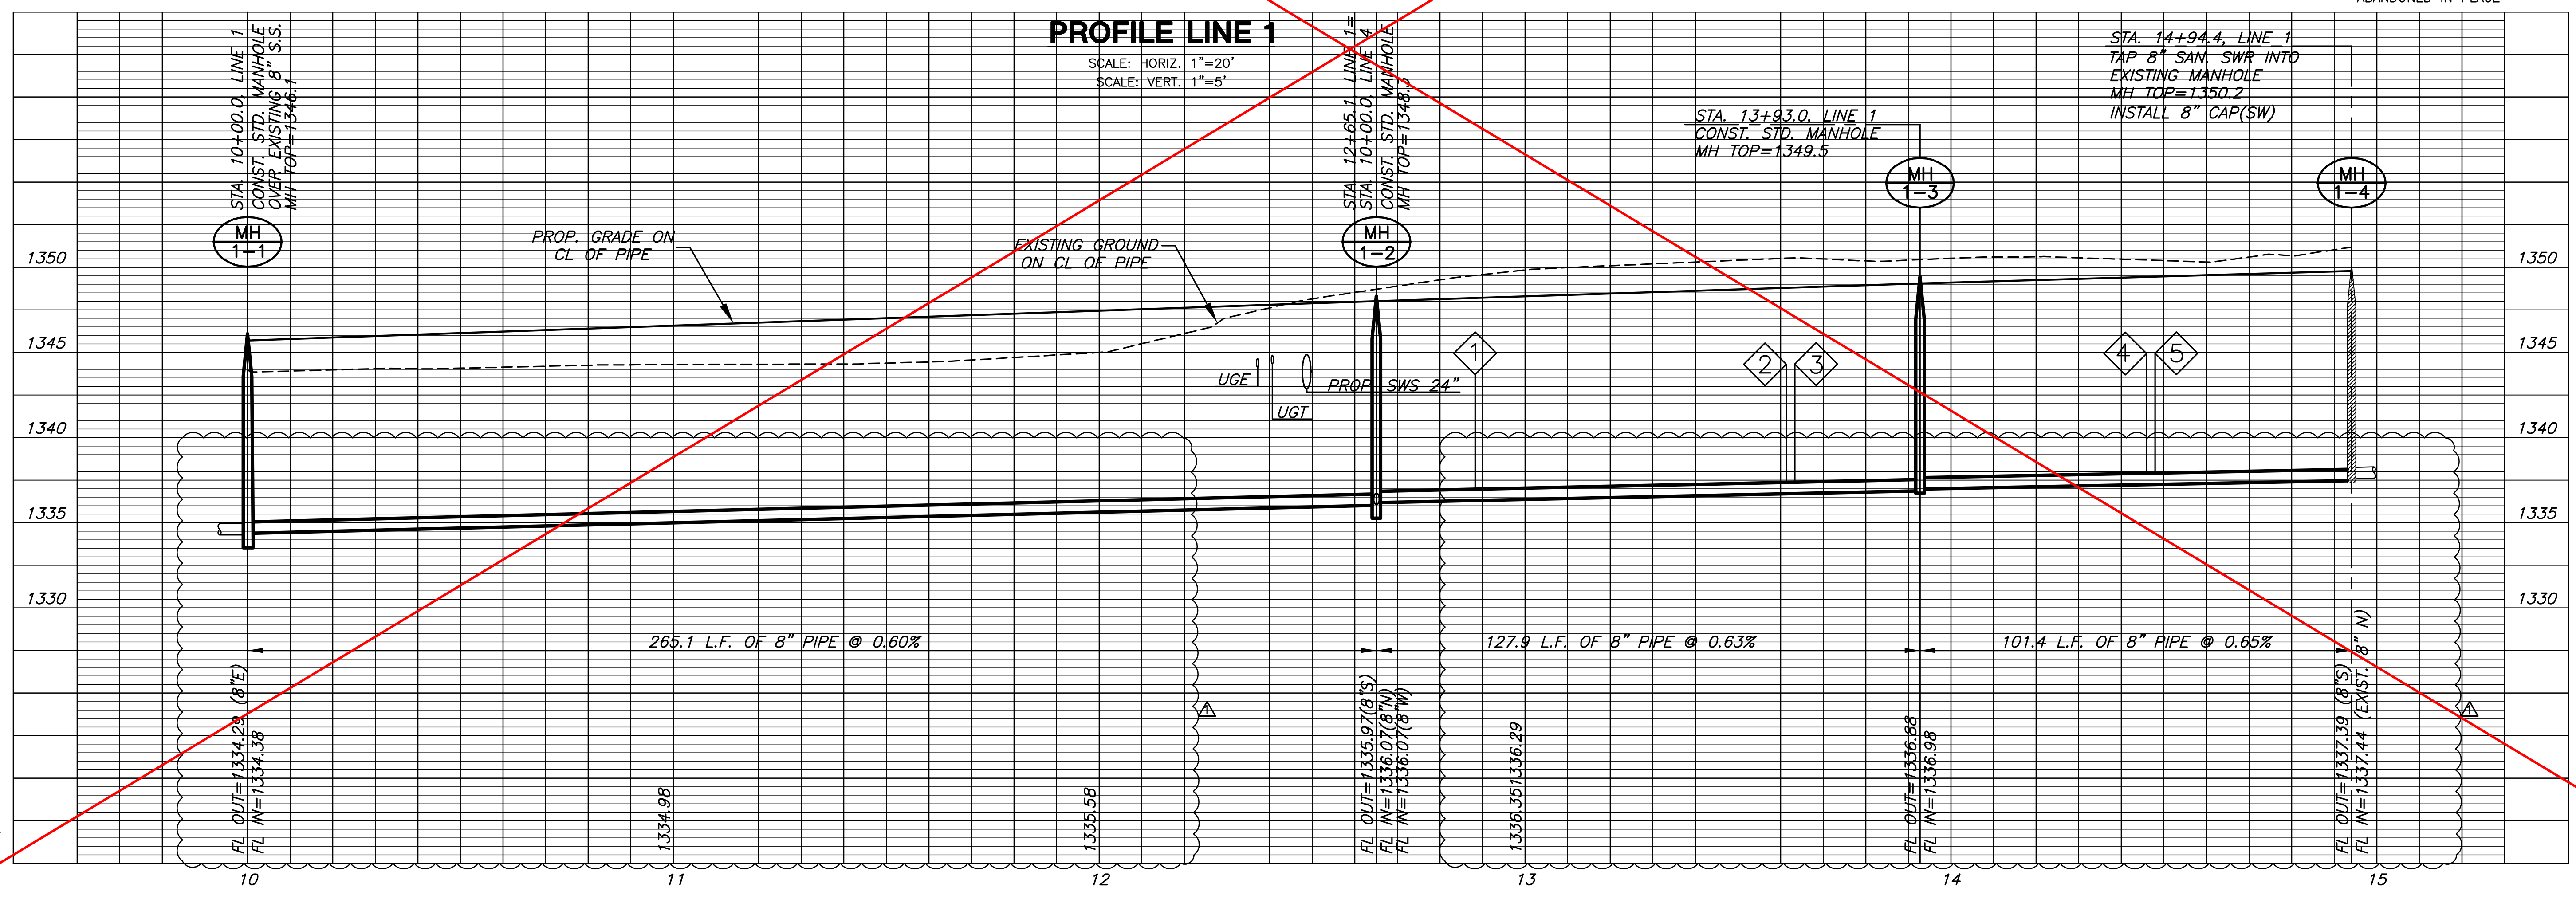

PROFILE LINE 1

SCALE: HORIZ. 1"=20'
SCALE: VERT. 1"=5'

STA. 14+94.4, LINE 1
TAP 8" SAN. SWR INTO EXISTING MANHOLE
MH TOP=1350.2
INSTALL 8" CAP(SW)

STA. 13+93.0, LINE 1
CONST. STD. MANHOLE
MH TOP=1349.5

STA. 10+00.0, LINE 1
CONST. STD. MANHOLE OVER EXISTING 8" S.S.
MH TOP=1346.1

STA. 12+65.1, LINE 1
STA. 10+00.0, LINE 1
CONST. STD. MANHOLE
MH TOP=1348.3

PLOTTED: Tuesday, September 16, 2008 @ 08:26AM

J:\CIVIL\06189\WORK\SAN\06189_B1.DWG

LINE 1
SHEET TITLE
06189
PROJECT NUMBER

SRS
DESIGN BY
TKL
DRAWN BY
MAB
CHECKED BY

ISSUED July 2008
REVISED 9-11-08

SHEET NO.
4 of 16