



SANITARY SEWER PLANS  
**CEDAR VIEW VILLAGE**  
PHASE 1

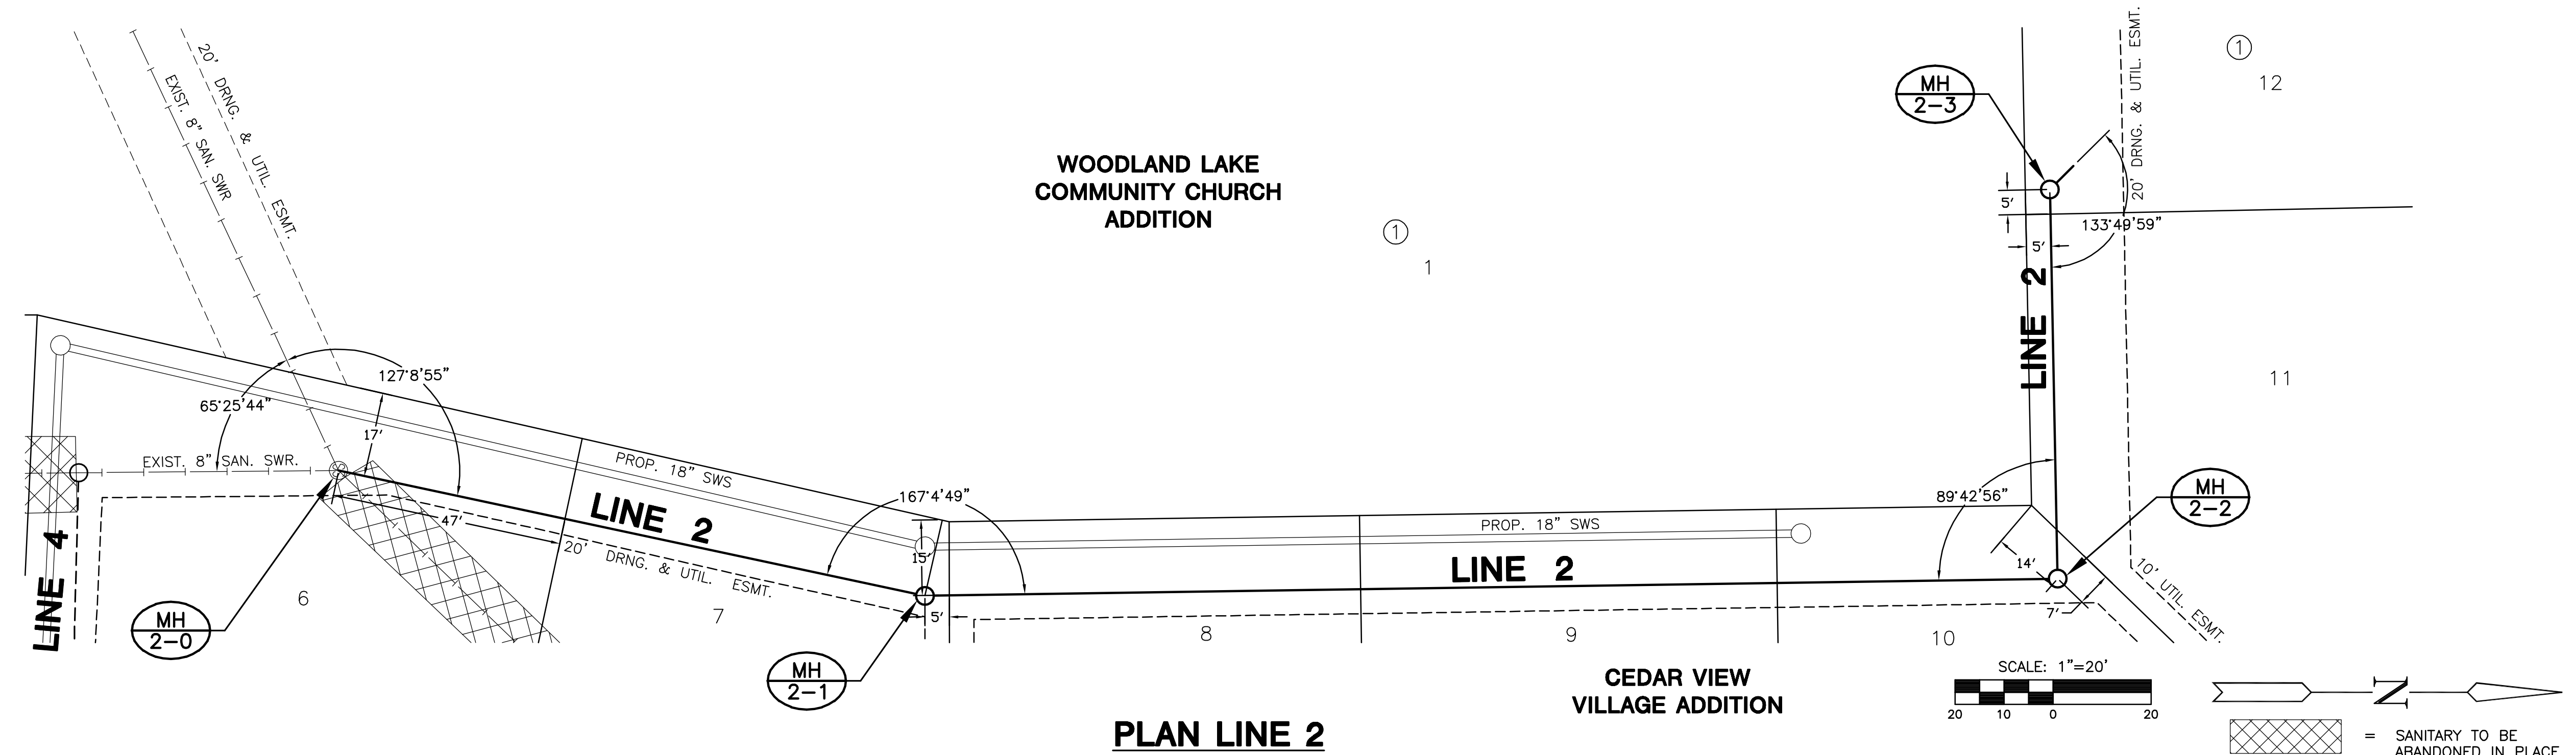

**PLAN LINE 2**  
SCALE: HORIZ. 1"=20'  
SCALE: VERT. 1"=5'

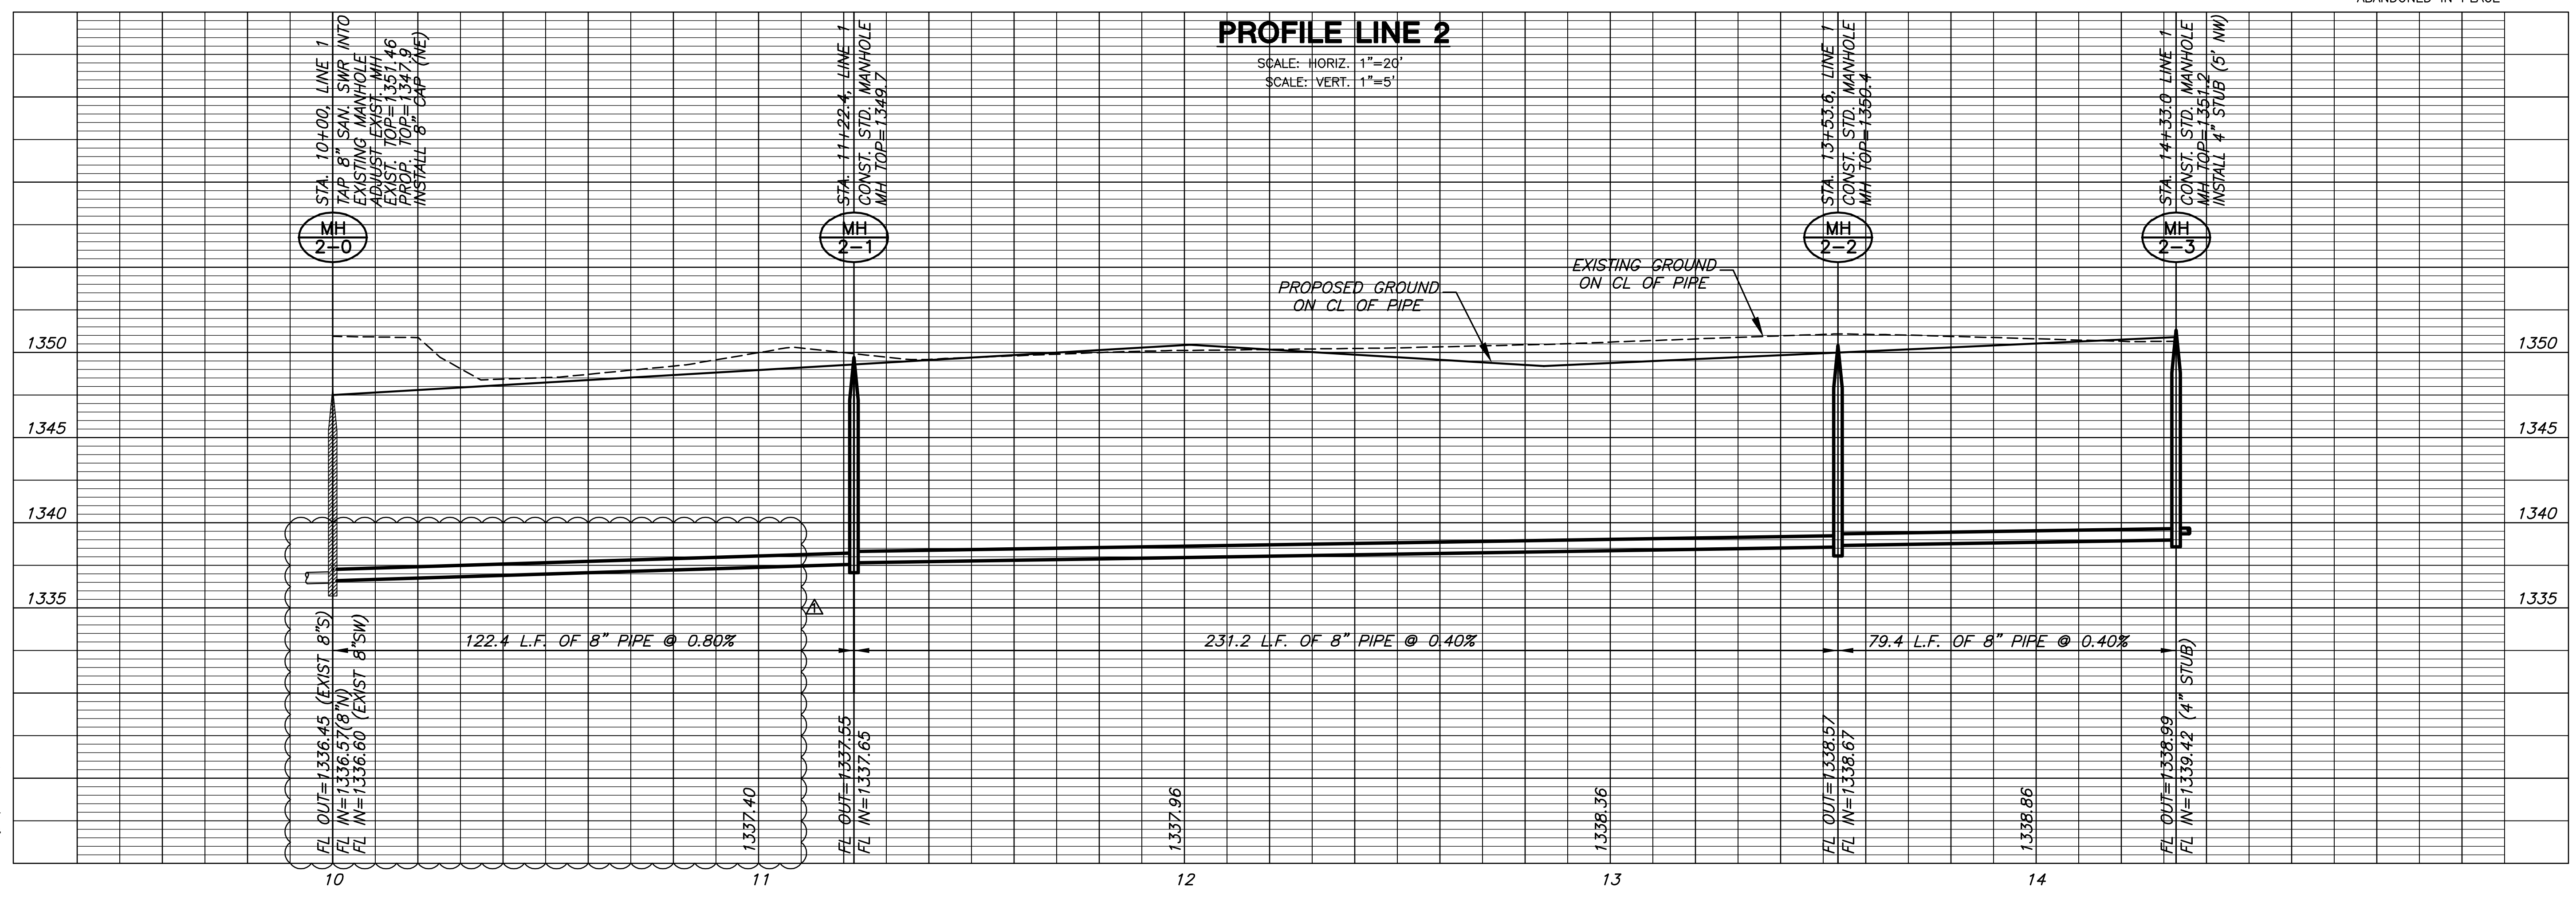

**PROFILE LINE 2**  
SCALE: HORIZ. 1"=20'  
SCALE: VERT. 1"=5'

PLOTED: Tuesday, September 16, 2008 @ 08:26AM

J:\CIVIL\06189\LVW\SAN\SAN\06189\_02.DWG

**LINE 2**  
SHEET TITLE  
06189  
PROJECT NUMBER

SRS  
DESIGN BY  
TKL  
DRAWN BY  
MAB  
CHECKED BY

ISSUED  
July 2008  
REVISED  
9-11-08

SHEET NO.  
5 of 16