



TRENCHES TO BE BACKFILLED WITH SAND AND FLUSHED WHEN SEWER LINE RUNS ALONG FRONT OF LOTS. (LINE 3, STA. 10+00.00 TO STA. 11+52.1)

CEDAR VIEW VILLAGE ADDITION

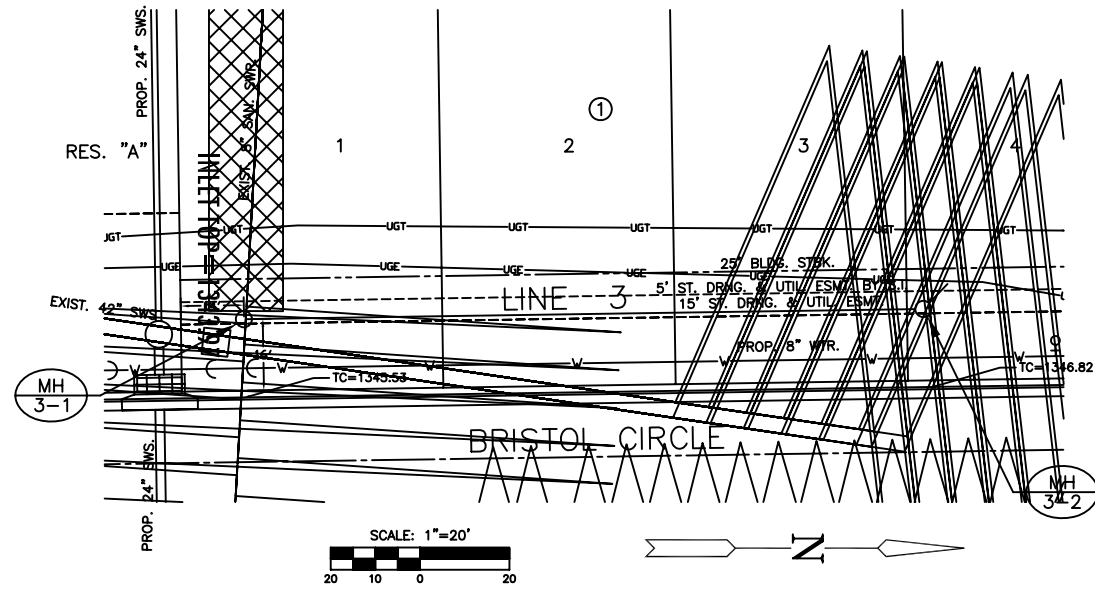

CEDAR VIEW VILLAGE ADDITION

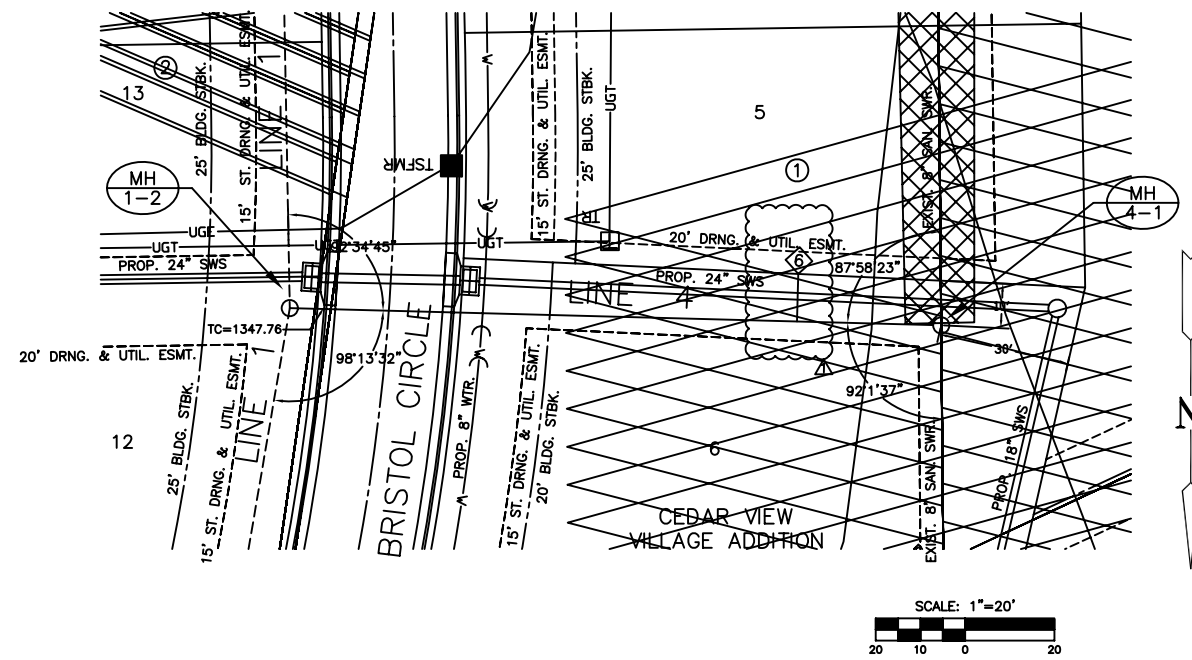


PLAN LINE 3

PLAN LINE 4

= SANITARY TO BE ABANDONED IN PLACE

PROFILE LINE 3

PROFILE LINE 4

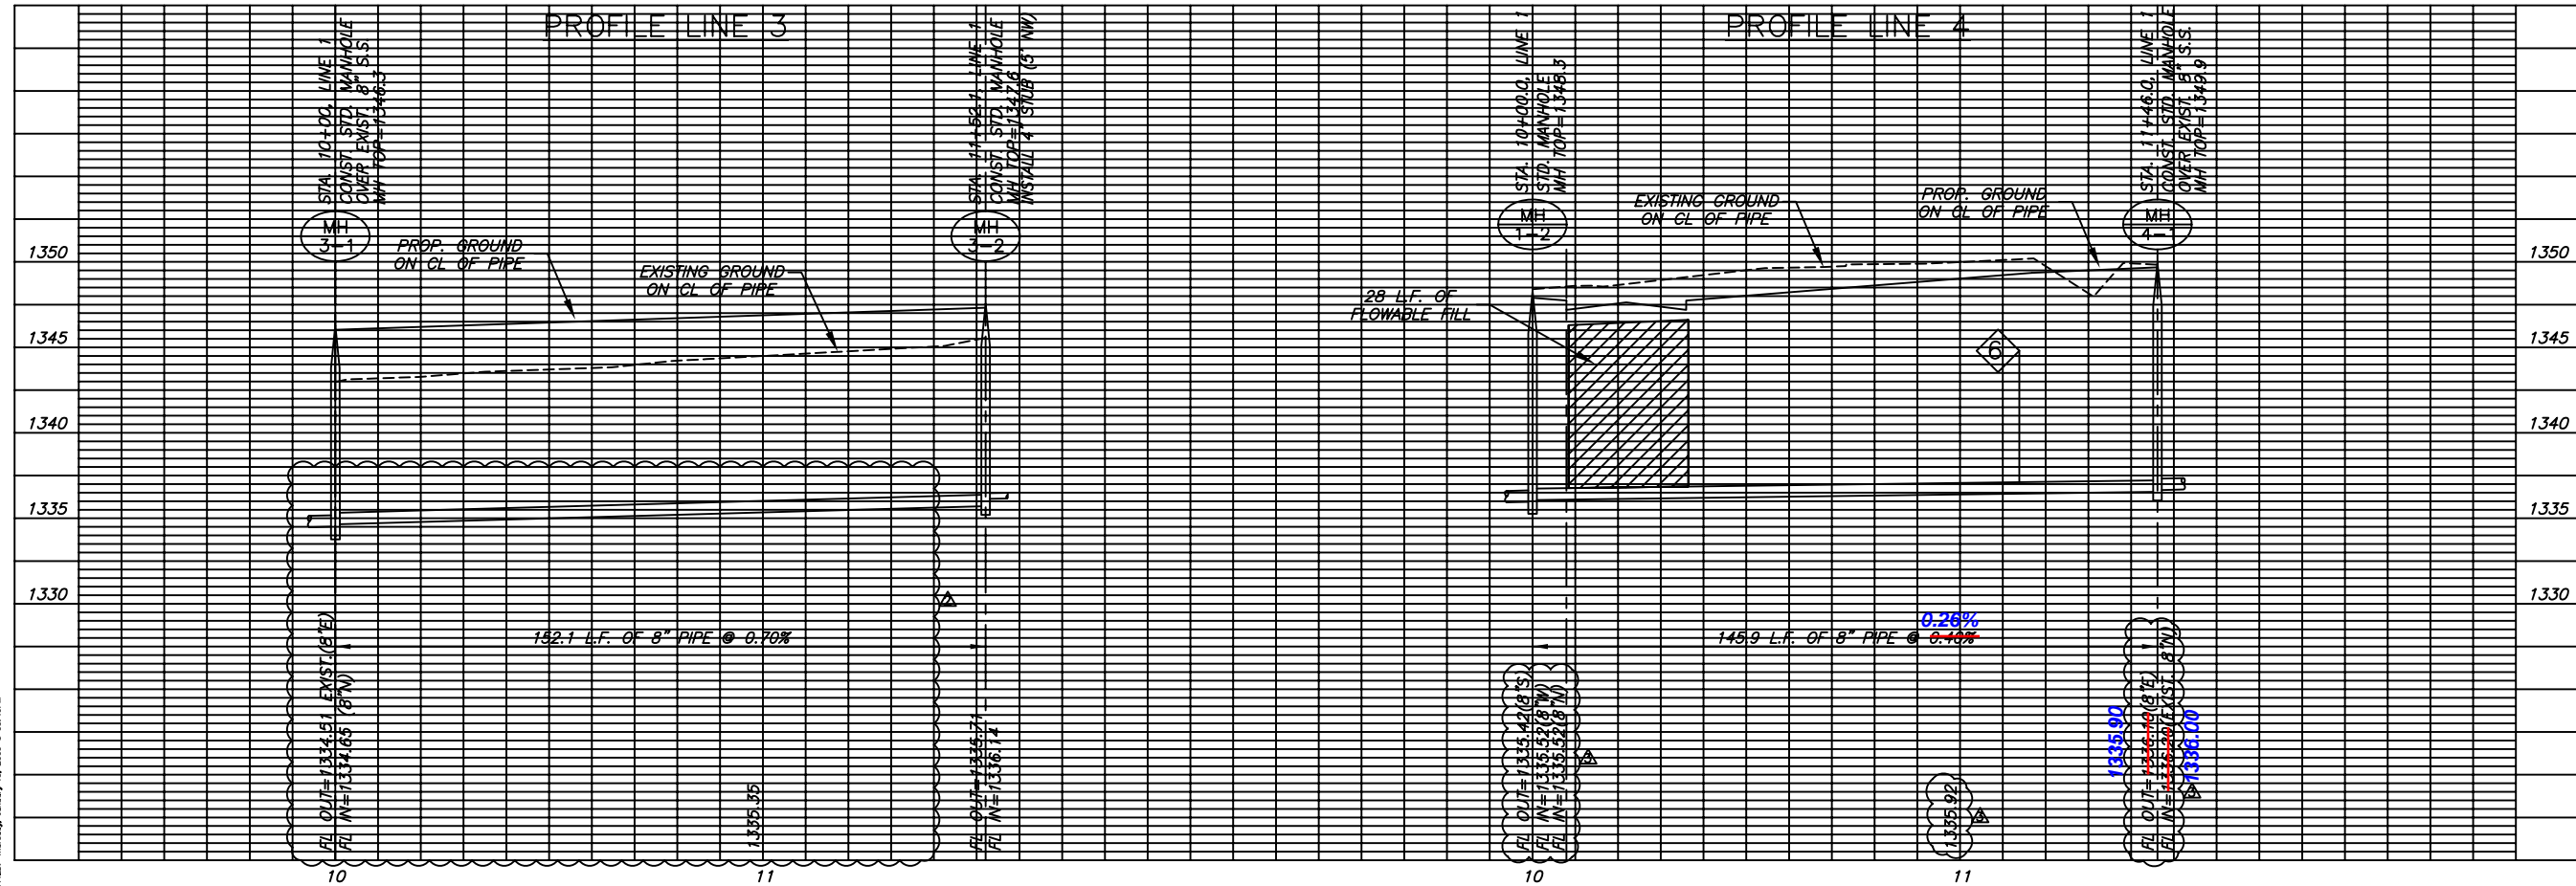

PLOTTER: Thursday, January 15, 2008 @ 03:49PM

\\VREP1\DEPT\PUBLIC WORKS\ENGINEERING\3. CURRENT PROJECTS\460-84482-744281 LAT 408 - PLAN - CEDAR VIEW - SANITARY - 080808.dwg

LINES 3 & 4

SHEET TITLE  
06189

PROJECT NUMBER

DESIGN BY  
SRS

DRAWN BY  
TKL

CHECKED BY  
MAB

ISSUED  
July 2008

REVISED  
7-30-08

9-11-08

9-19-08

SHEET NO.

6 of 16