
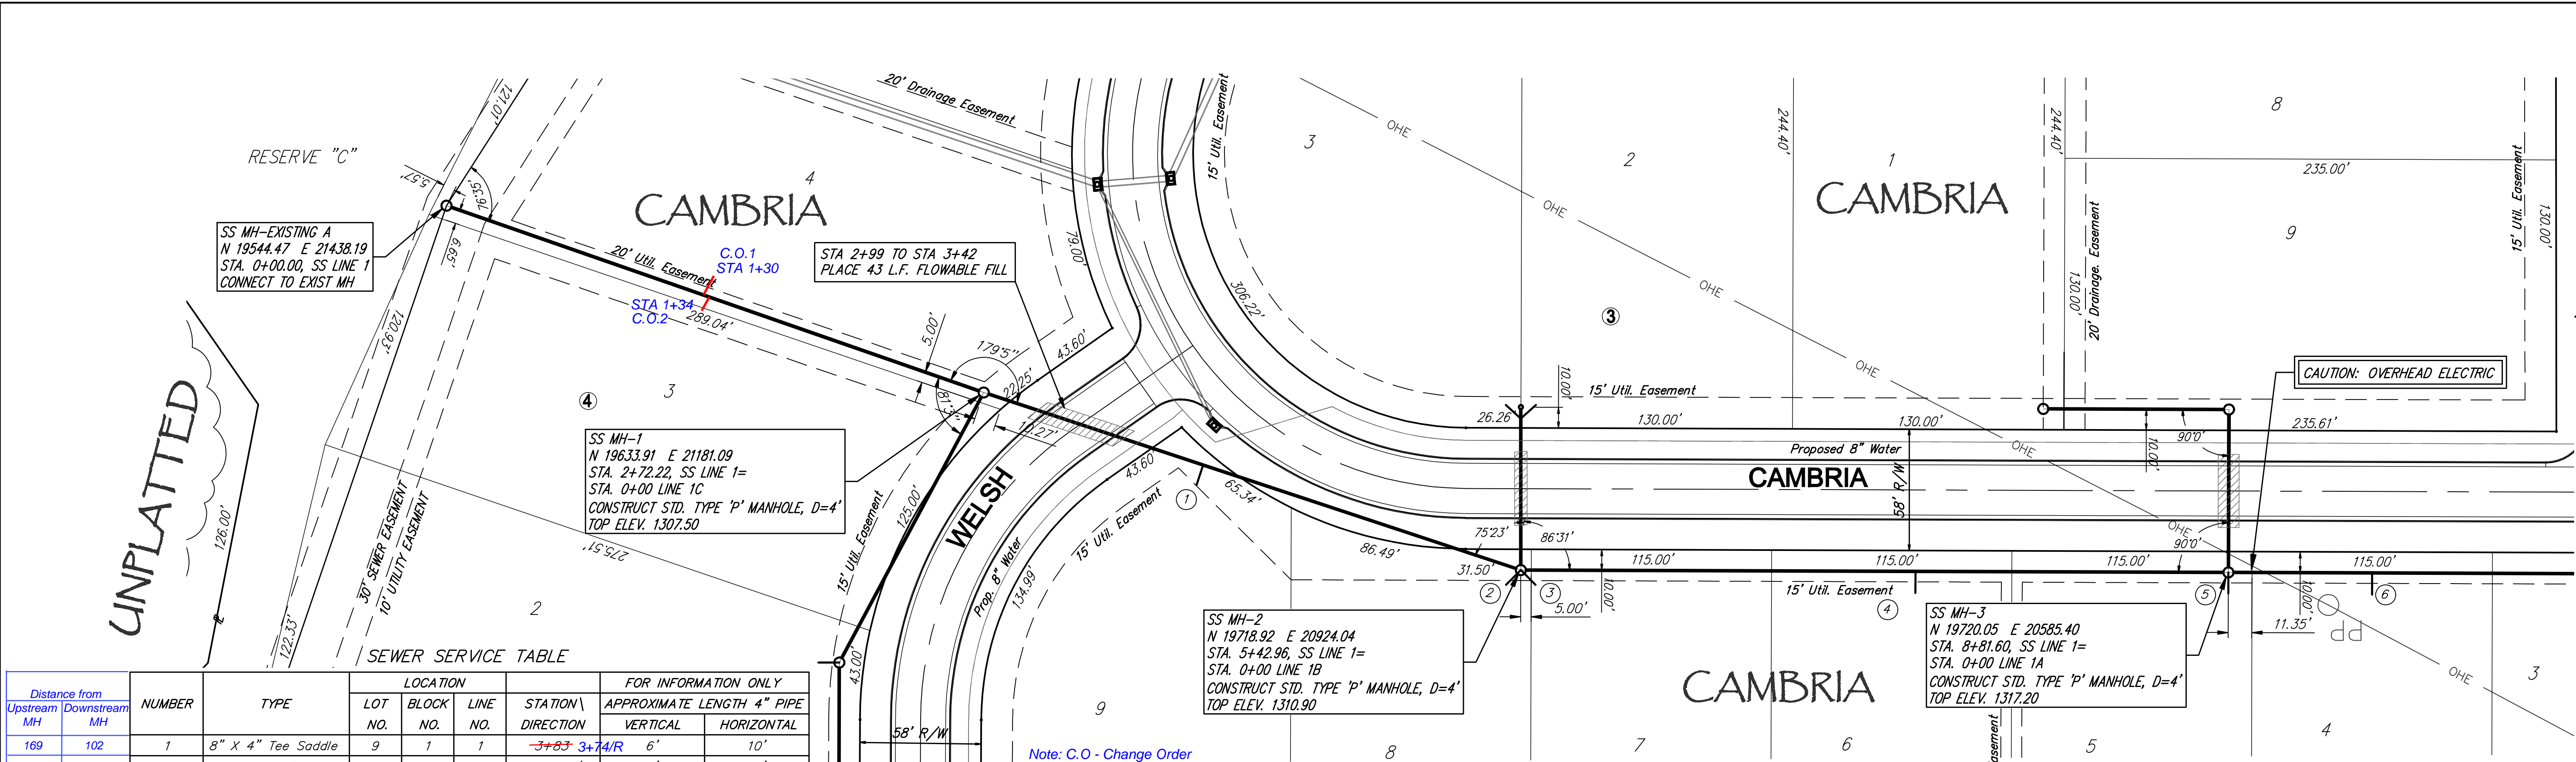


UNPLATTED

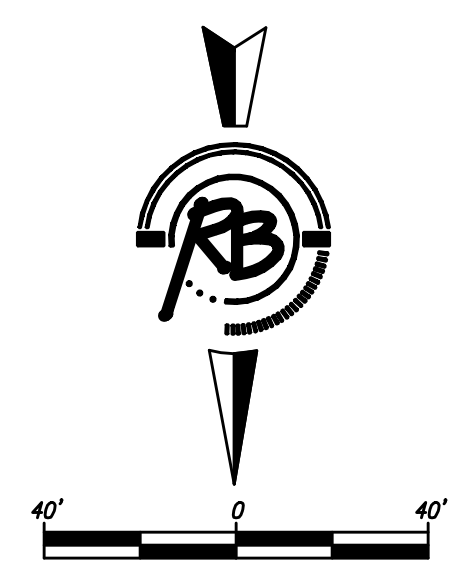

SEWER SERVICE TABLE


Distance from Upstream MH	Distance from Downstream MH	NUMBER	TYPE	LOCATION			FOR INFORMATION ONLY		
				LOT NO.	BLOCK NO.	LINE NO.	STATION \ DIRECTION	APPROXIMATE LENGTH 4" PIPE	VERTICAL
169	102	1	8" X 4" Tee Saddle	9	1	1	3+83 3+74/R	6'	10'
-	-	2	Manhole Stub	8	1	1	5+42.96/L/R	8'	10'
-	-	3	Manhole Stub	7	1	1	5+42.96/L/R	8'	10'
152	187	4	8" X 4" Tee Saddle	6	1	1	7+32 7+30/R	8'	10'
-	-	5	Manhole Stub	5	1	1	8+81.60/R	8'	10'
292	70	6	8" X 4" Tee Saddle	4	1	1	3+83 9+51/R	6'	10'

NUMBER	LOCATION			STATION	DISTANCE FROM MAIN TO RISER (L/R)	Distance from	
	LOT NO.	BLK NO.	LINE NO.			Upstream MH	Downstream MH
C.O. 1	4	4	1	1+30/L	10'	142	130
C.O. 2	3	4	1	1+34/R	10'	146	126

Note: C.O. - Change Order

SEWER TO BE BACKFILLED WITH SAND AND FLUSHED AND VIBRATED PER CTY OF WICHITA STANDARD SPECIFICATIONS FROM STA. 3+42 TO STA. 8+82 LINE 1. SUITABILITY OF EXCAVATED SAND FOR USE AS BACKFILL WILL BE DETERMINED BY THE ENGINEER.

NOTE: Vertical Riser Pipe shall be extended to 2' minimum above ground water elevation and 4' maximum below proposed ground elevation.

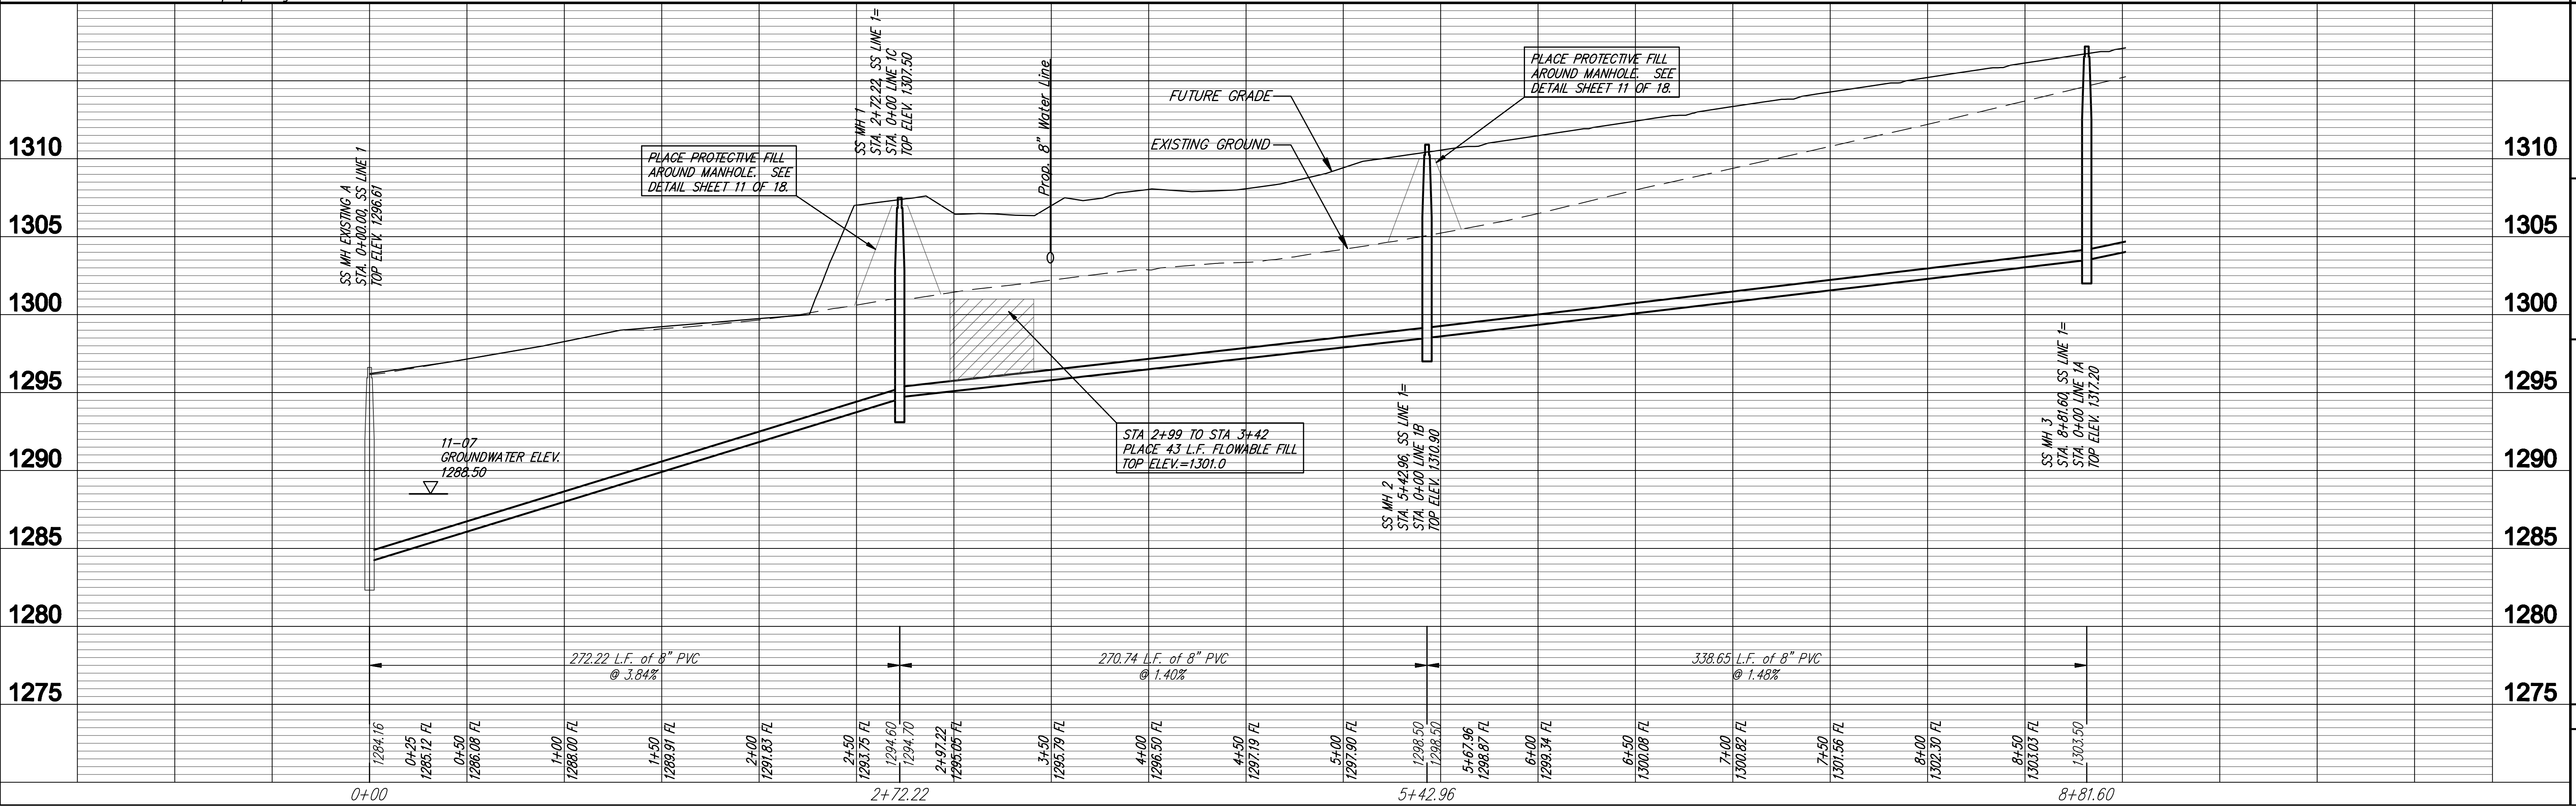


PROJECT NUMBER: 468-84480  
 DRAWING TITLE: Sanitary Plan 02 Line 1  
 DATE: Jan. 23, 2008  
 E.J.B.  
 A.M.L.  
 U.M.T.

**CAMBRIA ADDITION  
 SANITARY SEWER  
 WICHITA, KANSAS**

18