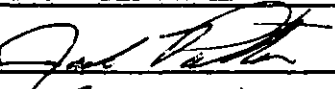


ENGINEERING DEPARTMENT

CITY OF WICHITA

MISCELLANEOUS INFORMATION

Signed

Contractor *WB CARTER*

Date

Project

Storm Water #630 COLE'S ADDITION

Project Number

*468-84335 751446**M/H SAT 3 PLANS SHOW AT STA 2+50 / ACTUAL STA 2+52**RIED INLET SAT 5 PLANS SHOW AT STA 12+92 / ACTUAL STA 12+95*