


**GRADING AND DRAINAGE PLANS**  
**FOX RIDGE ADDITION**  
**LAKES PHASE 2C-3**

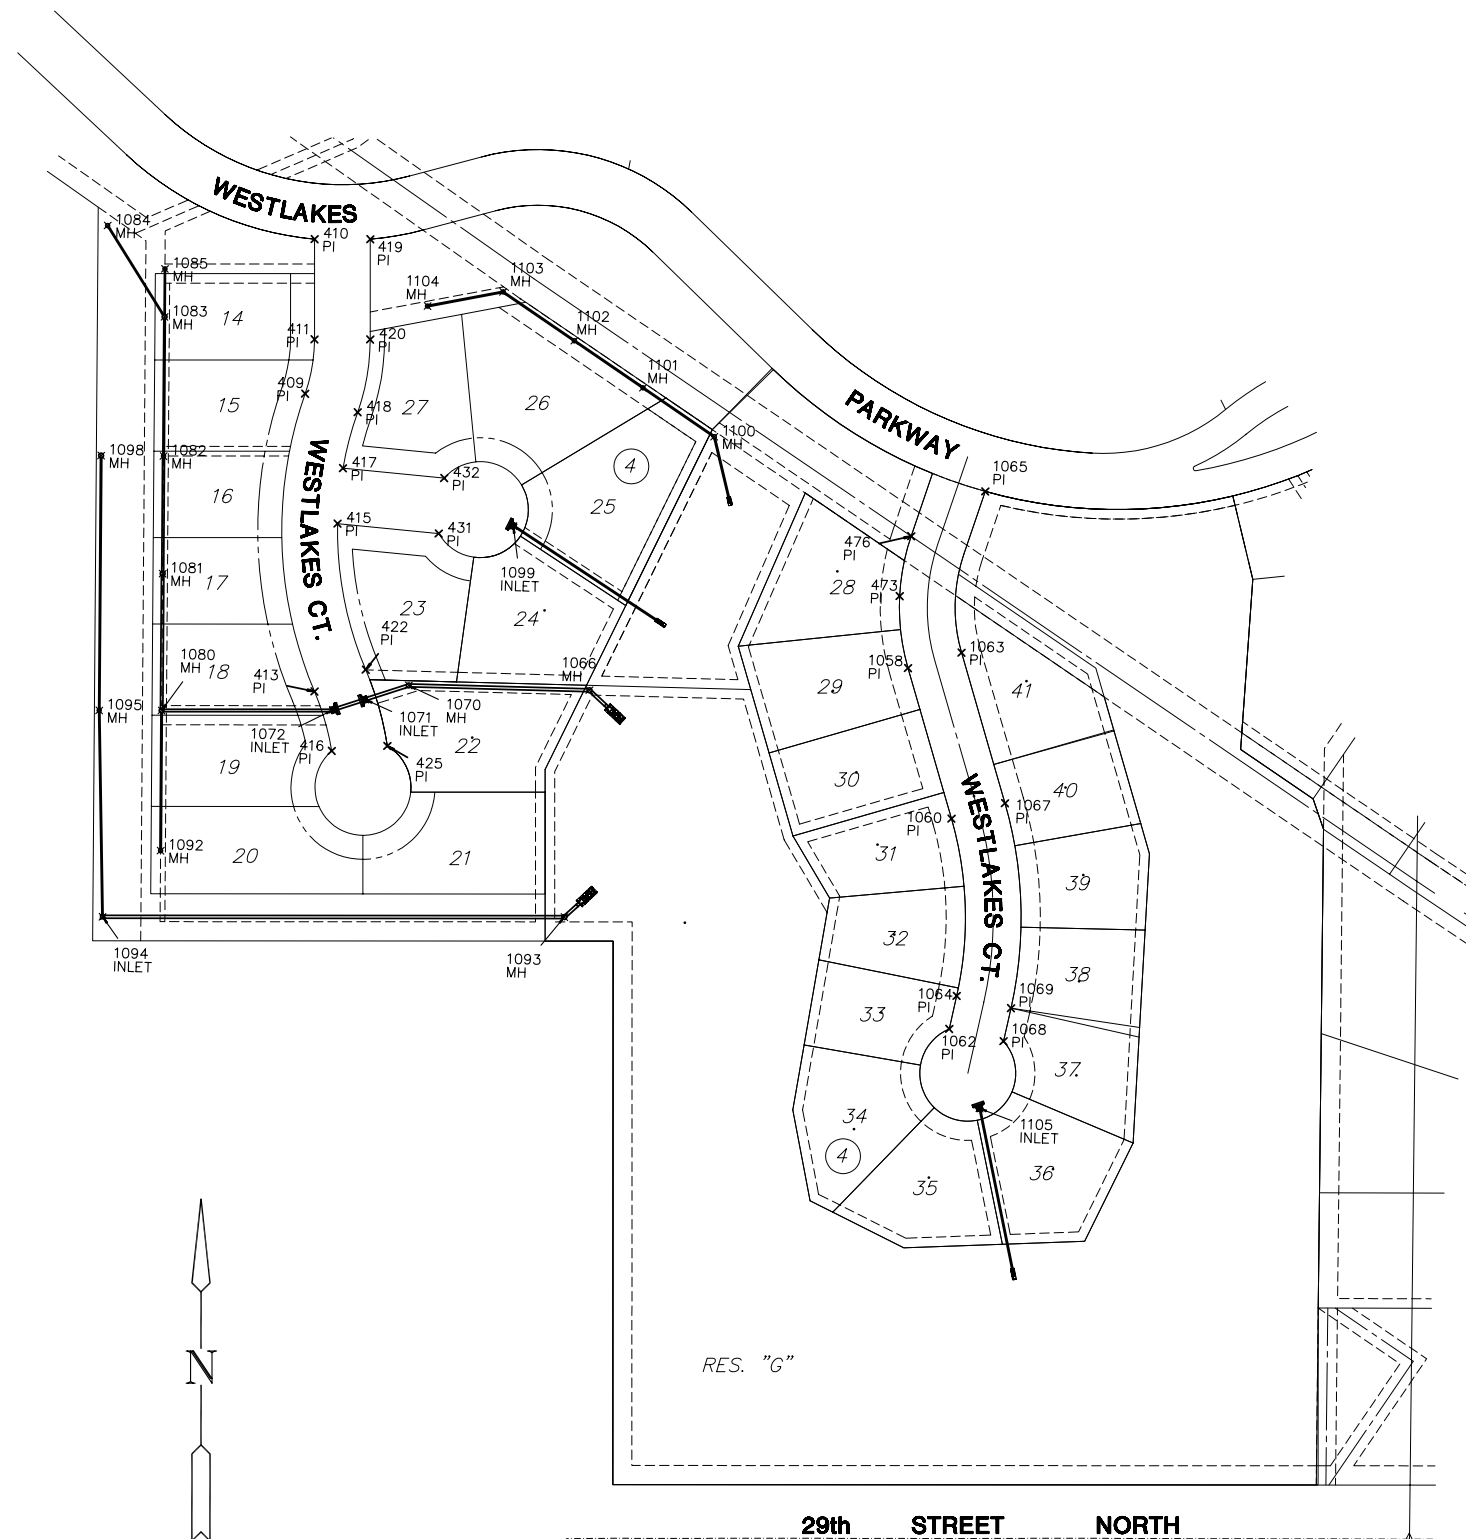

PLAT IRONS			
Point #	Northing	Easting	Desc.
409	1705254.86	1613926.15	PI
410	1705416.11	1613930.82	PI
411	1705311.74	1613934.04	PI
413	1704945.22	1613945.80	PI
415	1705120.74	1613964.17	PI
416	1704883.96	1613965.72	PI
417	1705178.62	1613967.98	PI
418	1705237.35	1613981.44	PI
419	1705417.89	1613988.80	PI
420	1705313.52	1613992.01	PI
422	1704969.57	1613998.44	PI
425	1704890.93	1614023.43	PI
431	1705113.78	1614069.87	PI
432	1705171.66	1614073.68	PI
473	1705064.00	1614551.78	PI
476	1705126.78	1614561.73	PI
1058	1704989.37	1614562.87	PI
1060	1704834.11	1614613.13	PI
1062	1704615.11	1614617.81	PI
1063	1705007.23	1614618.05	PI
1064	1704649.75	1614624.47	PI
1065	1705175.87	1614637.37	PI
1067	1704851.98	1614668.31	PI
1068	1704604.15	1614674.76	PI
1069	1704638.79	1614681.43	PI

STORM SEWER POINTS			
Point #	Northing	Easting	Desc.
1066	1704955.73	1614232.02	MH
1070	1704954.64	1614043.64	MH
1071	1704938.60	1613998.89	INLET
1072	1704926.68	1613965.63	INLET
1080	1704920.32	1613787.31	MH
1081	1705062.81	1613783.80	MH
1082	1705185.21	1613780.79	MH
1083	1705330.20	1613777.22	MH
1084	1705423.37	1613714.91	MH
1085	1705380.15	1613776.00	MH
1092	1704774.36	1613790.90	MH
1093	1704718.75	1614213.45	MH
1094	1704703.55	1613732.62	INLET
1095	1704918.33	1613722.34	MH
1098	1705183.68	1613715.81	MH
1099	1705124.20	1614147.22	INLET
1100	1705223.84	1614353.47	MH
1101	1705272.32	1614277.64	MH
1102	1705319.01	1614204.59	MH
1103	1705367.49	1614128.76	MH
1104	1705350.22	1614050.65	MH
1105	1704533.38	1614652.02	INLET

**BUBBLE MAP**

SHEET TITLE  
**468-84151**  
PROJECT NUMBER

DESIGN BY DFL  
DRAWN BY KKL  
CHECKED BY GJA

ISSUED March 2007  
REVISED

SHEET NO.  
**15 of 26**