THE CORNERSTONE FIRST ADD.
WATER MAIN EXTENSION
LINE 2

2" Blow Off Valve Located:
- 4.5' N and 7.5 E of Back of the End of Curb

STA. 1+67.28, LINE 2=
ST. STA. 11+02.66, 27' RT.
1-2" BLOWOFF ASSY.

62.94' OF 8" PIPE

STA. 1+04.34, LINE 2=
ST. STA. 10+39.72, 27' RT.
1-8" DIMJ 11.25° BEND

4.34' OF 8" DICL PIPE

THE CORNERSTONE ADDITION

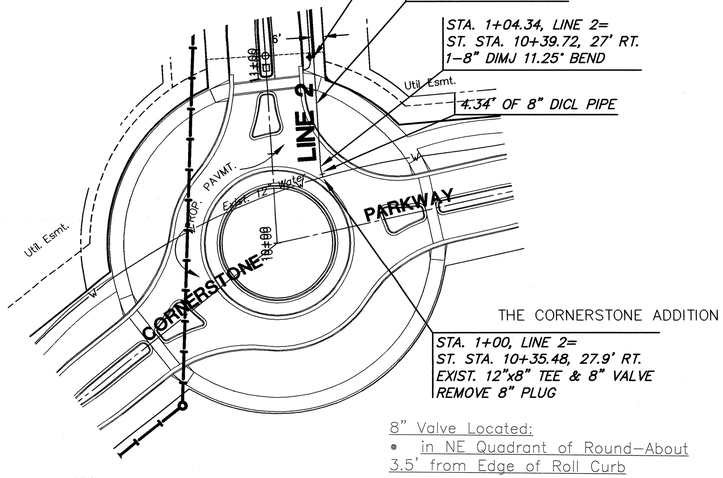

THE CORNERSTONE ADDITION

STA. 1+00, LINE 2=
ST. STA. 10+35.48, 27.9' RT.
EXIST. 12"x8" TEE & 8" VALVE
REMOVE 8" PLUG

8" Valve Located:
- in NE Quadrant of Round-About 3.5' from Edge of Roll Curb

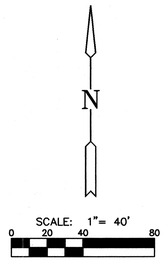

RECORD DRAWING
M.T. 1-12-09

PROFILE WATER LINE 2

SCALE: HORIZ. 1"=40'
SCALE: VERT. 1"=5'

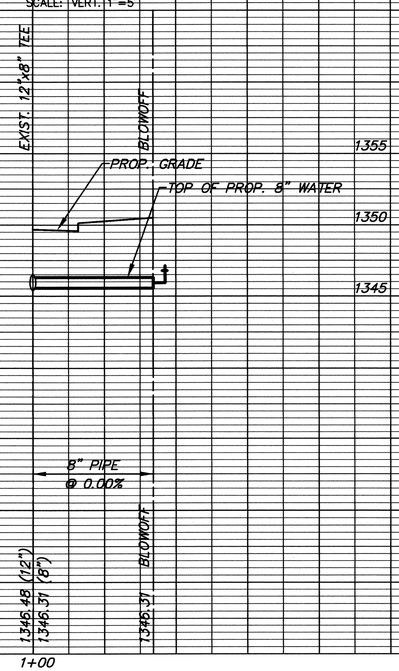

4A
2/2

J:\CIVIL\04294\DWG\PAV\PHASE1\04294_C2